

STATE OF ALASKA
 DEPARTMENT OF TRANSPORTATION
 AND
 PUBLIC FACILITIES
 SOUTHEASTERN REGION
 DESIGN AND CONSTRUCTION DIVISION

**CRAIG
 SEAPLANE BASE
 EXPANSION**


CRAIG ALASKA

**PROJECT No. 69956
 A.I.P. # 3-02-0071-01**

INDEX OF SHEETS

SHEET NO.	DESCRIPTION
1	TITLE SHEET
2	ESTIMATE OF QUANTITIES
INWATER WORK	
3	FLOAT LAYOUT
4-8	APPROACH PLAN AND DETAILS
9-13	GANGWAY FRAMING PLAN AND DETAILS
14-21	FLOAT PLAN SECTIONS AND DETAILS
22-27	MISCELLANEOUS DETAILS
28-29	SIGN DETAILS
30	TRAFFIC CONTROL PLAN
UPLANDS WORK	
31	DRAWING A-1 - SITE PLAN
32-40	DRAWINGS A-2 THRU A-10 - ARCHITECTURAL
41-44	DRAWINGS C-1 THRU C4 - SANITARY SEWER AND SITE CROSS SECTIONS
45-50	DRAWINGS S-1 THRU S-6 - FOUNDATION AND ROOF PLANS AND DETAILS
51-54	DRAWINGS M-1 THRU M-4 - PLUMBING AND HEATING DETAILS
55-60	DRAWINGS E-1 THRU E-6 - ELECTRICAL DRAWINGS

AL STEINSGGIZ
 465-4411

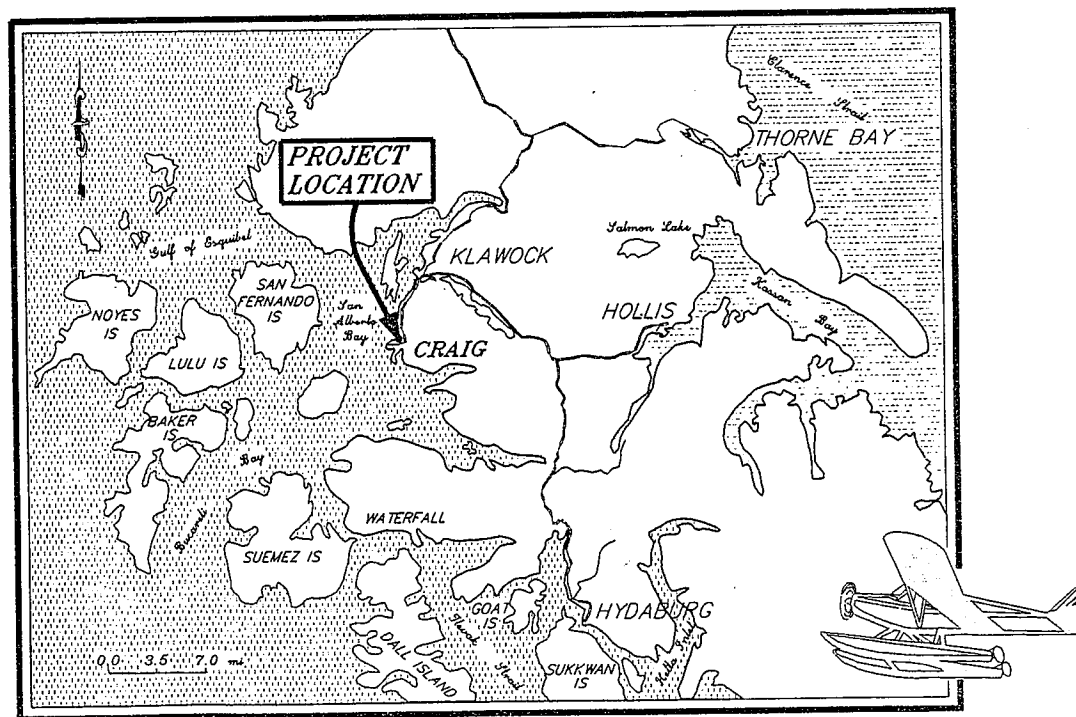

VICINITY MAP

STATE OF ALASKA
 DEPARTMENT OF TRANSPORTATION
 AND
 PUBLIC FACILITIES
 SOUTHEASTERN REGION DESIGN SECTION

APPROVED *[Signature]* Date 8/5/94
 Regional Reconstruction Engineer

APPROVED *[Signature]* Date 8/5/94
 Director, S.E. Region Design & Construction

PROJECT NUMBER: 69956	ENGINEER'S SEAL <i>[Seal]</i>
DATE: JULY 1994	
SHEET 1 OF 60	

**CRAIG SEAPLANE FACILITY
BASIS OF CONTROL**

HORIZONTAL CONTROL: The project basis of bearing for this project was the bearing of N 83°42'02" W from DOH Water St. centerline POT monument at station "L" 4+50 and the DOH centerline monument at the intersection of 3rd and Water, station "L" 0+21.18. The basis of coordinates is the DOH monument at station "L" 4+50 with project coordinates of N 20,778.567, E 38,929.747.

This bearing was derived from the tie to USLM 1429 and the record bearing between USLM 1429 and RM 6 ATS 212.

VERTICAL CONTROL: The basis of control is USC&GS BC (1953) with a accepted elevation of 10.44' above MLLW. The project basis of vertical control is the DOH monument at station "L" 4+50 with a elevation of 44.14 MLLW on top of the monument cap.


Additional project control points listed should be verified against the basis of control:

CS-5 N 21,287.930 E 39,518.459 ELEV. 14.84
CS-6 N 21,463.839 E 39,599.264 ELEV. 14.06

TIDAL DATA

EHW = 14.0
EHT = 12.8
MHHW = 10.0
MHW = 9.2
MTL = 5.3
MLLW = 0.0
ELW = -4.0

NOTE: TIMBER PILES AT THE EXISTING SEAPLANE FACILITY WERE DRIVEN BETWEEN 10' TO 16' PENETRATION.

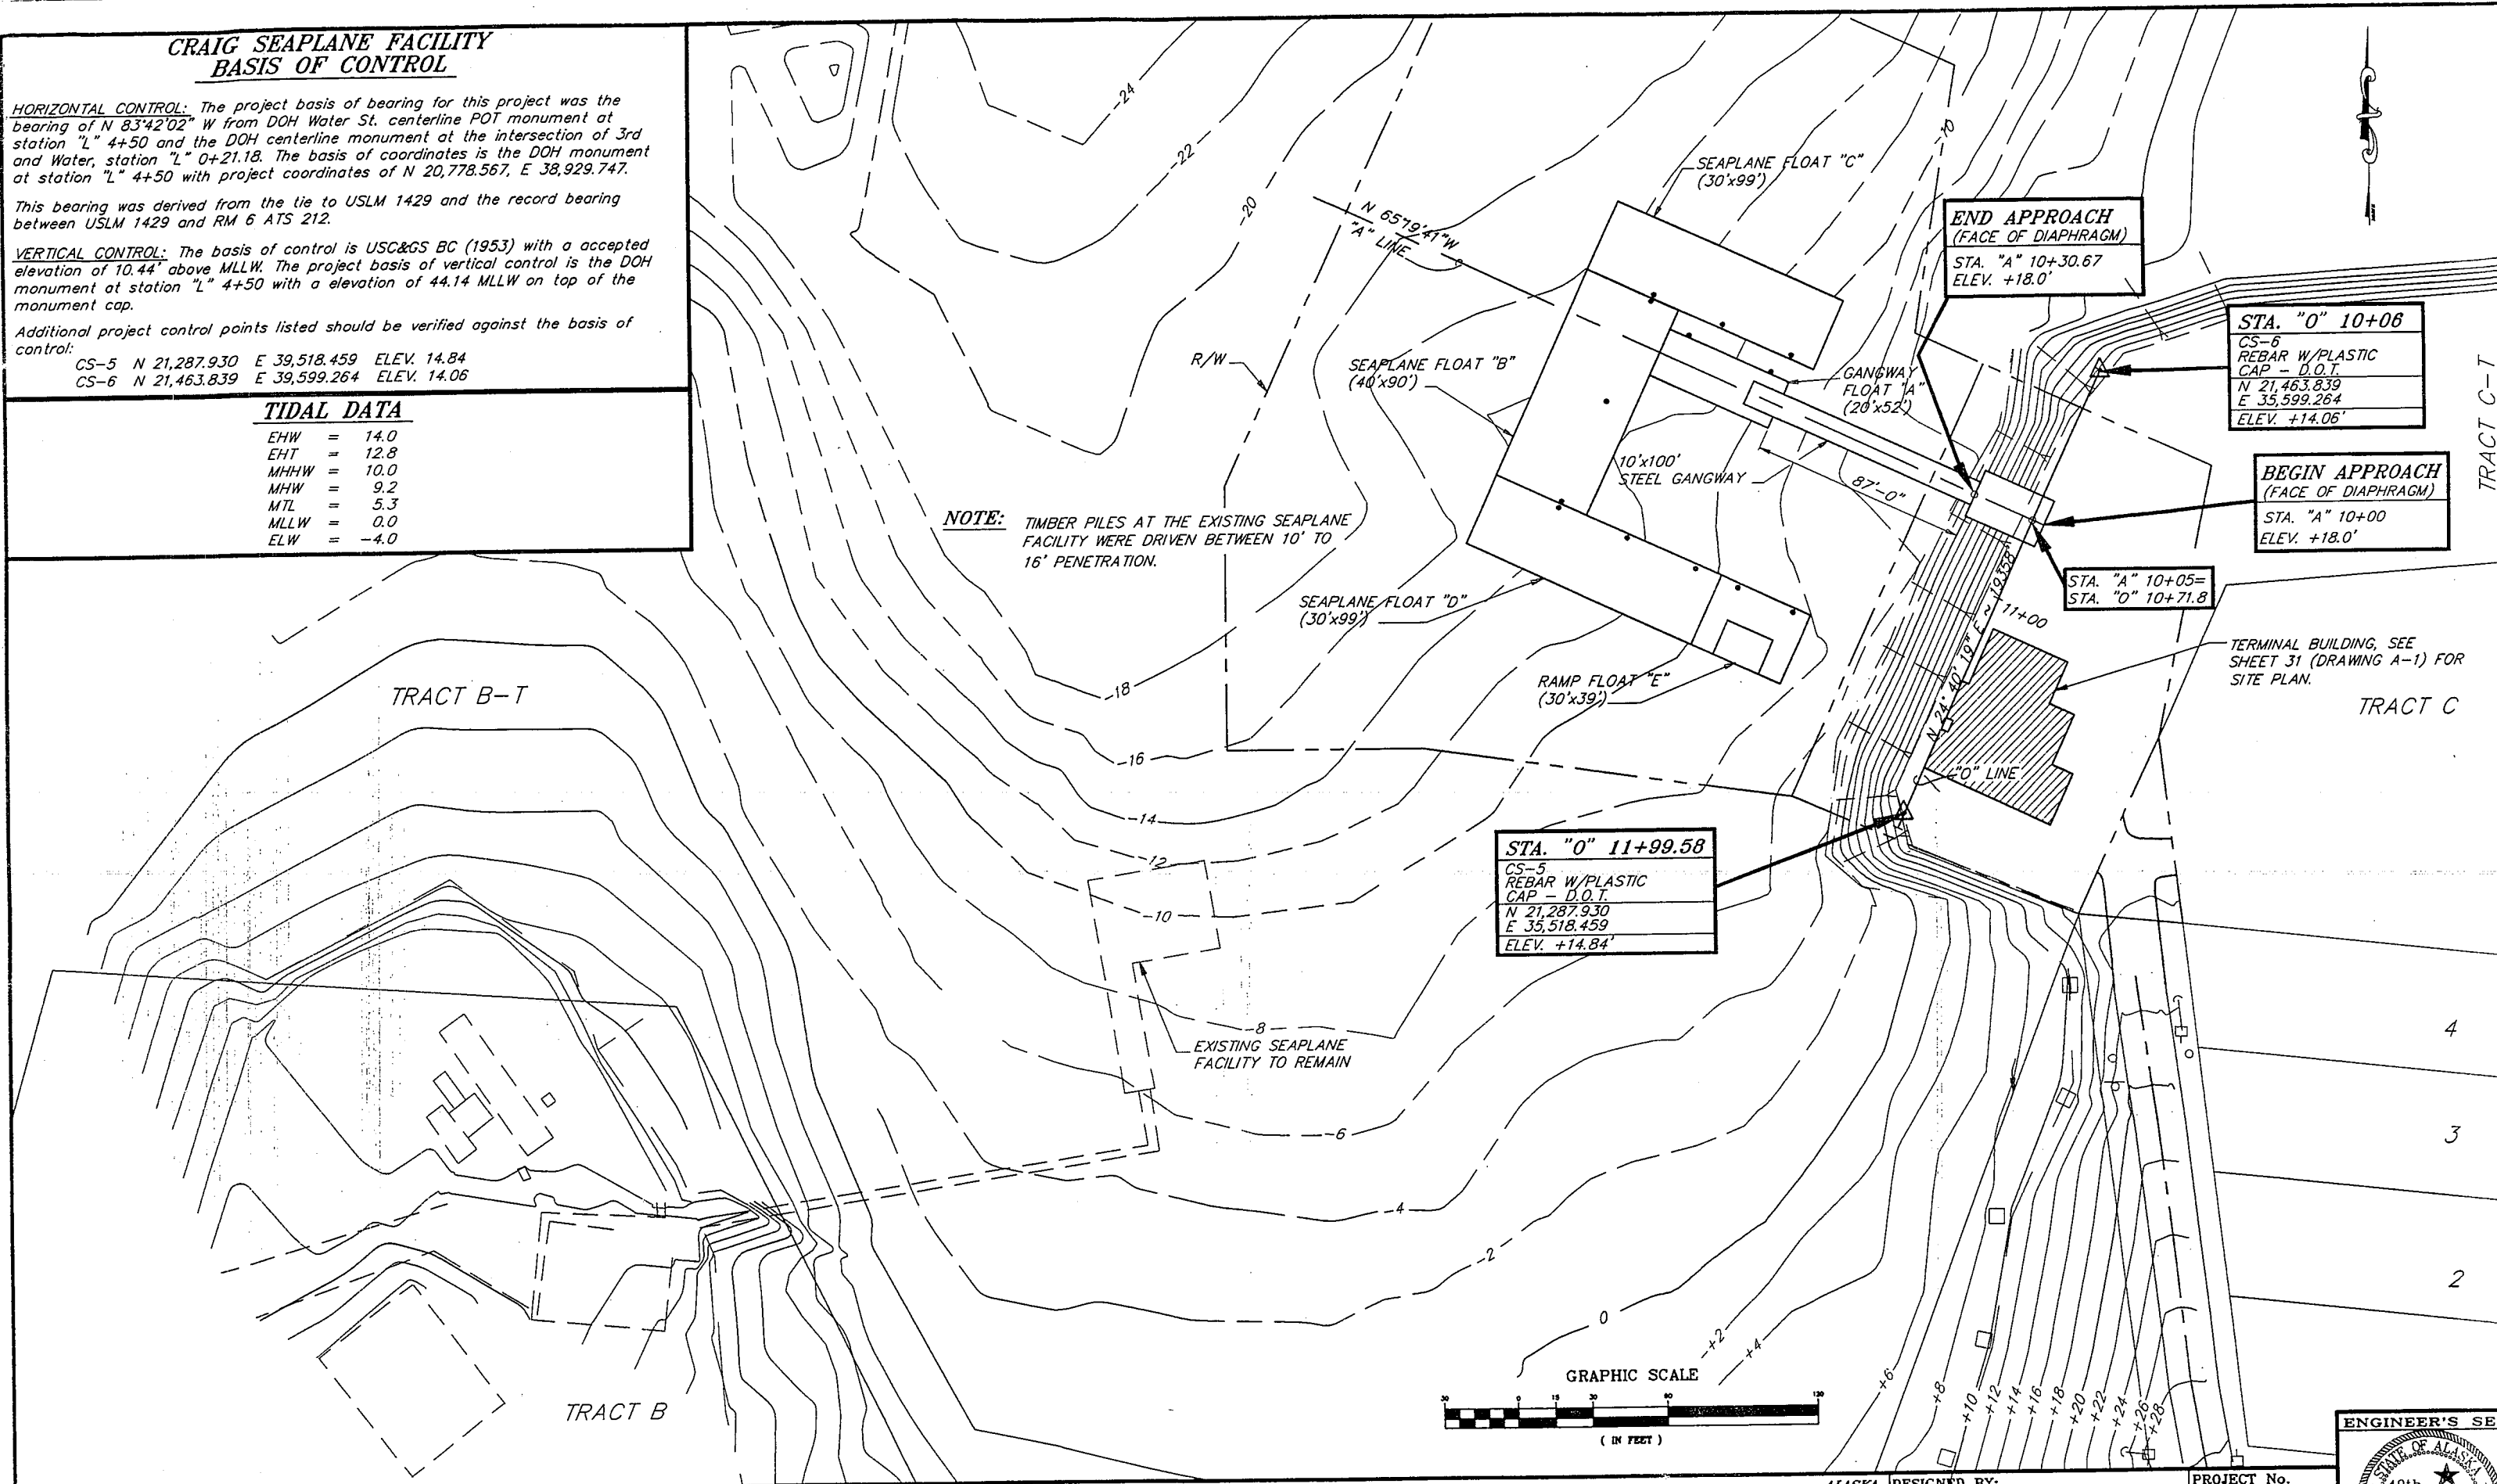


PATH : P:\CRG\SEAPL\DR\SH73.dwg < 1=30 >		
BY	DATE	DESCRIPTION OF CHANGE


RECORD OF REVISIONS

STATE OF ALASKA
DEPARTMENT OF TRANSPORTATION
AND PUBLIC FACILITIES
SOUTHEAST REGION DESIGN & CONSTRUCTION


CRAIG
CRAIG SEAPLANE BASE EXPANSION
A.I.P. # 3-02-0071-01
ALASKA
FLOAT LAYOUT

DESIGNED BY: D.D.S.	PROJECT No. 69956
DRAWN BY: B.W.B.	DATE: JULY 1994
CHECKED BY: D.D.S.	SHEET 3 OF 60

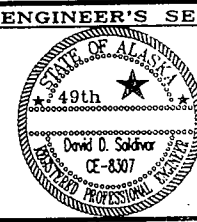

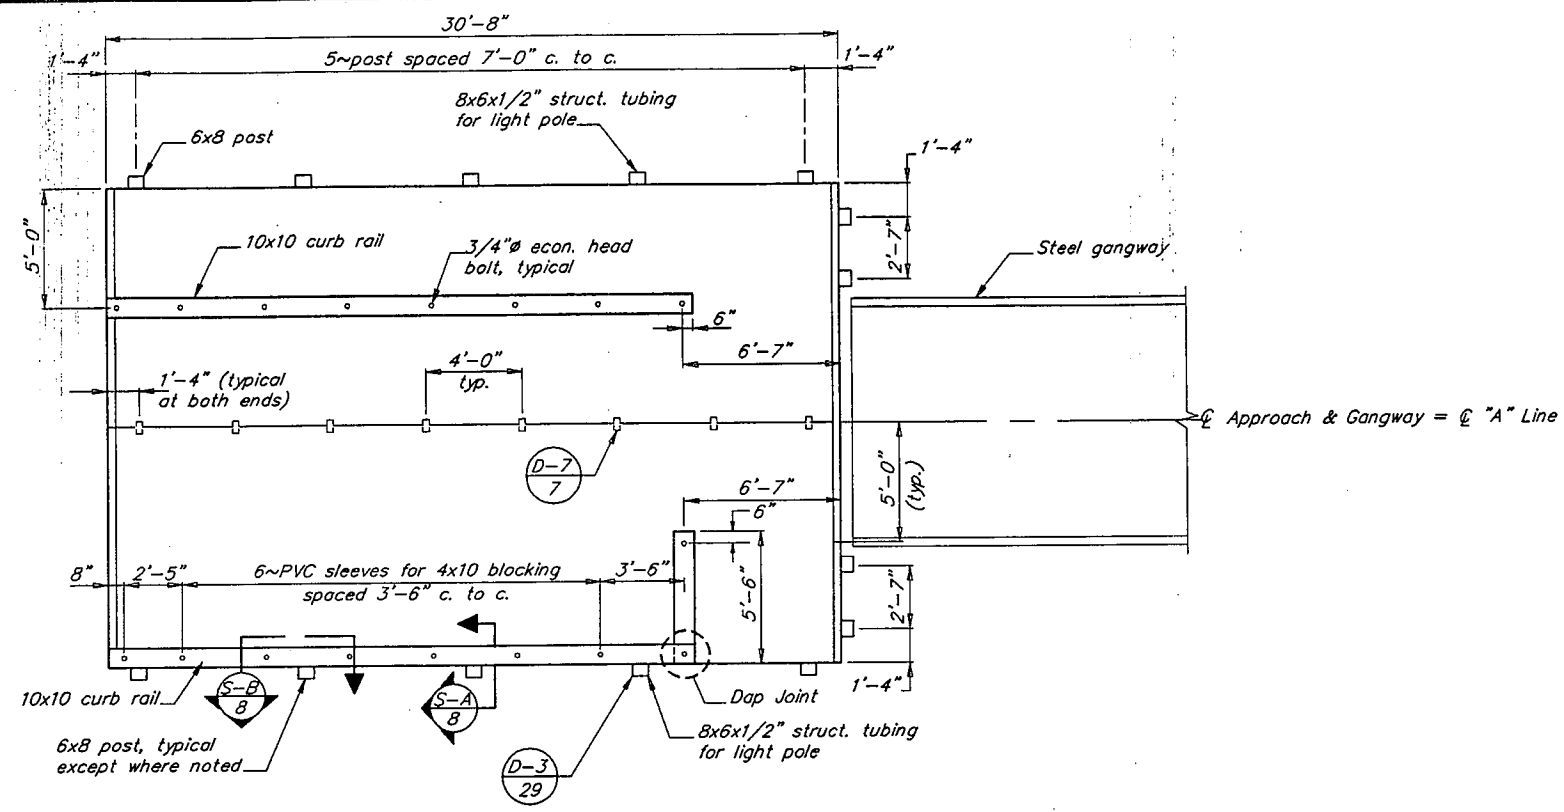

PLAN

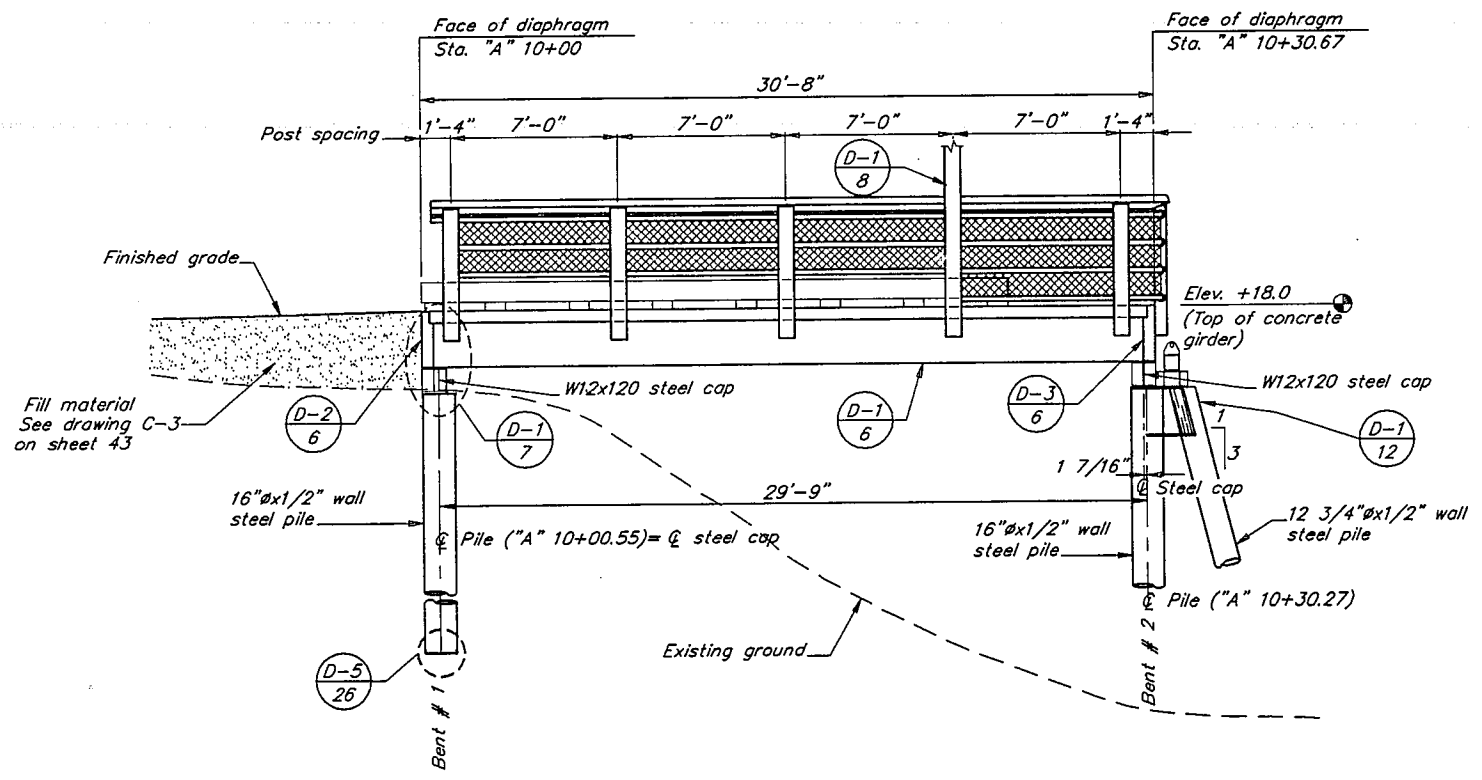

ELEVATION

APPROACH DESIGN CRITERIA


Concrete strength: 4,500 p.s.i. @ release
 6,000 p.s.i. @ 28 days
 Prestressing: 8-1/2" ϕ x 270 k.s.i. strands per stem
 Design loading: H20-44
 Rebar: Grade 60, epoxy coated
 Pile bearing required: 60 tons for 16" ϕ steel pipe and 30 tons for 12 3/4" ϕ batter pile
 Estimated pile penetration 30 feet


RECORD OF REVISIONS		
BY	DATE	DESCRIPTION OF CHANGE

STATE OF ALASKA
 DEPARTMENT OF TRANSPORTATION
 AND PUBLIC FACILITIES
 SOUTHEAST REGION DESIGN & CONSTRUCTION


CRAIG
 CRAIG SEAPLANE BASE EXPANSION
 A.I.P. # 3-02-0071-01
APPROACH PLAN & ELEVATION

ALASKA	DESIGNED BY: D.D.S.	PROJECT No. 89958
	DRAWN BY: B.W.B.	DATE: JULY 1994
	CHECKED BY: M.H.	SHEET 4 OF 60

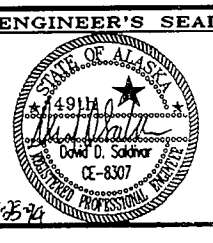


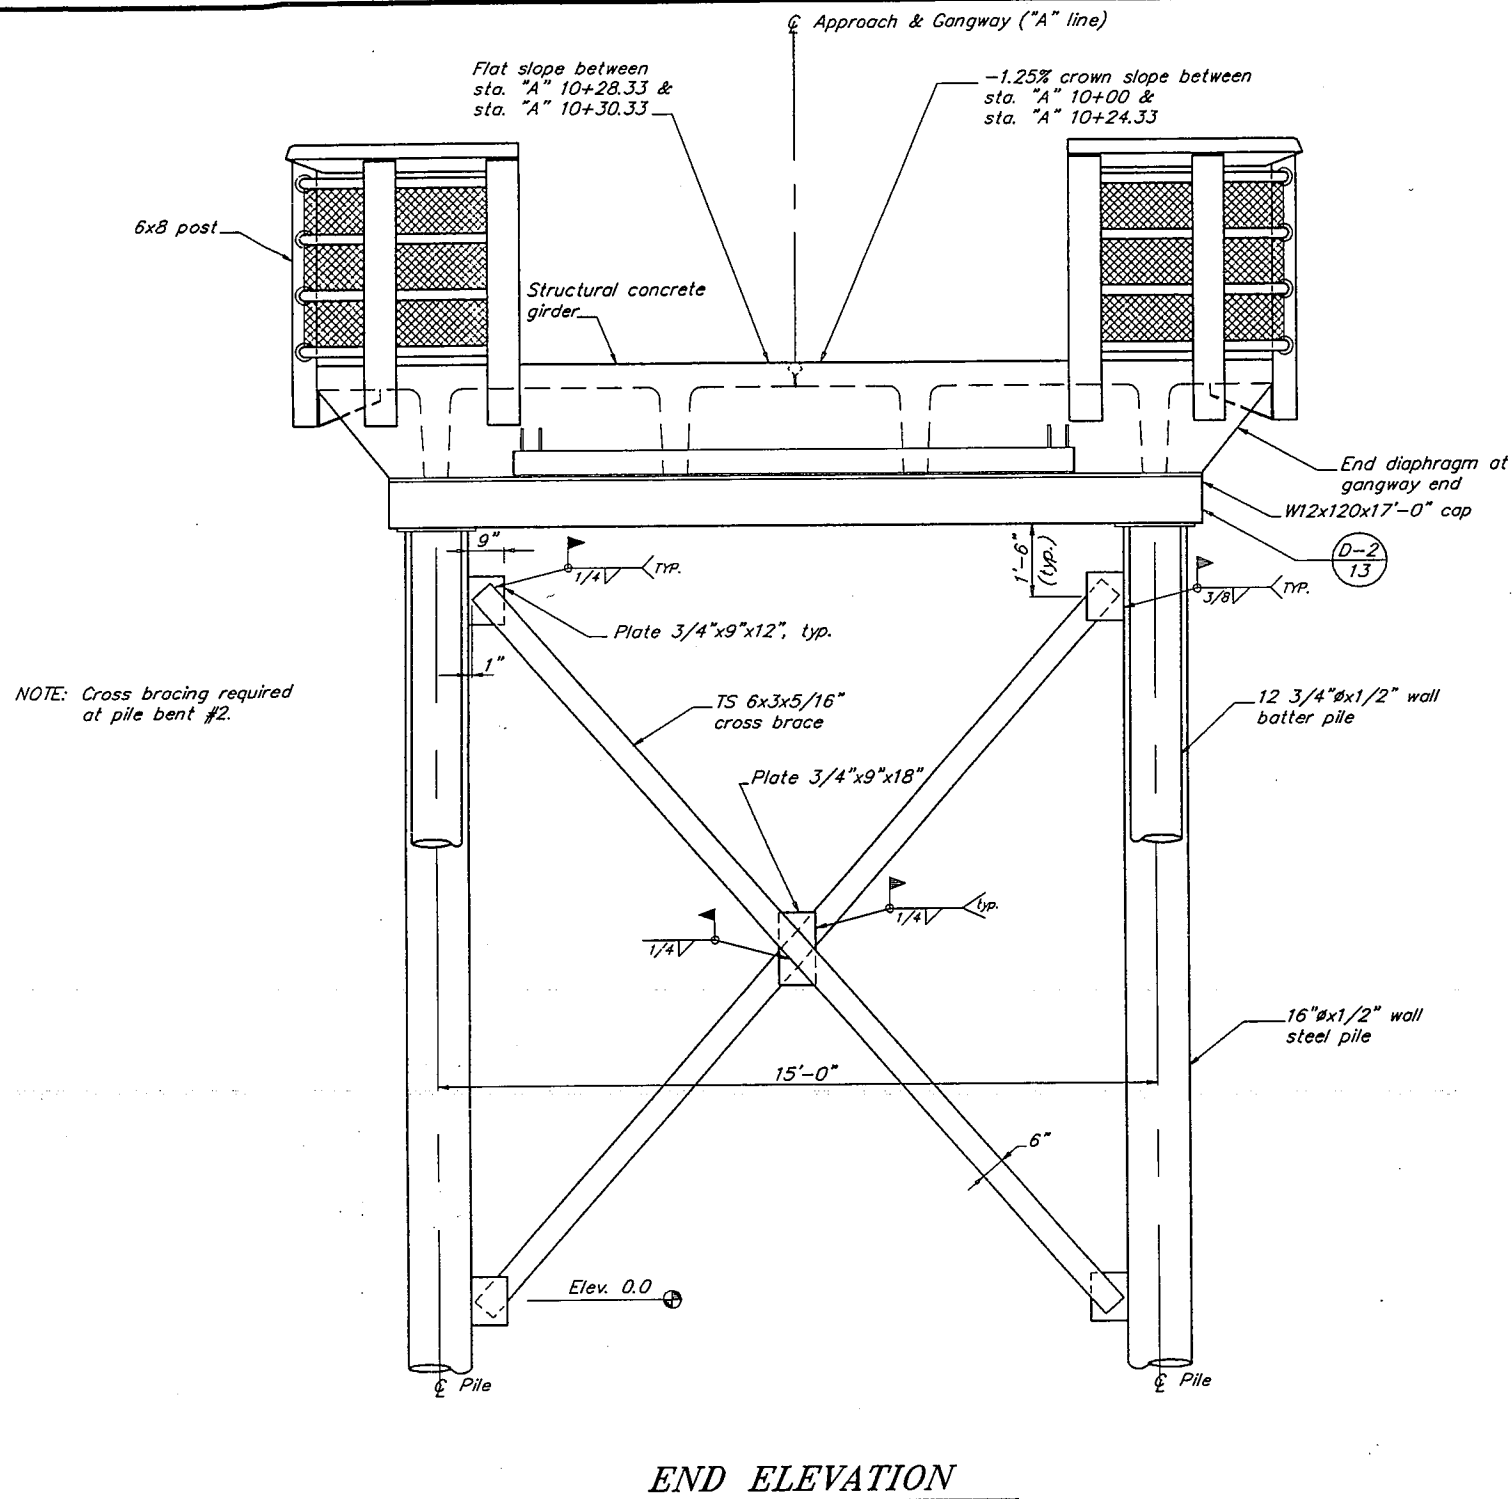

END ELEVATION

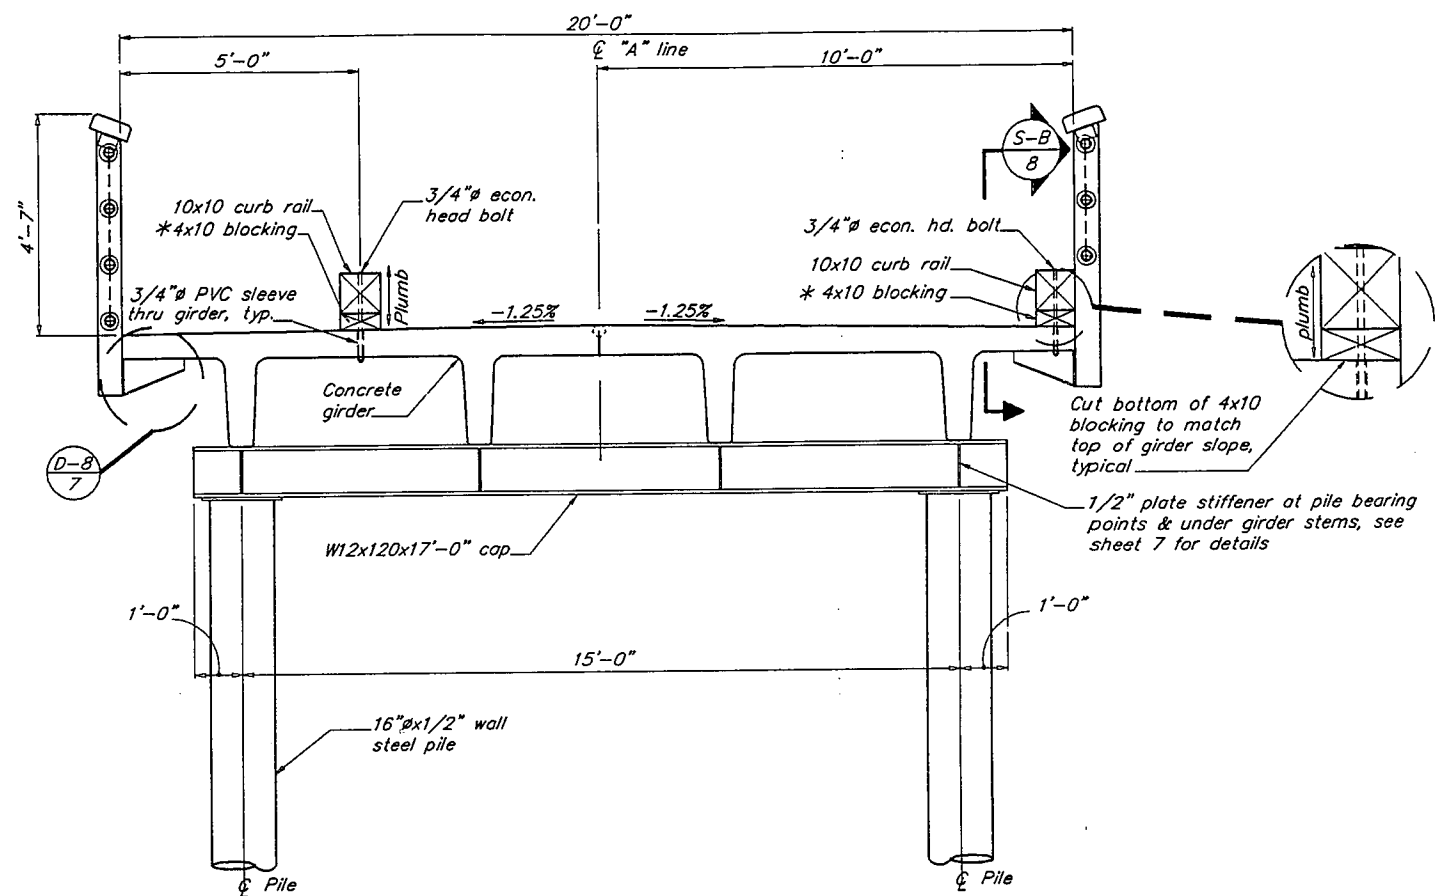

TYPICAL SECTION

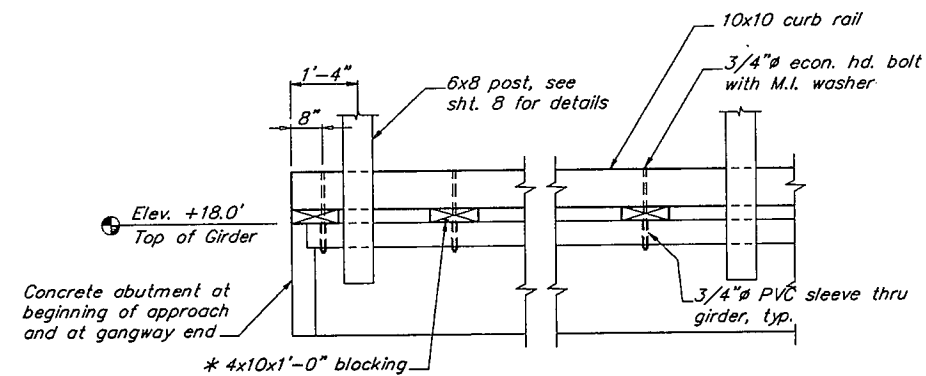

* Pre-drill & spike blocking to 10x10 curb rail with 2-60d nails.

CURB RAIL INSTALLATION

PATH: P:\CRA\SEAPL\DR\APPR2.dwg < 1=24 >		
BY	DATE	DESCRIPTION OF CHANGE
RECORD OF REVISIONS		

STATE OF ALASKA
DEPARTMENT OF TRANSPORTATION
AND PUBLIC FACILITIES
SOUTHEAST REGION DESIGN & CONSTRUCTION

CRAIG


CRAIG SEAPLANE BASE EXPANSION
A.I.P. # 3-02-0071-01

APPROACH SECTIONS

ALASKA

DESIGNED BY: D.D.S.
DRAWN BY: B.W.E.
CHECKED BY: C.A.B.


PROJECT No. 69956
DATE: JULY 1994
SHEET 5 OF 60

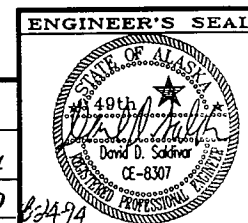


REINFORCING STEEL - ONE GIRDER

MARK	SIZE	No.	LENGTH	TYPE
G301	3	30		BENT
G401	4	2		STRAIGHT
G402	4	44		BENT
G403	4	32		STRAIGHT
G404	4	2		STRAIGHT
G501	5	160		STRAIGHT
G602	6	2		BENT
W401	4	62		BENT
W601	6	1		BENT
W602	6	4		STRAIGHT
W603	6	1		STRAIGHT



- NOTE:**
- Top G403 longitudinal reinforcement to be extended 2'-0" beyond end of girder, then bent and tied into abutment and end diaphragms.
 - The girder (gangway end) shall transition from -1.25% cross slope to a flat surface between Sta. "A" 10+24.33 and Sta. "A" 10+28.33. The last 2 feet of the approach (Sta. "A" 10+28.33 to Sta. "A" 10+30.33) shall have a flat surface.

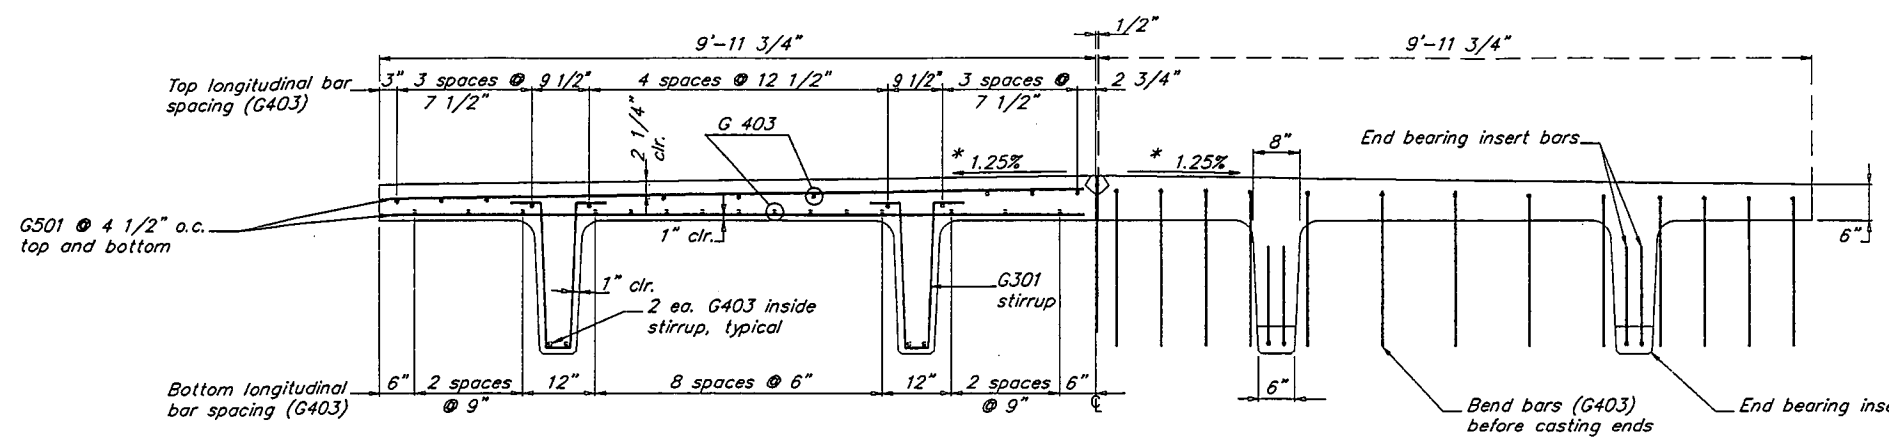

SECTION **ELEVATION**
GIRDER SECTION (Before casting ends)

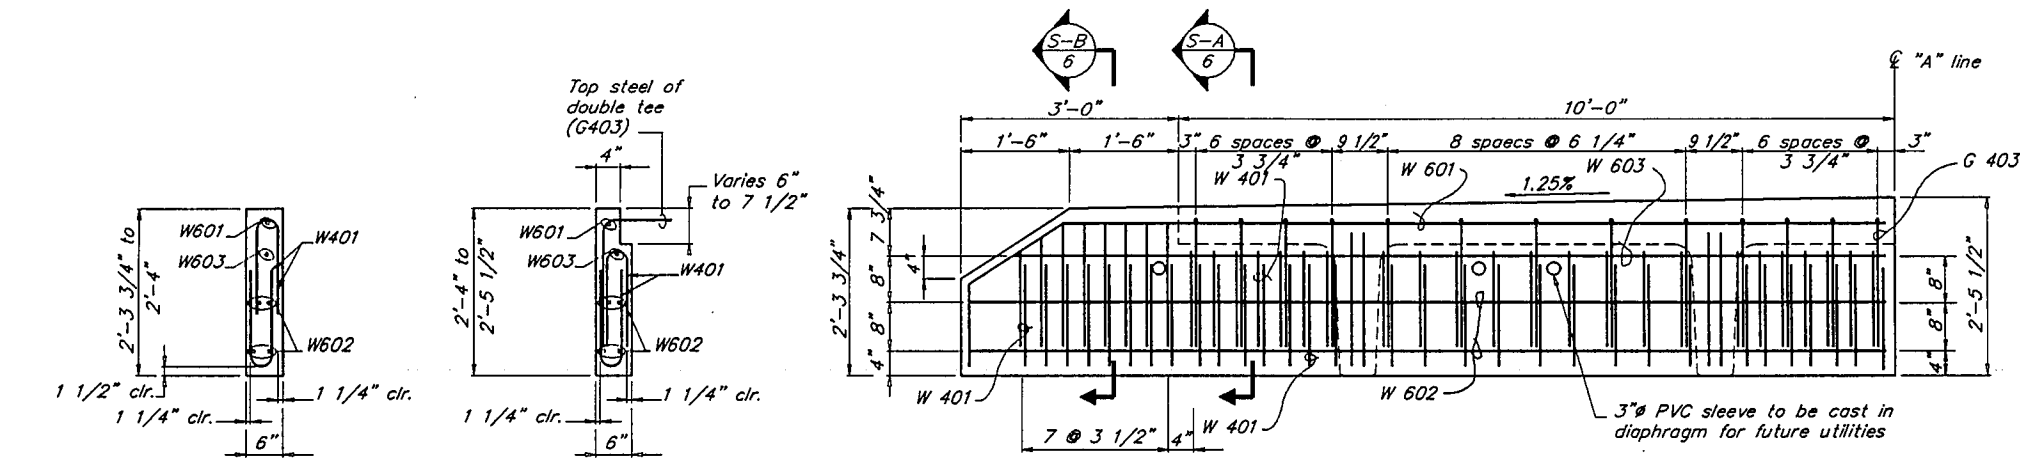

SECTION B **SECTION A** **ABUTMENT DIAPHRAGM - END VIEW**

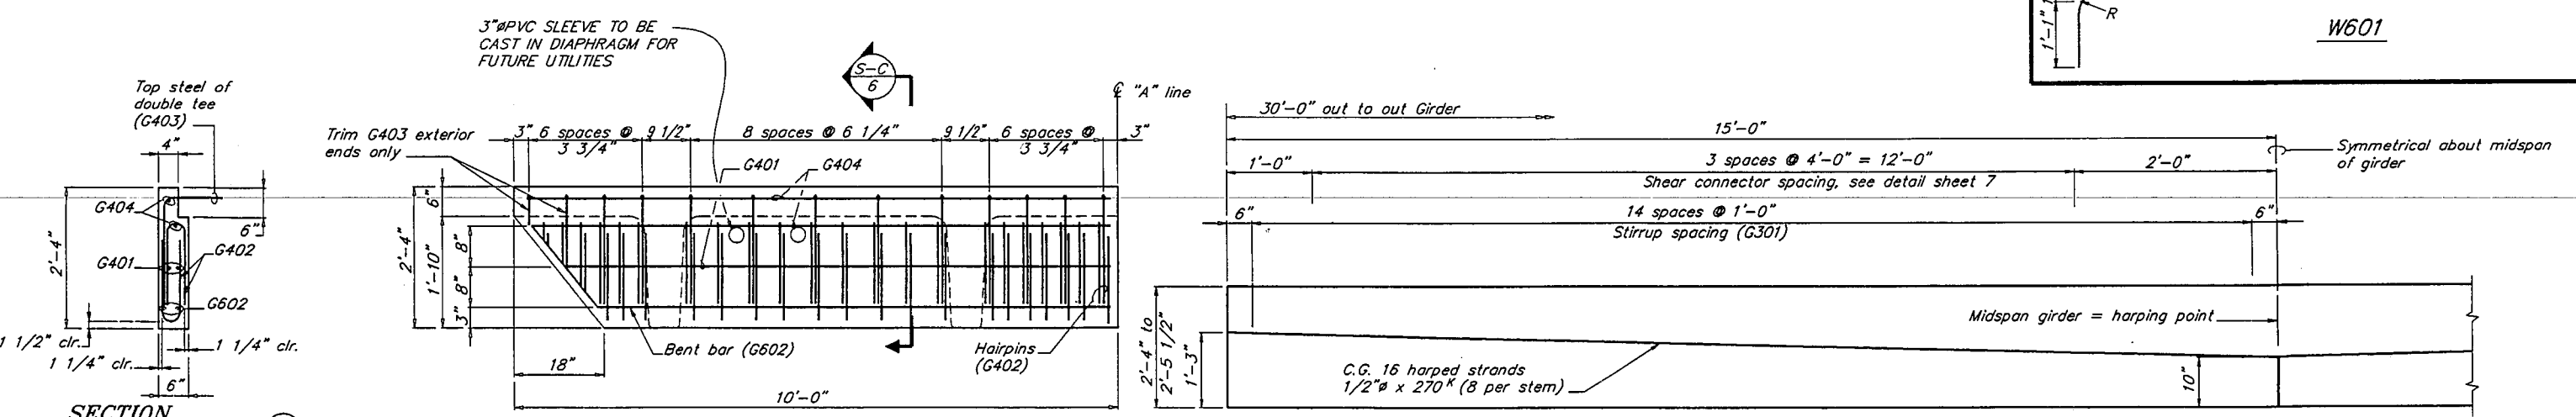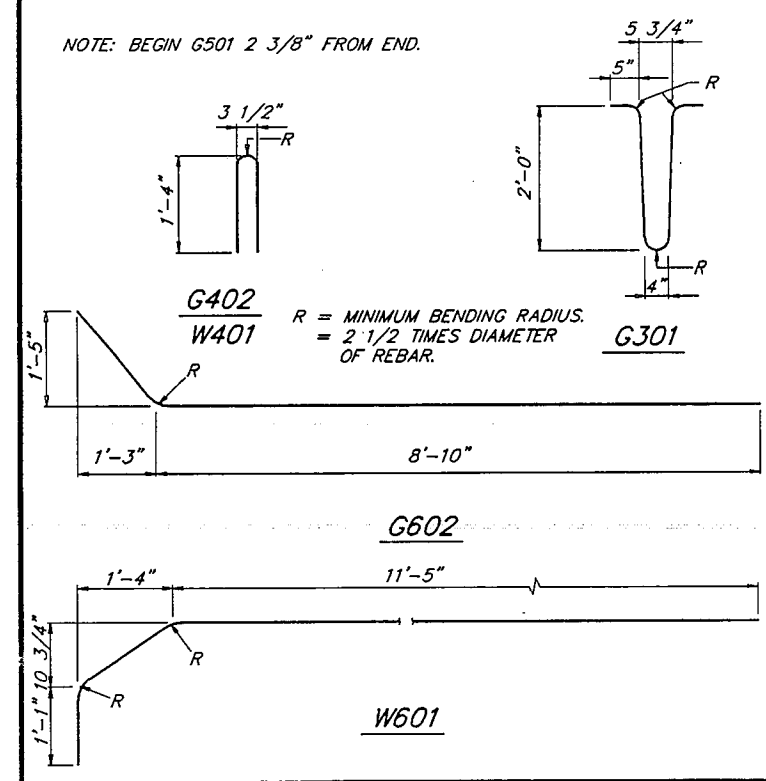

END DIAPHRAGM - END VIEW **GIRDER ELEVATION**

PATH: P:\CRG\SEAL\DR\APPR3.dwg < 1=16 >


BY	DATE	DESCRIPTION OF CHANGE


RECORD OF REVISIONS

STATE OF ALASKA
DEPARTMENT OF TRANSPORTATION
AND PUBLIC FACILITIES
SOUTHEAST REGION DESIGN & CONSTRUCTION

CRAIG
CRAIG SEAPLANE BASE EXPANSION
A.I.P. # 3-02-0071-01
APPROACH GIRDER DETAILS


ALASKA
DESIGNED BY: D.D.S.
DRAWN BY: B.W.B.
CHECKED BY: C.A.B.
PROJECT No. 69956
DATE: JULY 1994
SHEET 6 OF 60

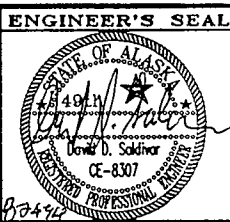

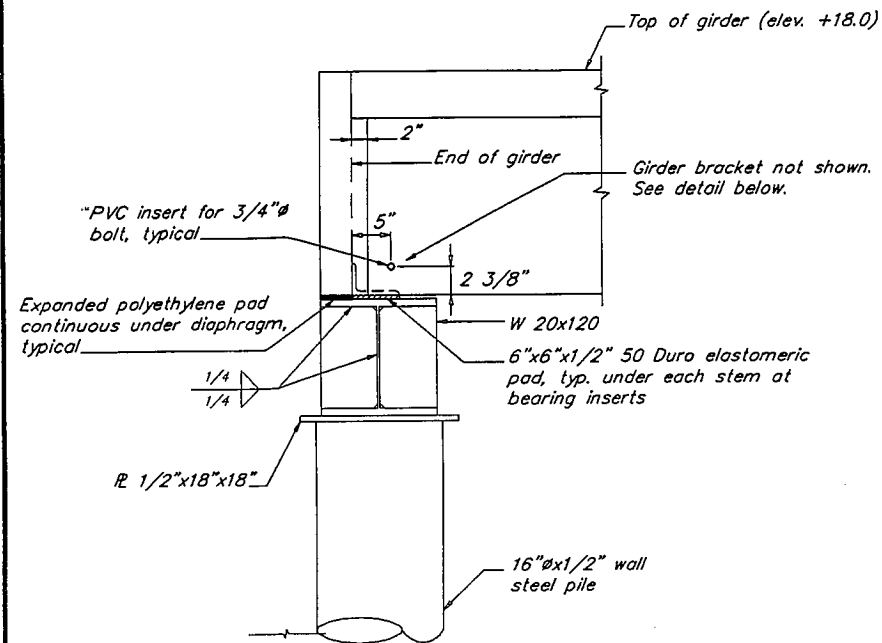


ABUTMENT ELEVATION

1

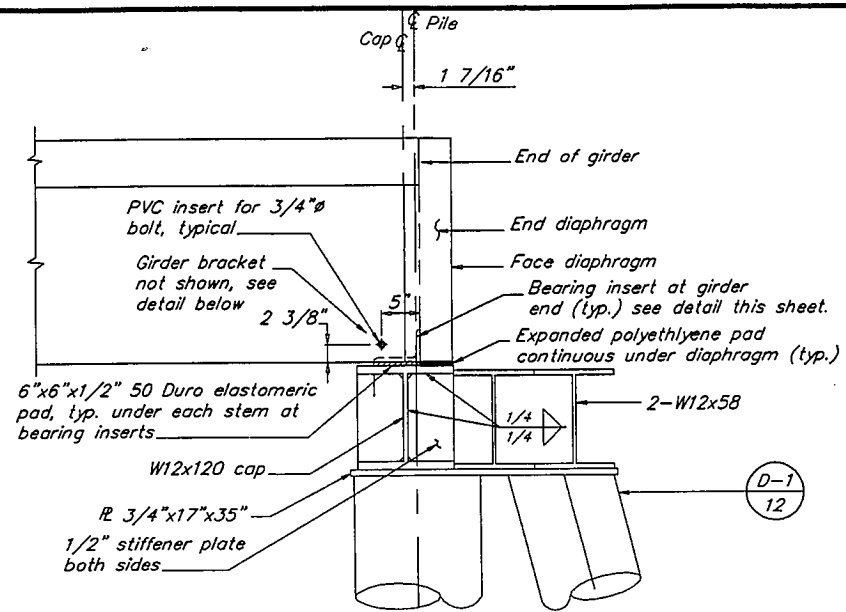

GANGWAY END BENT ELEVATION


2

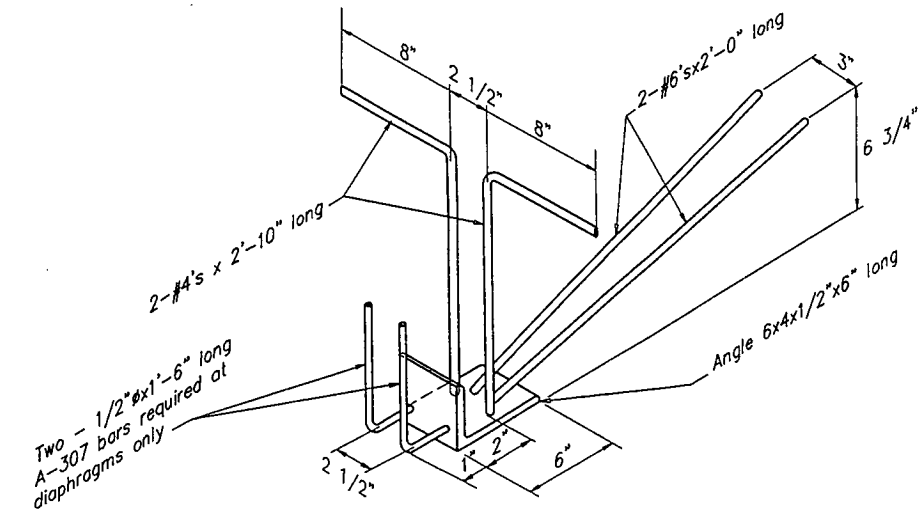

END BEARING INSERT


(Typical at each end of girder, each stem)

3

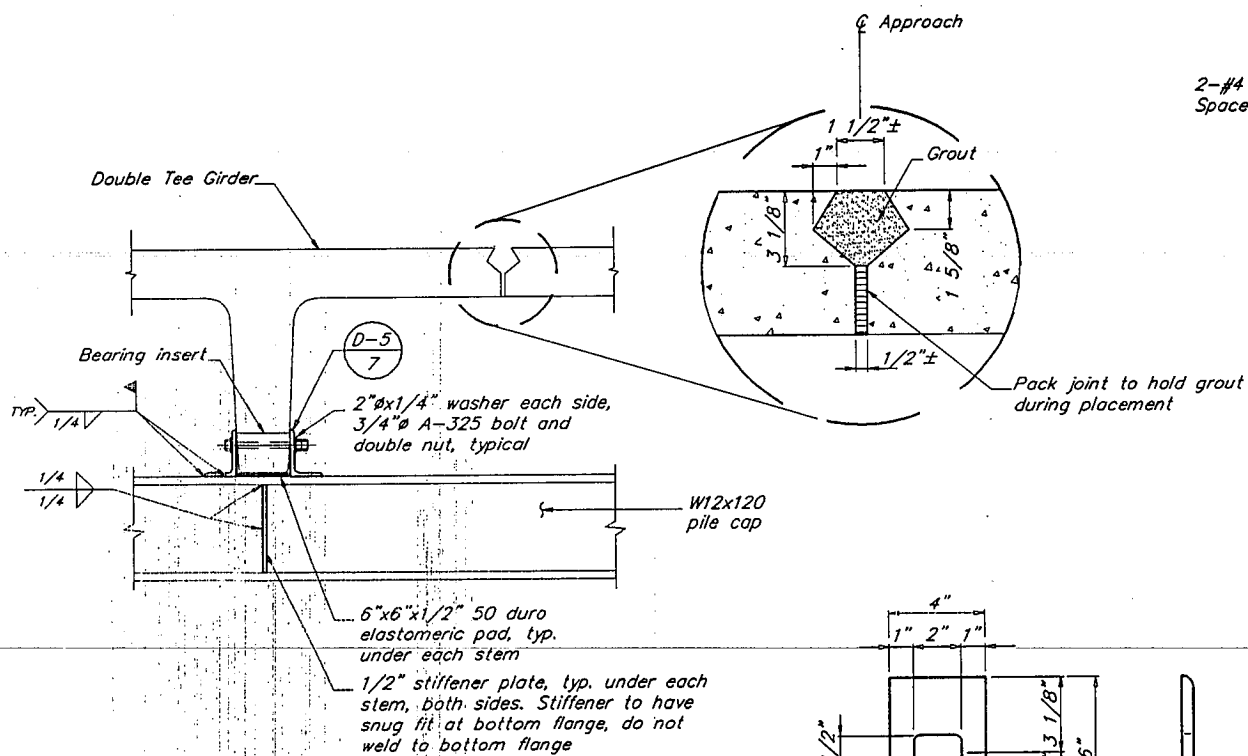


SECTION AT GIRDER

4

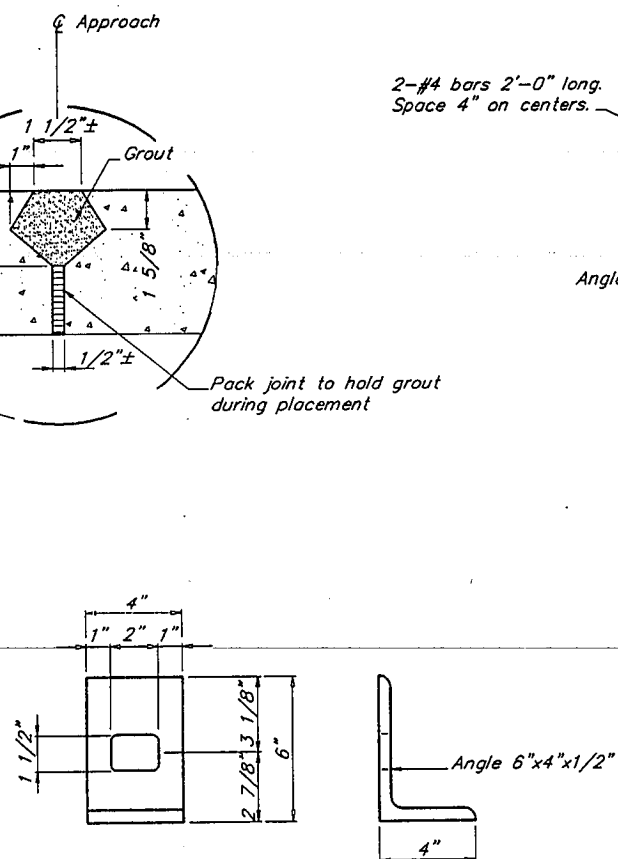


GIRDER BRACKET DETAIL

5

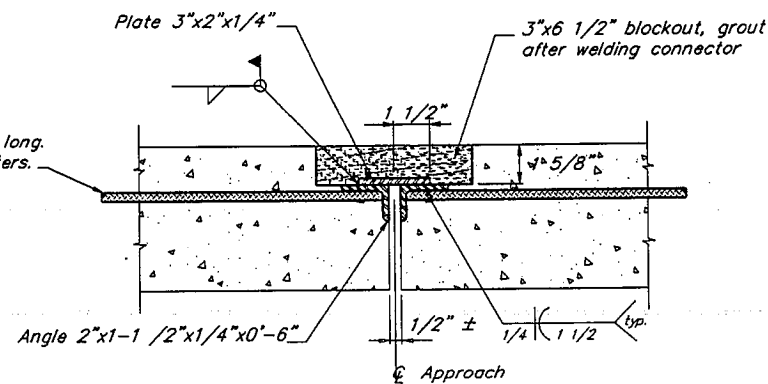


SHEAR CONNECTOR DETAIL

7

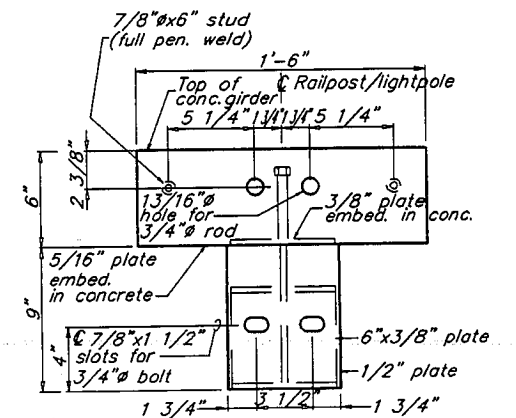


SECTION C

C

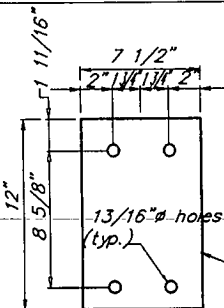

RAILPOST BEARING PLATE DETAIL

6

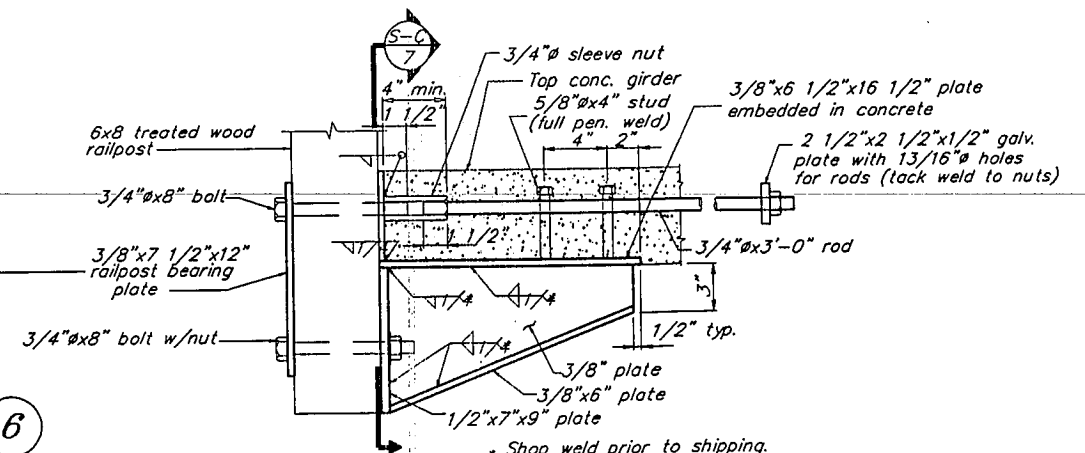

RAILPOST ANCHOR ASSEMBLY


8


PATH : P:\CRO\SEAPL\DR\APPR4.dwg < 1=12 >		
BY	DATE	DESCRIPTION OF CHANGE

STATE OF ALASKA
DEPARTMENT OF TRANSPORTATION
AND PUBLIC FACILITIES
SOUTHEAST REGION DESIGN & CONSTRUCTION


CRAIG
CRAIG SEAPLANE BASE EXPANSION
A.I.P. # 3-02-0071-01
APPROACH DETAILS

ALASKA	DESIGNED BY:	PROJECT No.
	D.D.S.	69956
	DRAWN BY:	DATE:
	B.W.B.	JULY 1994
	CHECKED BY:	SHEET 7 OF 60
	C.A.B.	

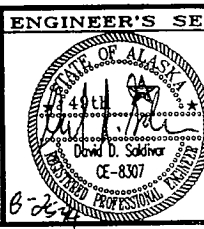


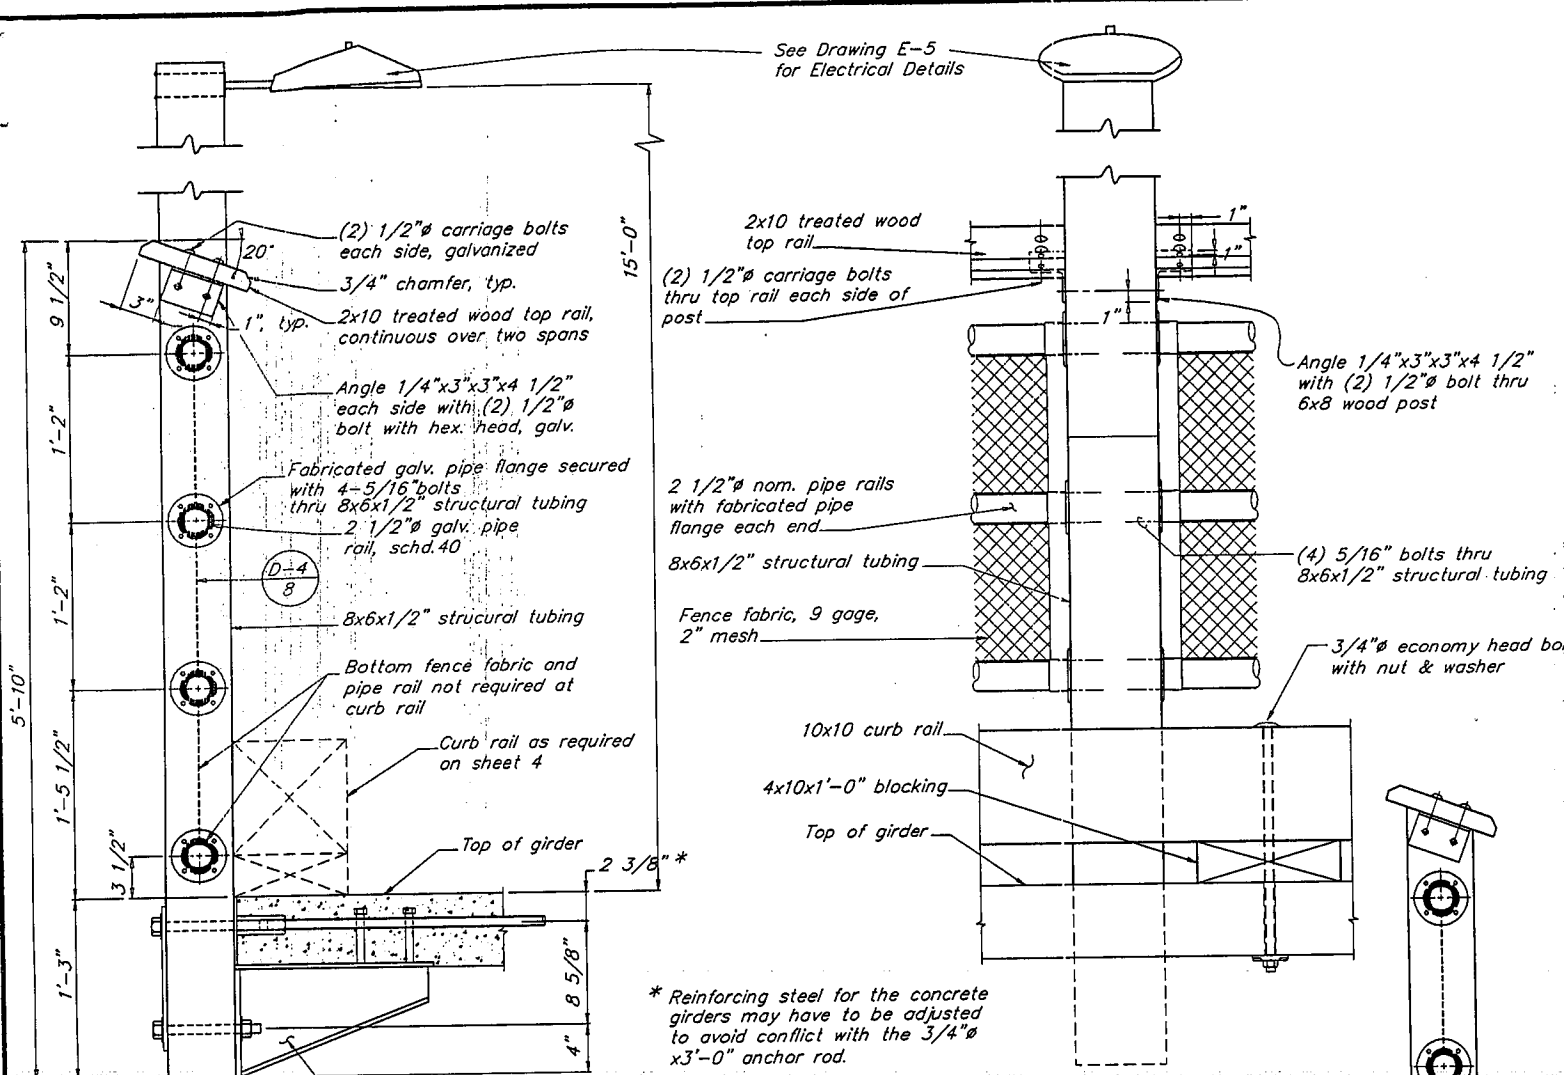


SECTION 1
LIGHT POLE DETAIL AT APPROACH

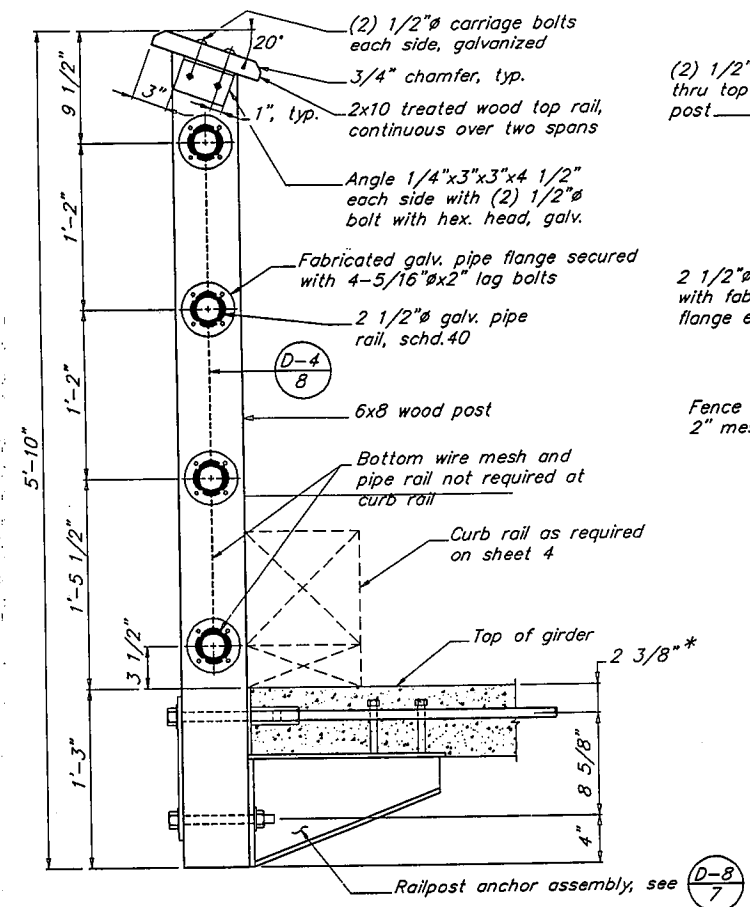

SECTION A
RAILPOST ANCHOR DETAIL @ GANGWAY END

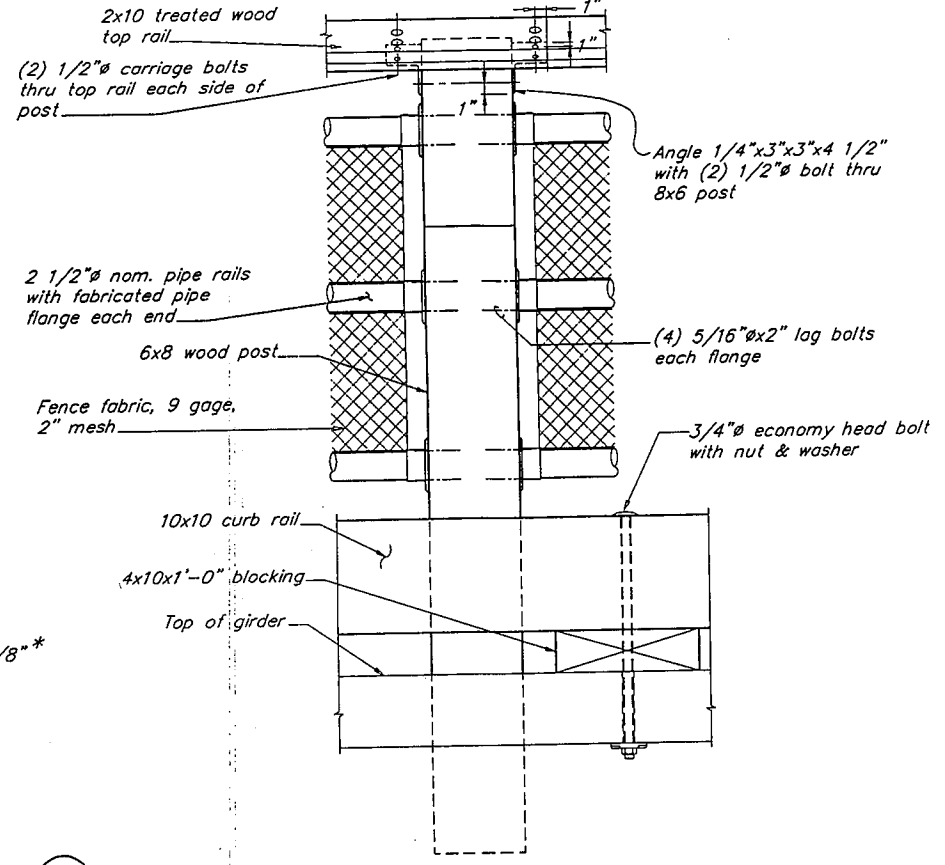


SECTION B
HANDRAIL CORNER DETAILS

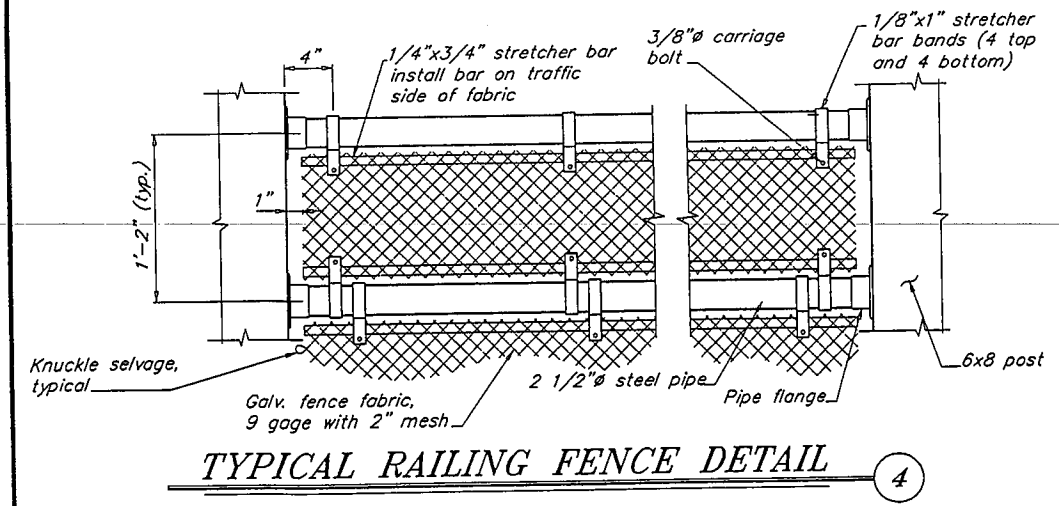


SECTION 4
TYPICAL RAILING FENCE DETAIL

- NOTES:**
- Bend stretcher bar to match the pipe railing at corners. Four top and four bottom stretcher bar bands are required at the corner railing.
 - Fence fabric shall be stretched to a uniform appearance.

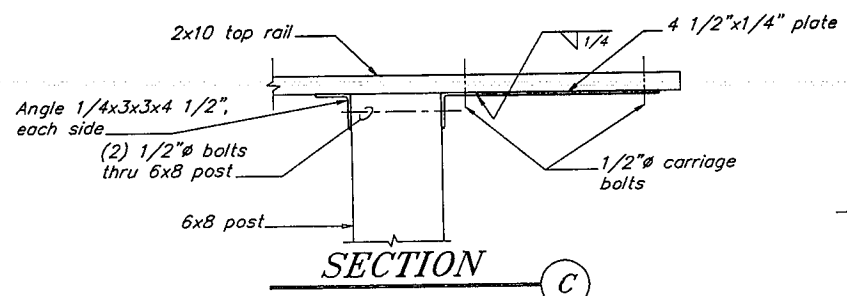

SECTION C
PLAN @ PIPERAIL CORNER

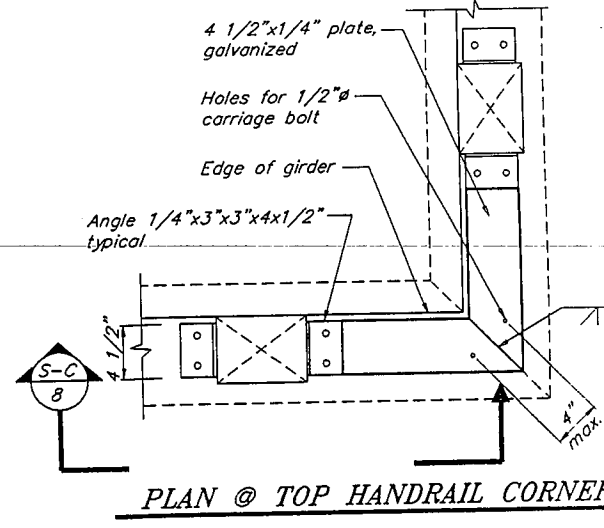


PLAN @ TOP HANDRAIL CORNER

RECORD OF REVISIONS		
BY	DATE	DESCRIPTION OF CHANGE






STATE OF ALASKA
DEPARTMENT OF TRANSPORTATION
AND PUBLIC FACILITIES
SOUTHEAST REGION DESIGN & CONSTRUCTION

CRAIG
CRAIG SEAPLANE BASE EXPANSION
A.I.P. # 3-02-0071-01
APPROACH RAILING DETAILS

ALASKA	DESIGNED BY: D.D.S.	PROJECT No. 69956
	DRAWN BY: B.W.B.	DATE: JULY 1994
	CHECKED BY: D.D.S.	SHEET 8 OF 60

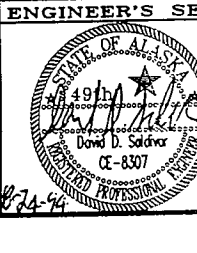

NOTE:
Pipe handrail, fence and chain link not shown. See detail on sheet 11.

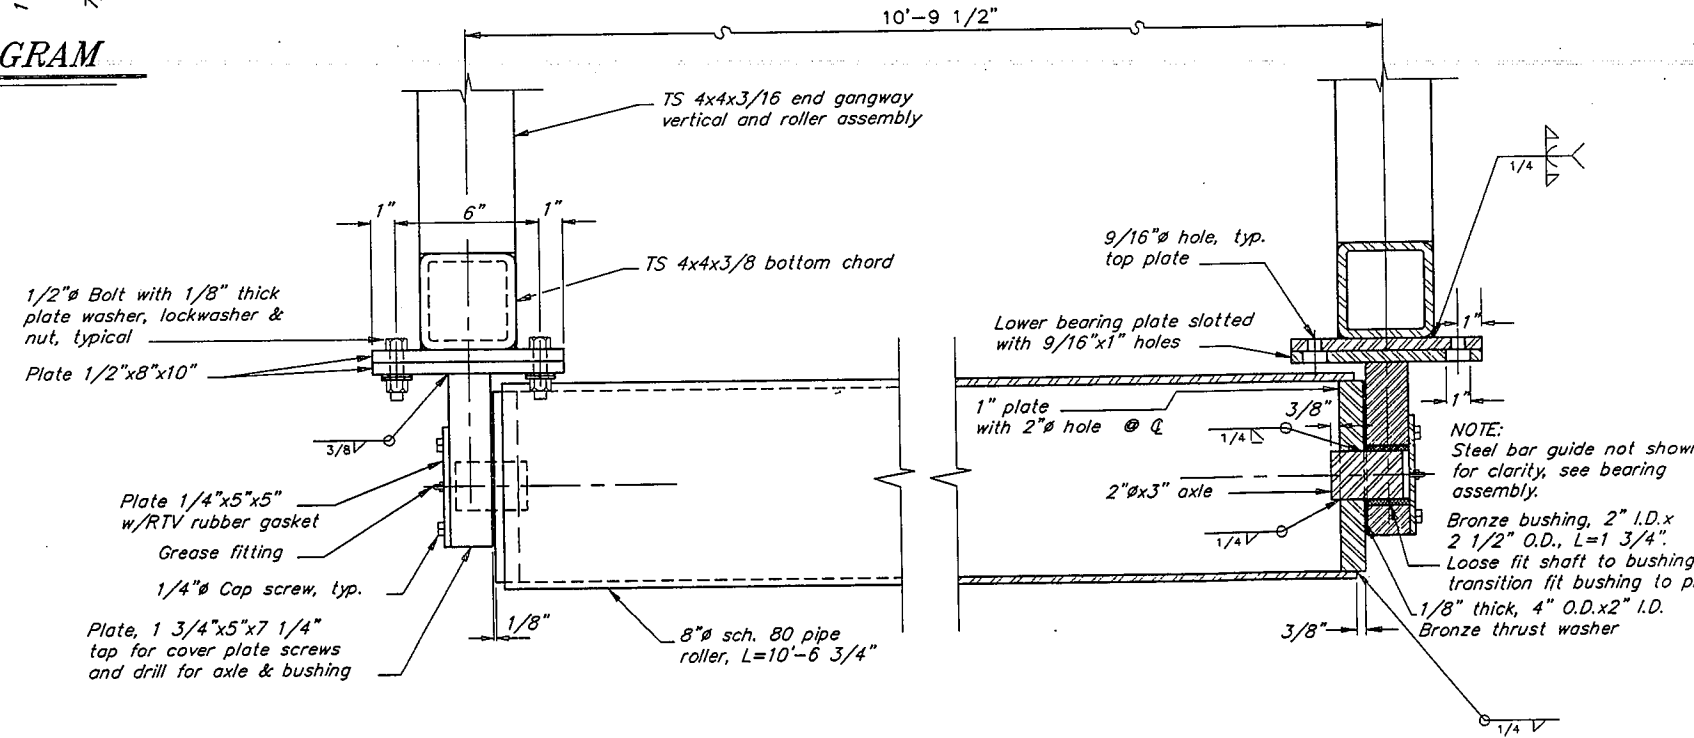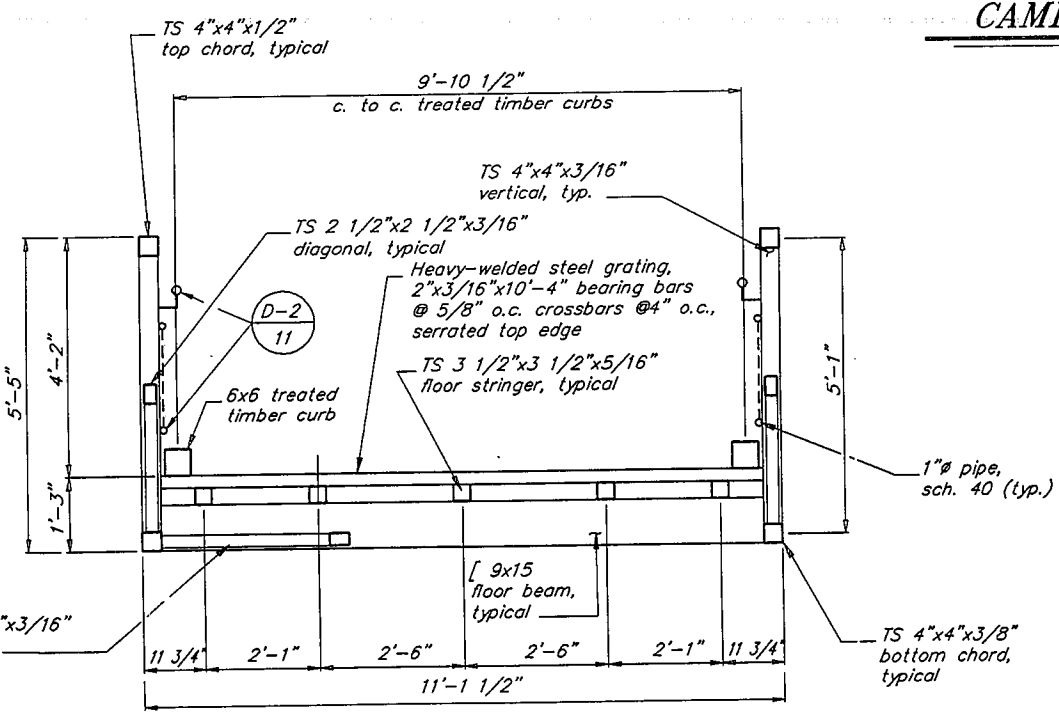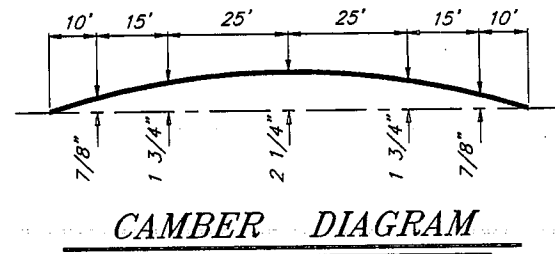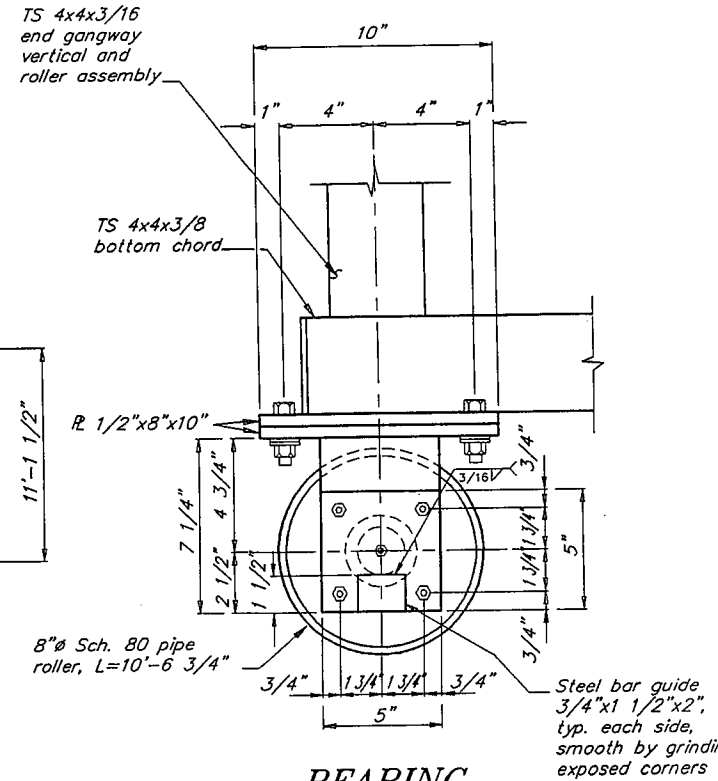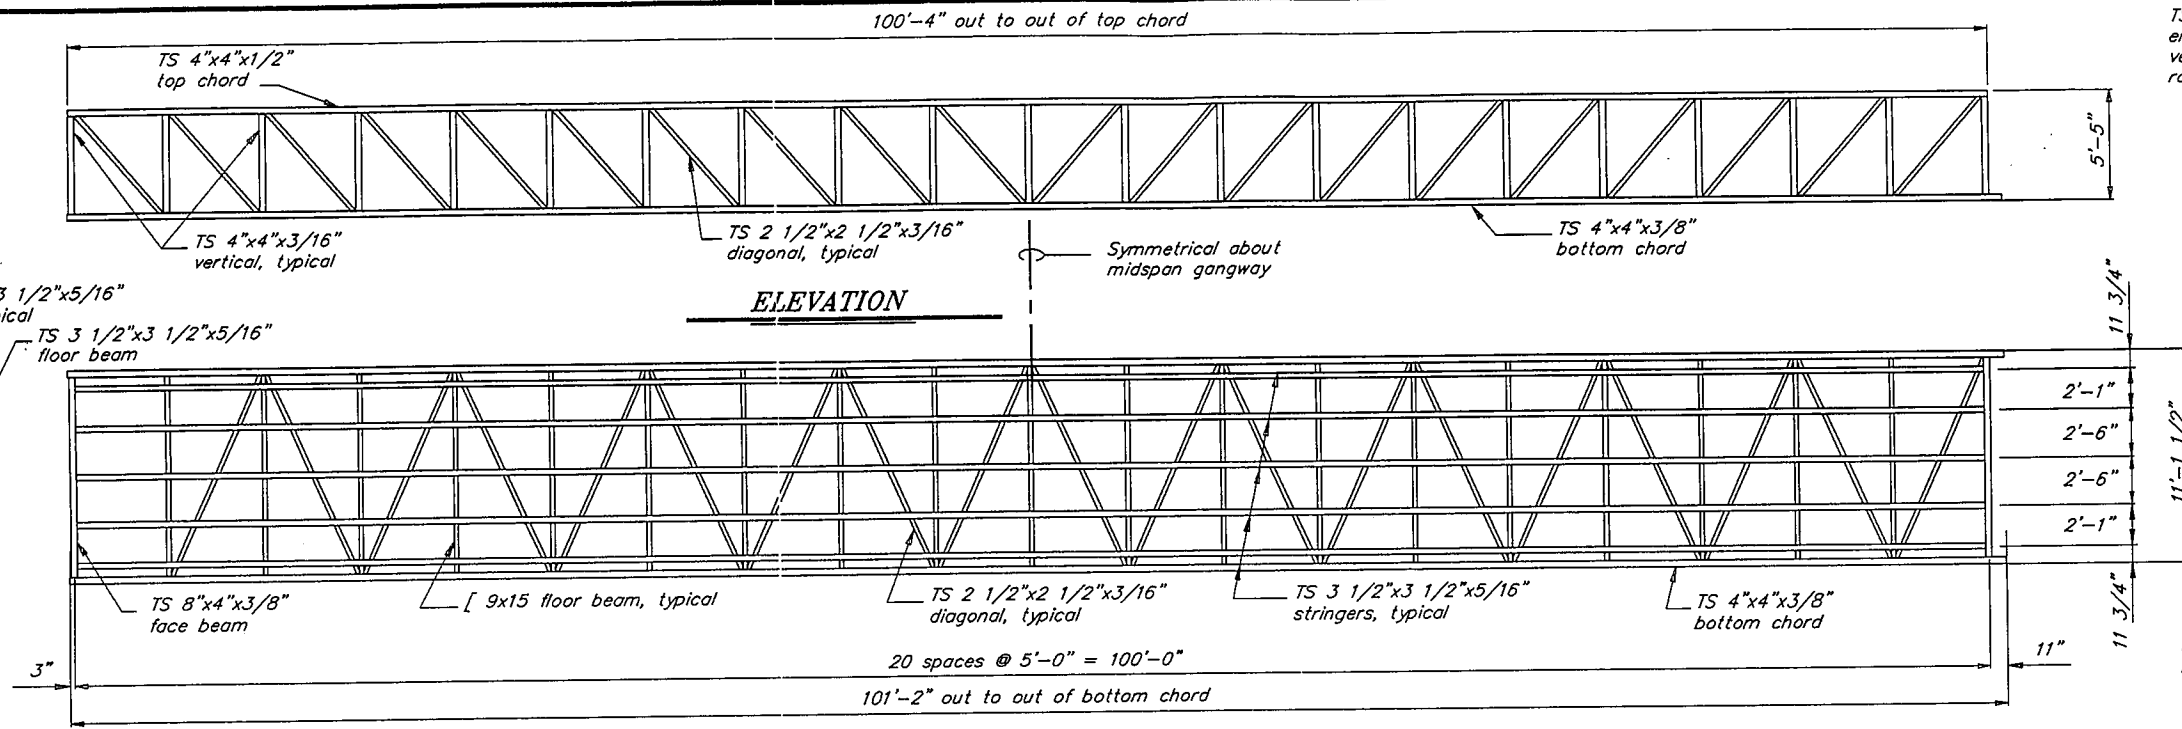



RECORD OF REVISIONS		
BY	DATE	DESCRIPTION OF CHANGE
PATH: P:\CRG\SEAFLY\DR\SH19.dwg <1=5>		

STATE OF ALASKA
DEPARTMENT OF TRANSPORTATION
AND PUBLIC FACILITIES
SOUTHEAST REGION DESIGN & CONSTRUCTION

CRAIG
CRAIG SEAPLANE BASE EXPANSION
A.I.P # 3-02-0071-01
100' x 10' GANGWAY DETAILS

ALASKA	DESIGNED BY: D.D.S.	PROJECT No. 69956
	DRAWN BY: B.W.B.	DATE: JULY 1994
	CHECKED BY: D.D.S.	SHEET 9 OF 60

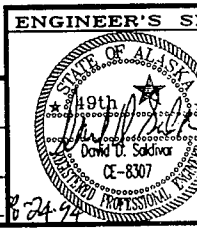

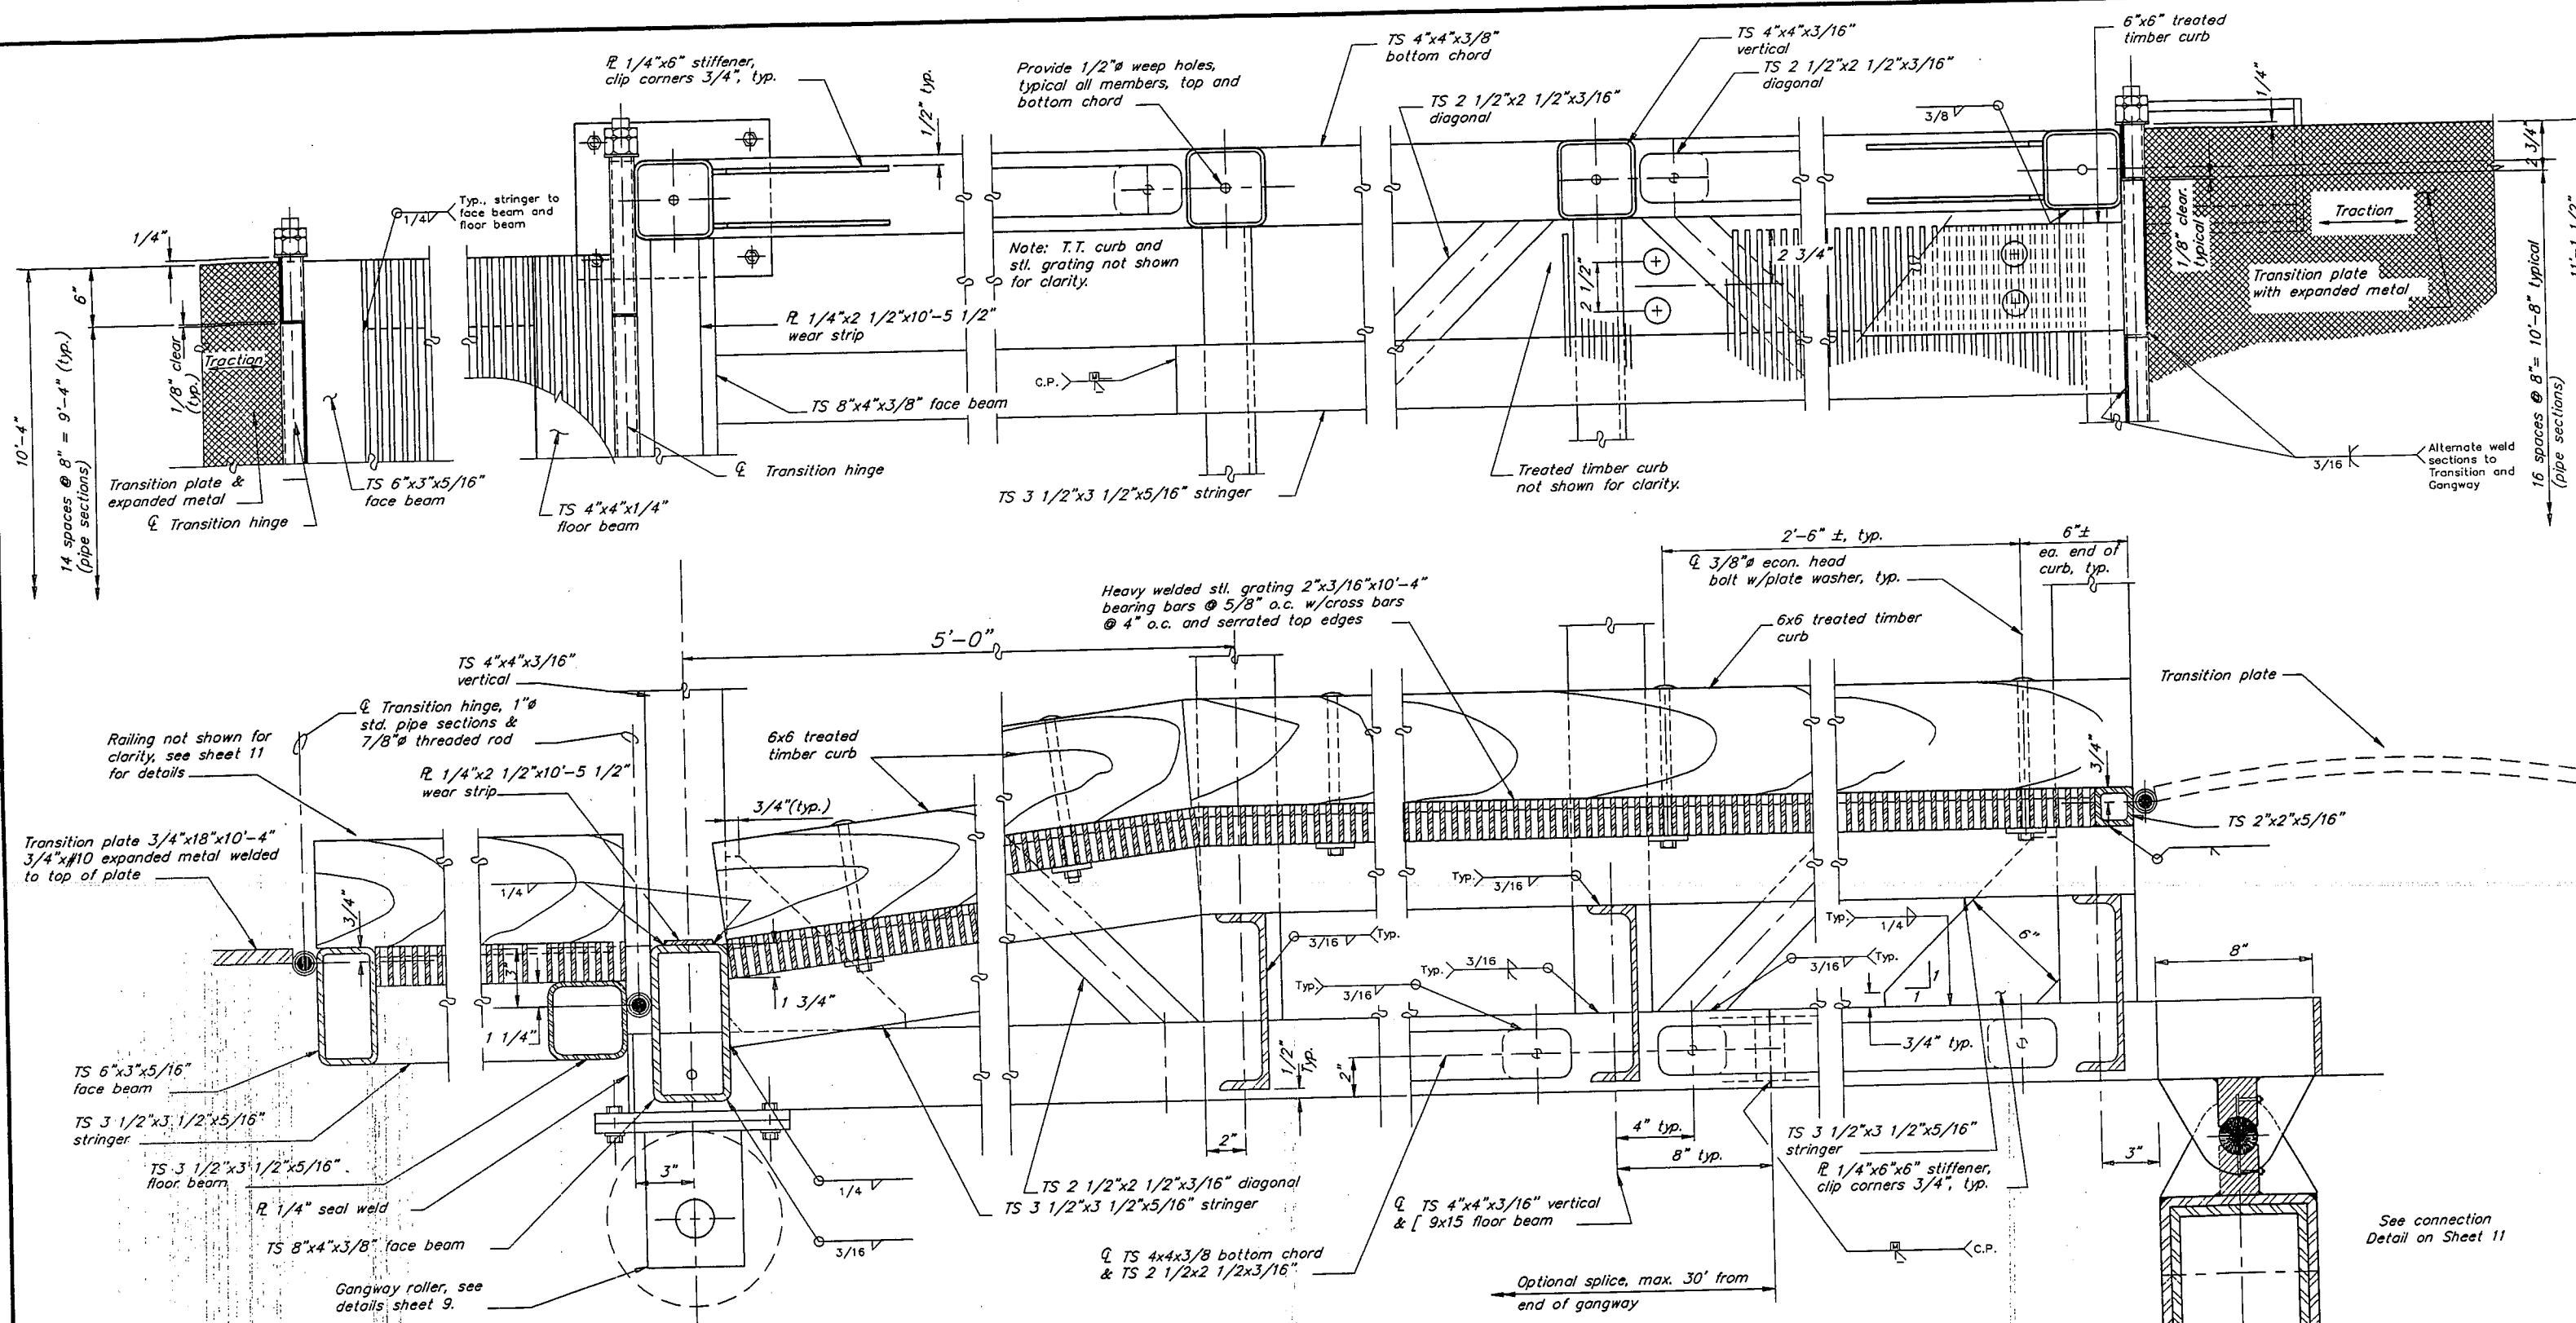

FRAMING DETAILS

- NOTES :**
1. Gangway shall be shipped assembled.
 2. Approximate Gangway weight = 54,000#.
 3. No bottom chord splice allowed within mid third of span.
 4. Complete Gangway to be galvanized.
 5. Gangway camber shall be smooth and parabolic.
 6. Method of fastening the steel grating shall be accomplished either by welding or bolting (1/2" min. A325 bolt) to the floor stringer. The steel grating shall be fastened at 2'-0" o.c. at each floor stringer and 6" from gangway ends.

PATH : P:\CRG\SEAPL\DR\SHITA.dwg <1wd>		
BY	DATE	DESCRIPTION OF CHANGE

STATE OF ALASKA
 DEPARTMENT OF TRANSPORTATION
 AND PUBLIC FACILITIES
 SOUTHEAST REGION DESIGN & CONSTRUCTION

CRAIG


CRAIG SEAPLANE BASE EXPANSION
 A.I.P # 3-02-0071-01


100' x 10' GANGWAY DETAILS

ALASKA


DESIGNED BY: D.D.S.
 DRAWN BY: B.W.B.
 CHECKED BY: C.A.B.

PROJECT No. 89958
 DATE: JULY 1994
 SHEET 10 OF 60

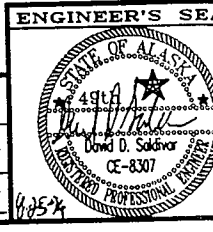


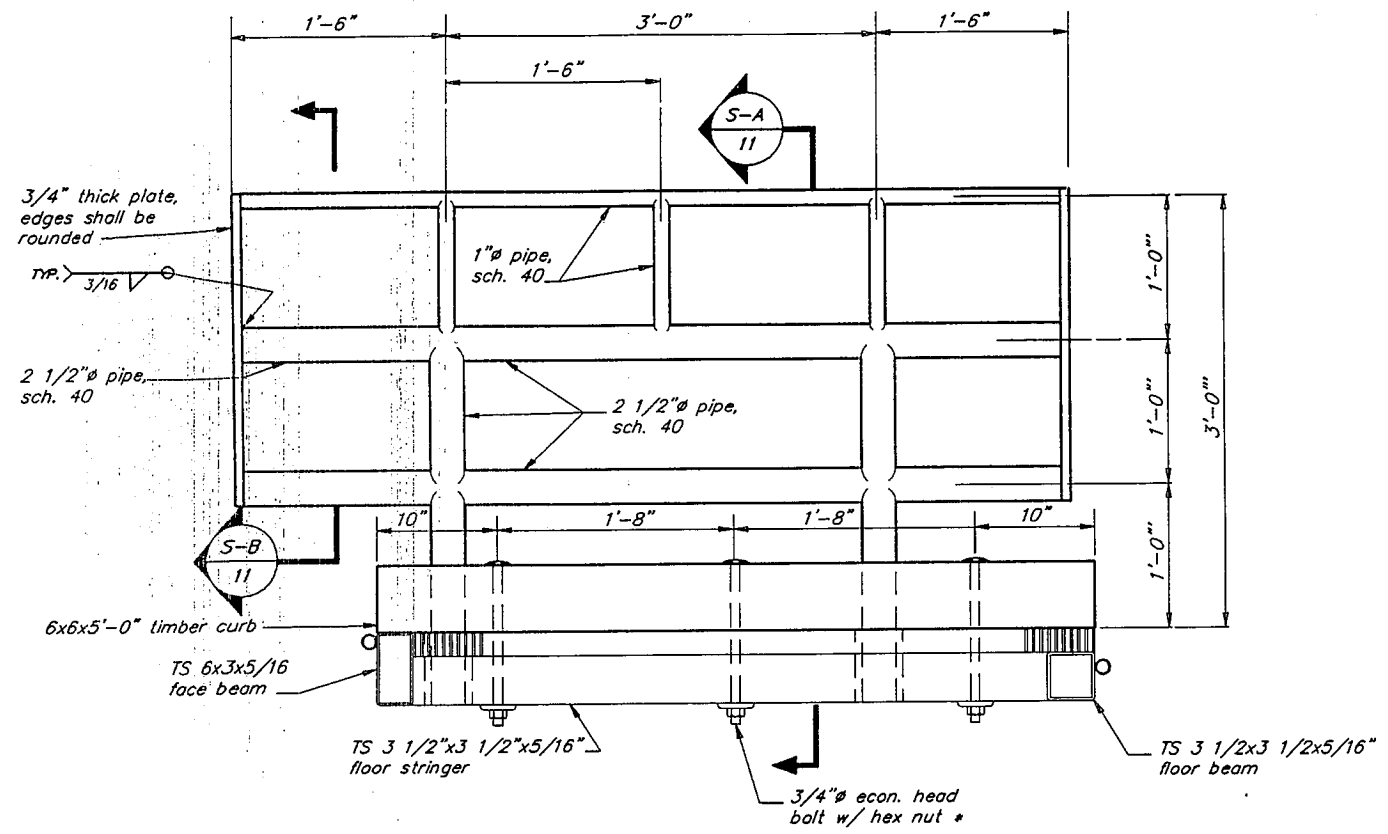


RAILING DETAIL 1

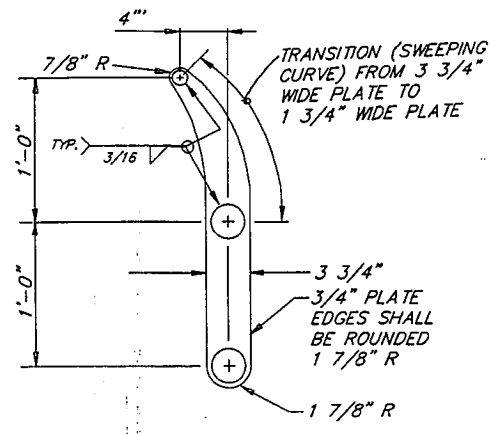


SECTION B

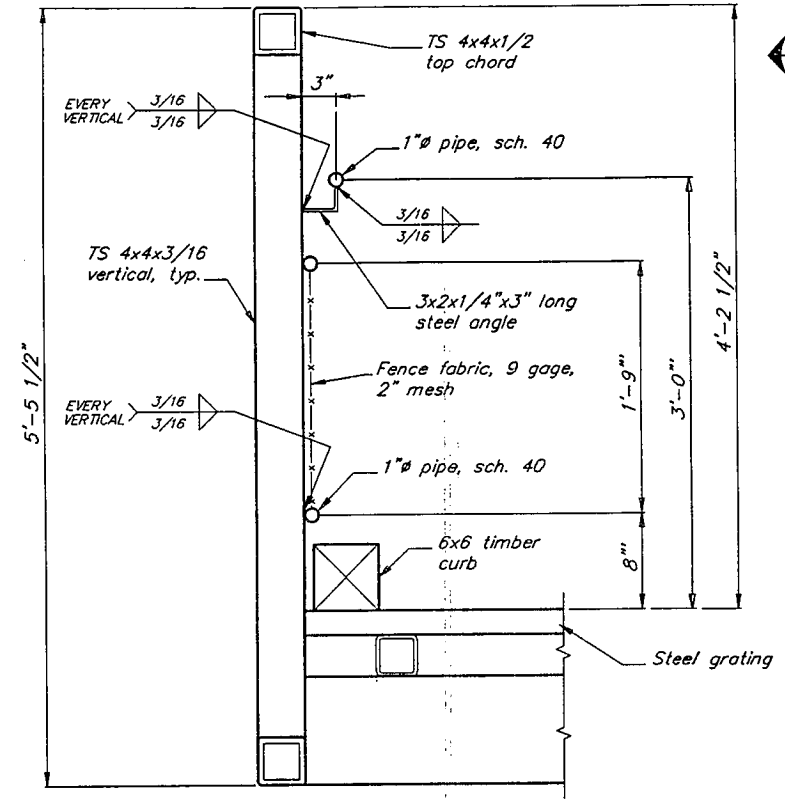


GANGWAY RAILING DETAIL 2

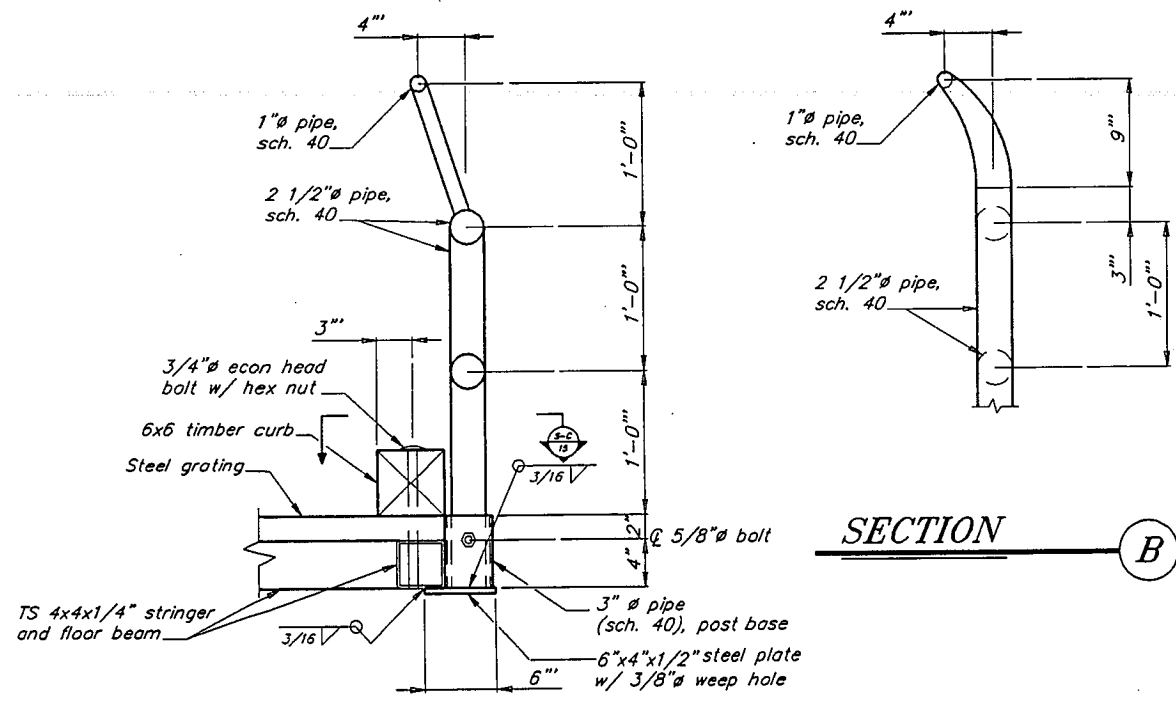

SECTION A

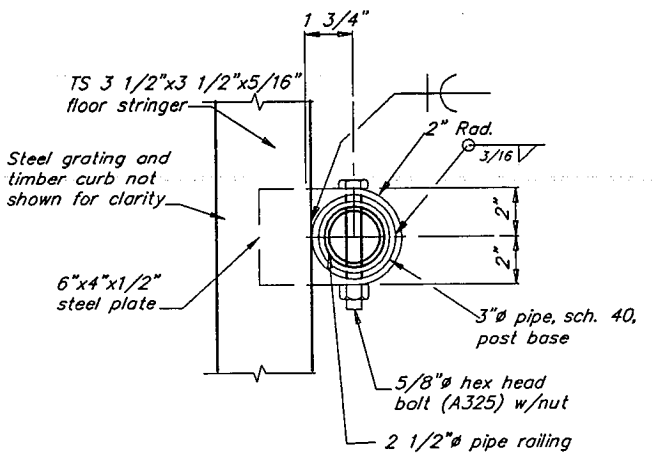

SECTION C

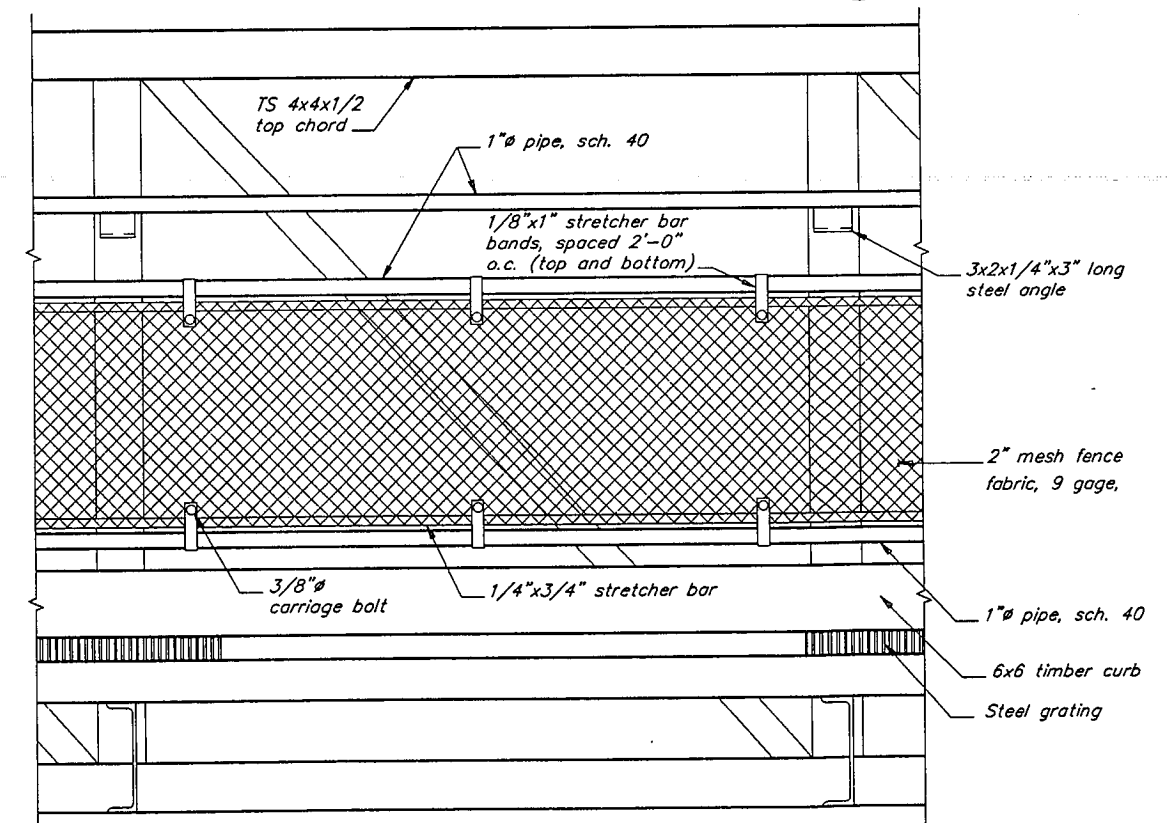

SECTION D

PATH: P:\CRG\SEAPLY\DR\SH111.dwg <1=8>		
BY	DATE	DESCRIPTION OF CHANGE


RECORD OF REVISIONS





STATE OF ALASKA
 DEPARTMENT OF TRANSPORTATION
 AND PUBLIC FACILITIES
 SOUTHEAST REGION DESIGN & CONSTRUCTION

CRAIG
 CRAIG SEAPLANE BASE EXPANSION
 A.I.P # 3-02-0071-01
RAILING DETAILS



ALASKA
 DESIGNED BY: D.D.S.
 DRAWN BY: B.W.B.
 CHECKED BY: C.A.B.

PROJECT No. 69956
 DATE: JULY 1994
 SHEET 11 OF 60

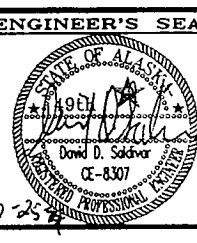

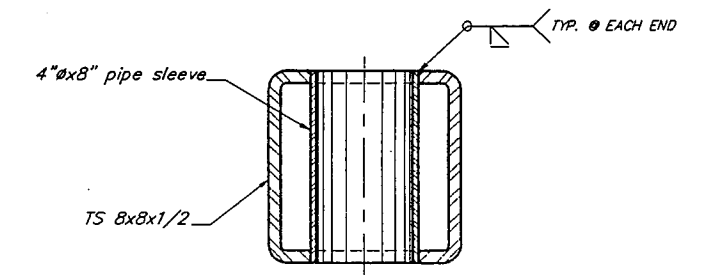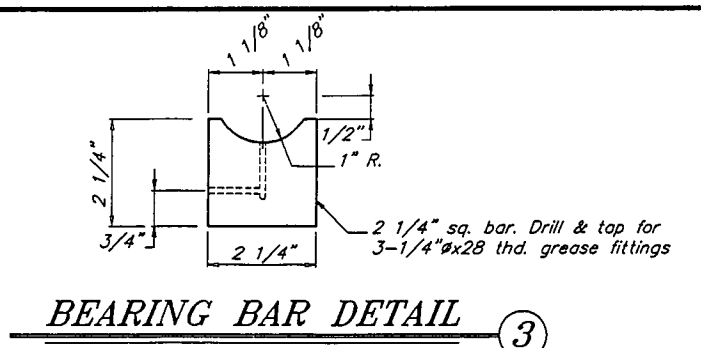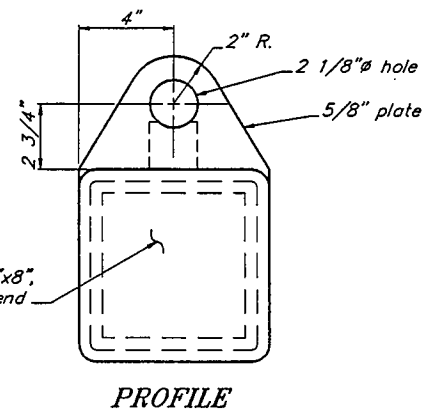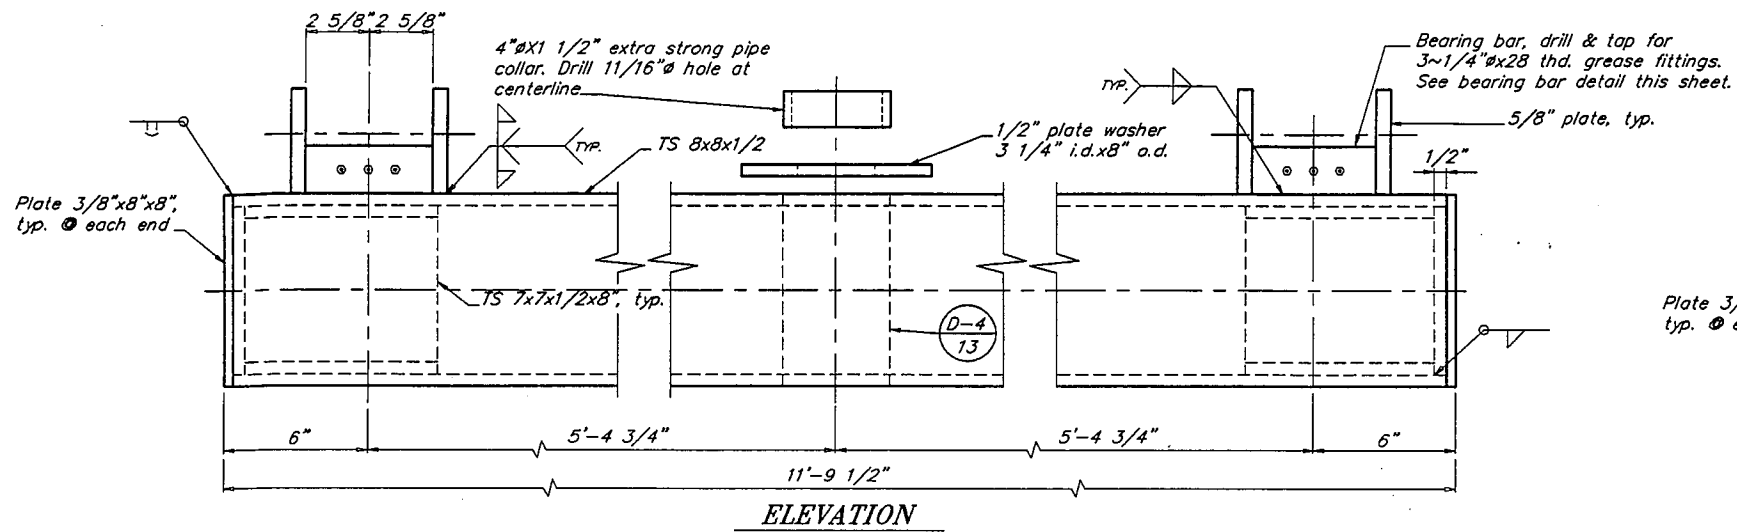

HINGE / WELDMENT DETAIL ①

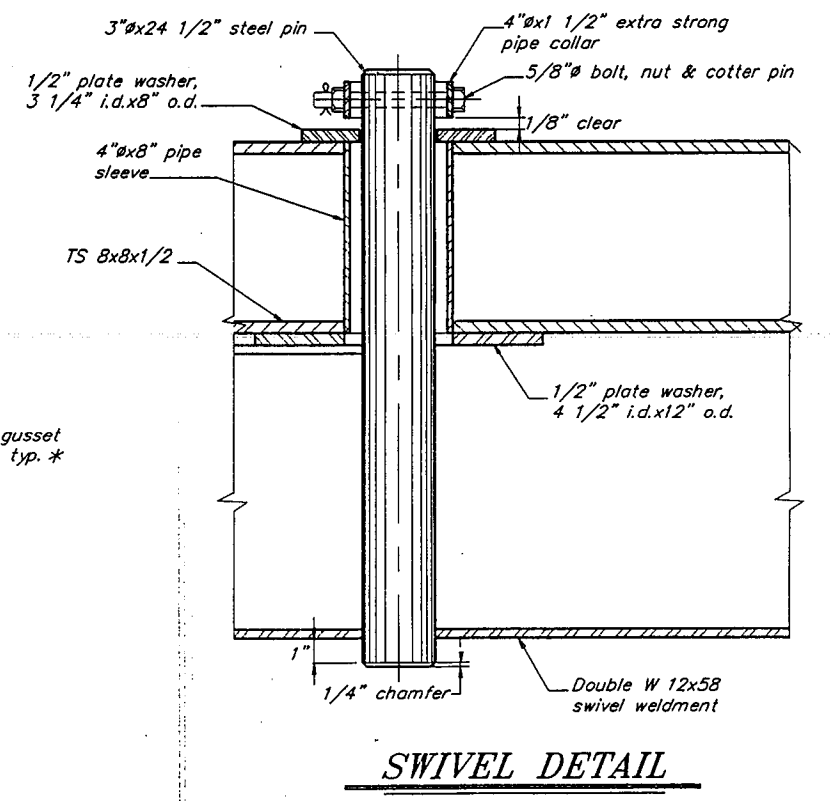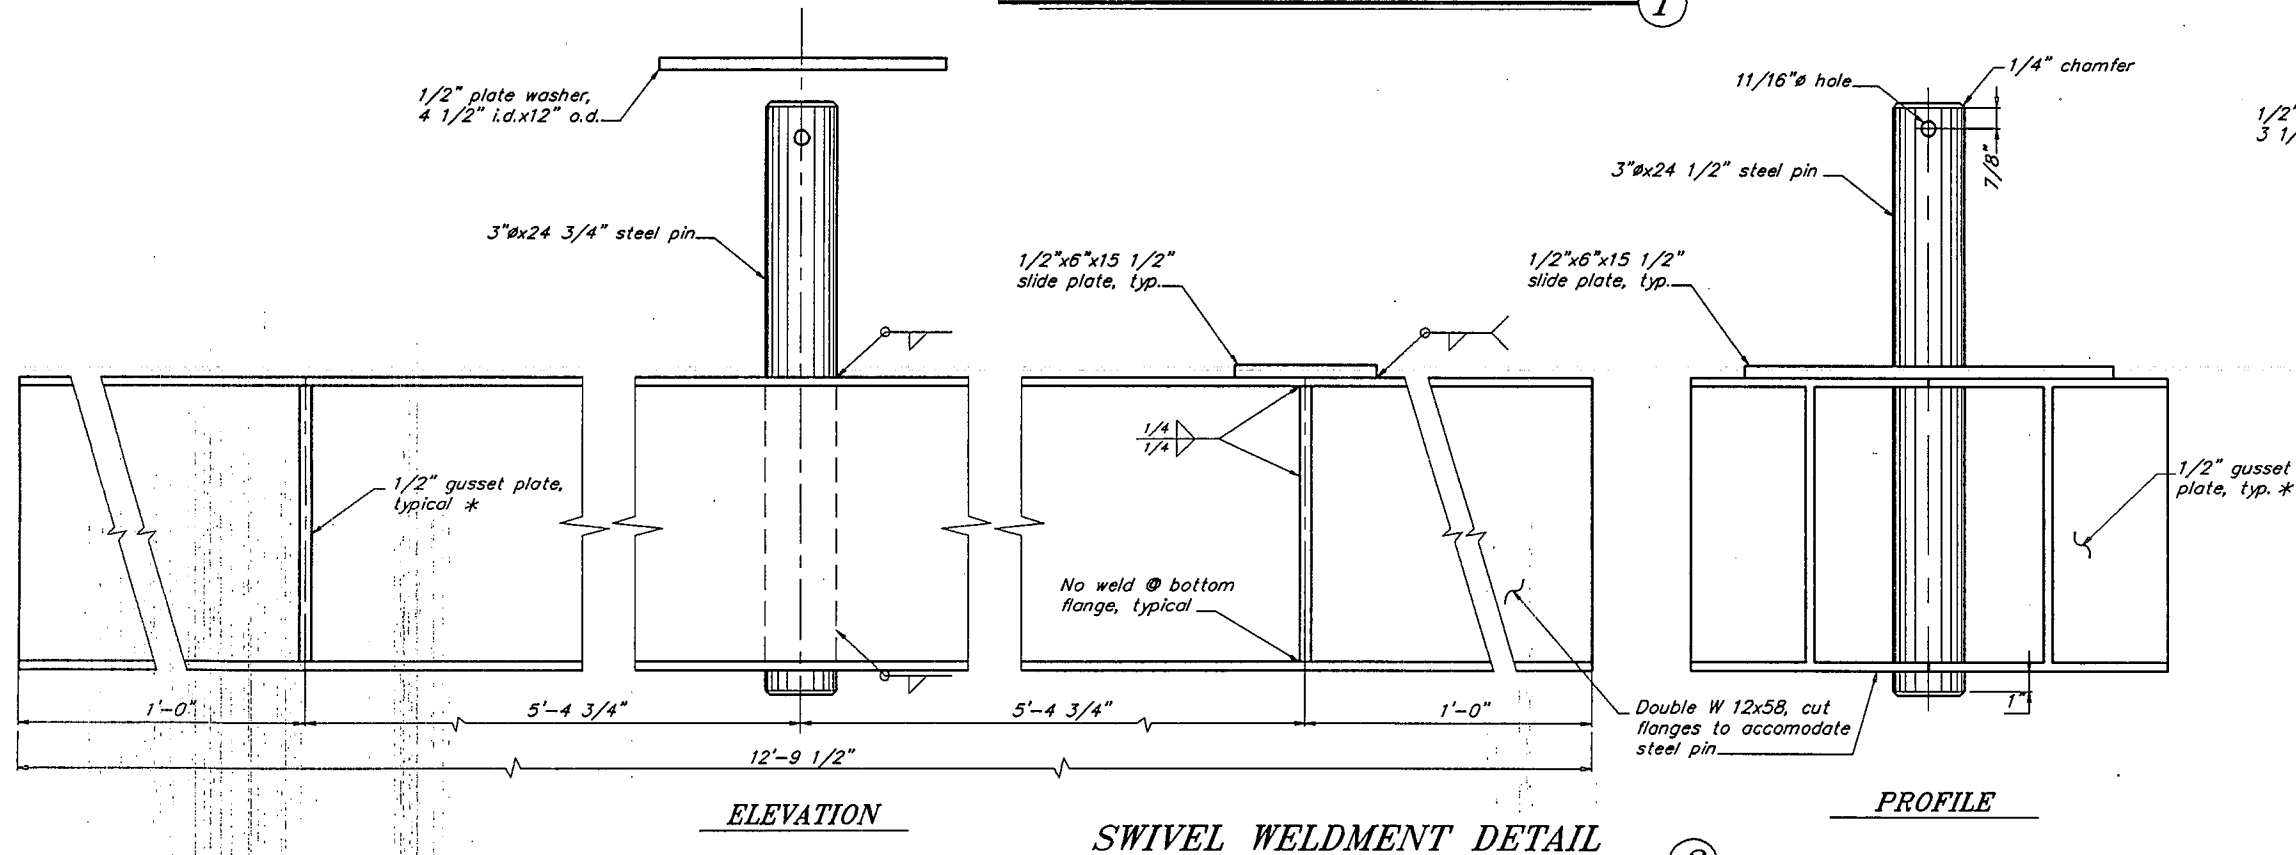

SWIVEL WELDMENT DETAIL ②

* Cope edges for weld clearance. Gusset plate to have a snug fit at bottom flange, do not weld to bottom flange.


PATH : P:\CRG\SEARCH\DR\GMDTS.dwg <14>		
BY	DATE	DESCRIPTION OF CHANGE


RECORD OF REVISIONS

STATE OF ALASKA
DEPARTMENT OF TRANSPORTATION
AND PUBLIC FACILITIES
SOUTHEAST REGION DESIGN & CONSTRUCTION

CRAIG
CRAIG SEAPLANE BASE EXPANSION
A.I.P. # 3-02-0071-01
ALASKA
GANGWAY CONNECTION DETAILS

DESIGNED BY: D.D.S.	PROJECT No. 69958
DRAWN BY: B.W.B.	DATE: JULY 1994
CHECKED BY: C.A.B.	SHEET 13 OF 60

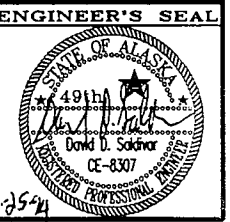

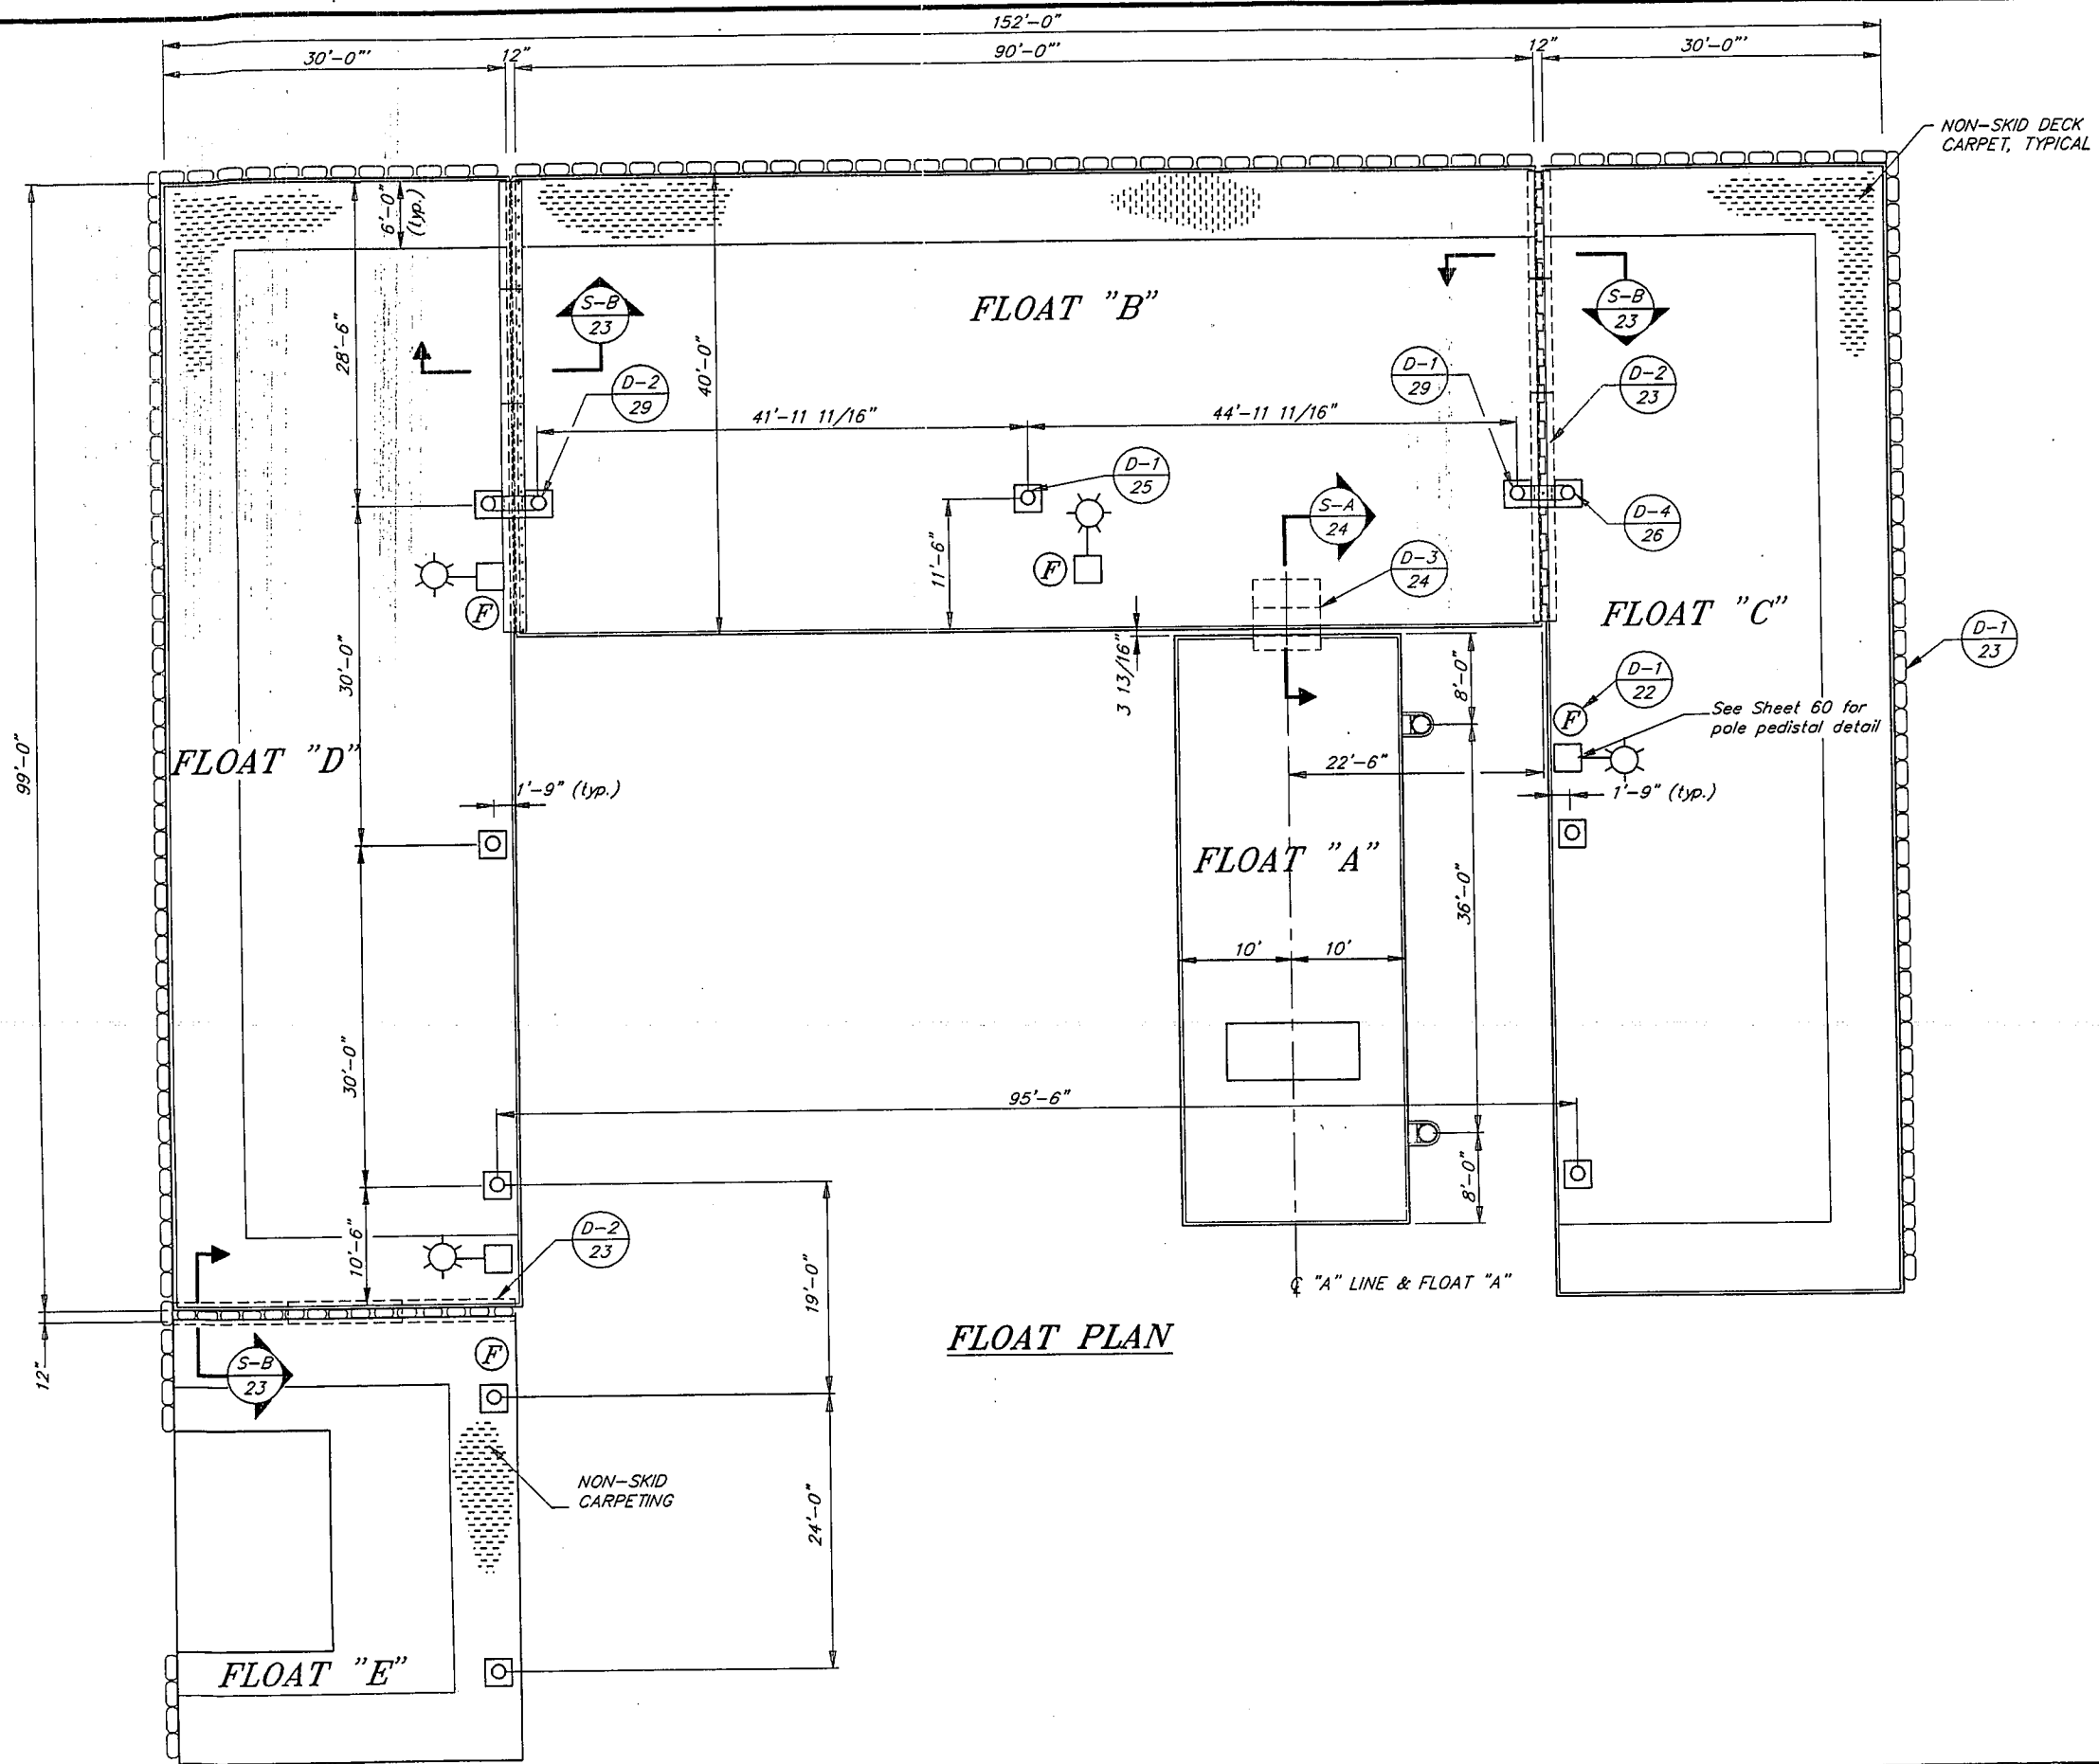

- NOTES:**
1. STEEL COVER PLATE BETWEEN FLOAT "B" & "C" AND BETWEEN FLOAT "B" & "D" SHALL BE TYPE "A" AS SHOWN ON SHEET 23 EXCEPT AT THE PILE LOCATION TYPE "B" SHALL BE USED.
 2. STEEL COVER PLATE BETWEEN FLOAT "D" & "E" SHALL BE TYPE "A" AS SHOWN ON SHEET 23.
 3. SEE WIND CONE DETAILS ON SHEET 25 AND SIGN DETAILS ON SHEET 29.
 4. STEEL FLOAT PILES FOR FLOATS, "A", "B", "C", "D" AND "E" SHALL BE 16"Ø x 1/2" WALL
 5. THE CONTRACTOR SHALL BE REQUIRED TO COORDINATE THE ASSEMBLY OF THE FLOATS AND THE INSTALLATION OF THE ELECTRICAL LIGHTING SYSTEM TO AVOID CONFLICTS. THE CONTRACTOR WILL NOT BE ALLOWED TO REMOVE FLOAT DECKING TO INSTALL THE ELECTRICAL LIGHTING SYSTEM. THE WIRING SYSTEM FOR THE LIGHTING SHALL BE INSTALLED DURING FLOAT ASSEMBLY.

FLOAT PLAN

PATH: P:\CRG\SEAPL\DR\FLOATPLAN.dwg < 1-96 >

BY	DATE	DESCRIPTION OF CHANGE


RECORD OF REVISIONS



STATE OF ALASKA
 DEPARTMENT OF TRANSPORTATION
 AND PUBLIC FACILITIES
 SOUTHEAST REGION DESIGN & CONSTRUCTION

CRAIG

CRAIG SEAPLANE BASE EXPANSION
 A.I.P. # 3-02-0071-01
FLOAT PLAN


ALASKA	DESIGNED BY: D.D.S.	PROJECT No. 69956
	DRAWN BY: C.S.A./B.W.B.	DATE: JULY 1994
	CHECKED BY: M.H.	SHEET 14 OF 60

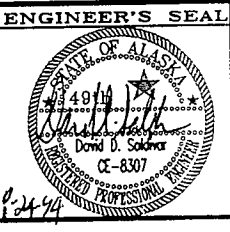

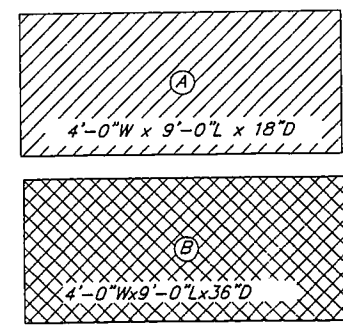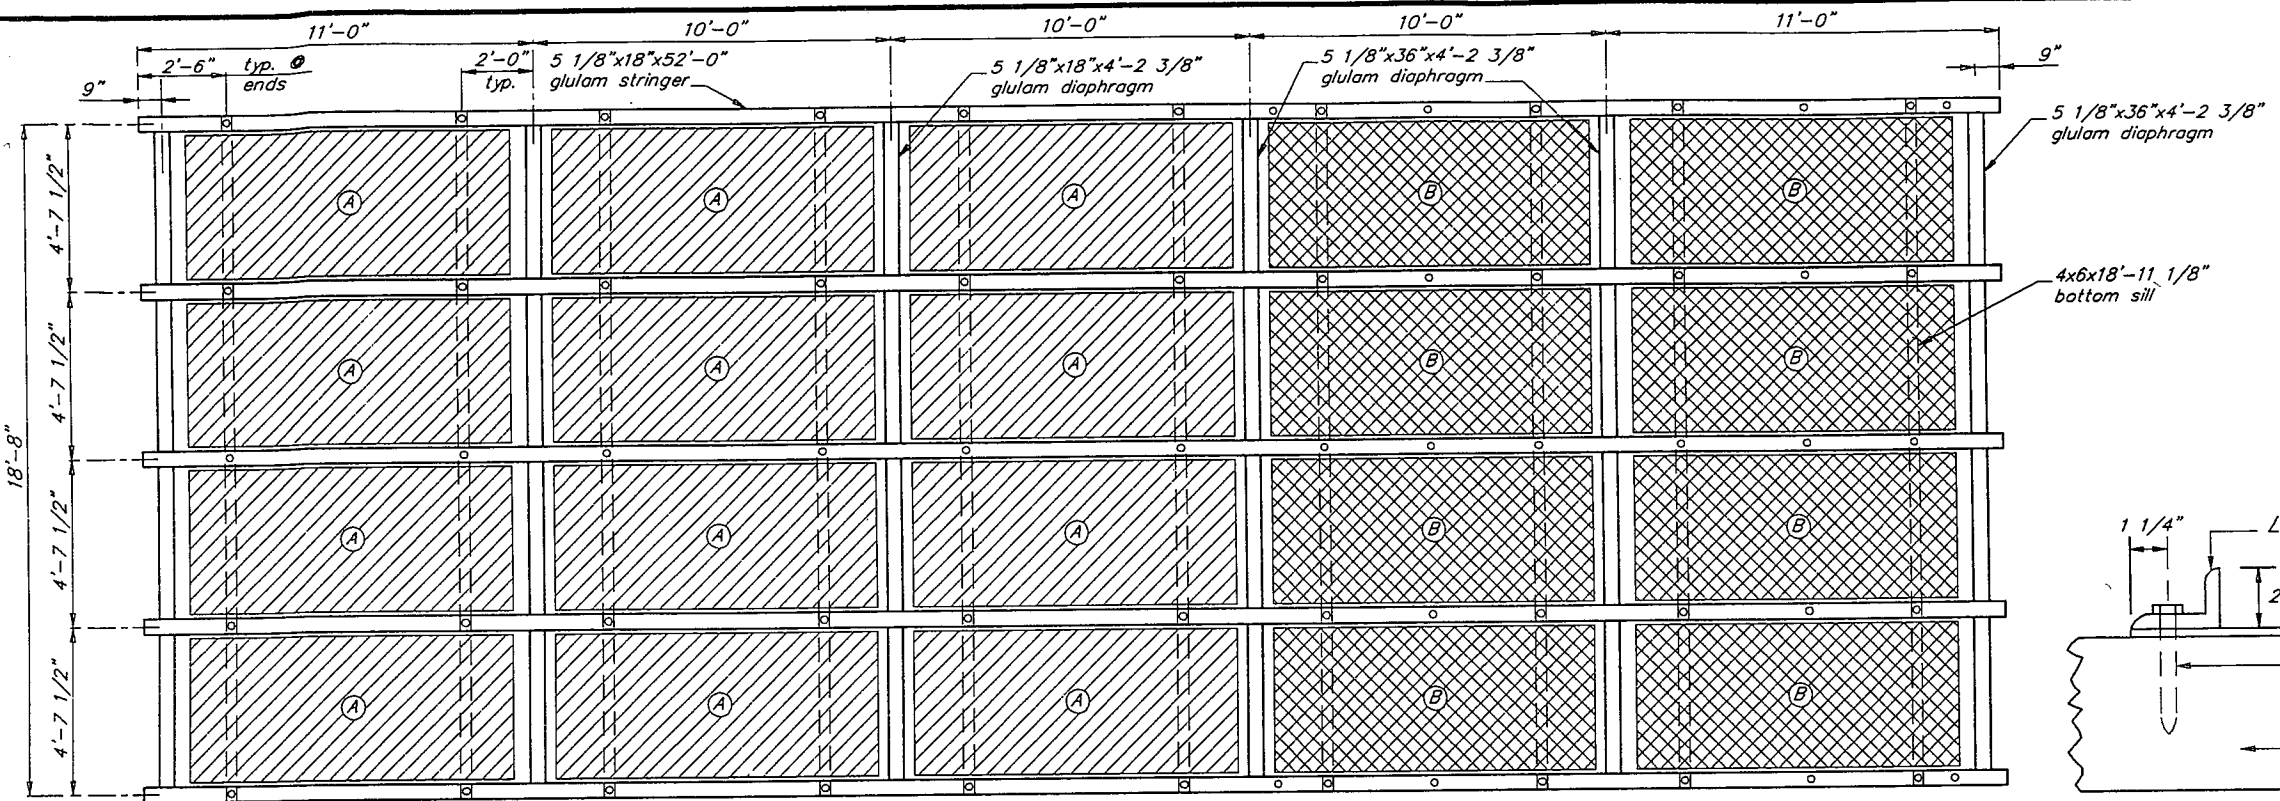

NOTE: Flotation size includes coating thickness.

FLOTATION BILLETS


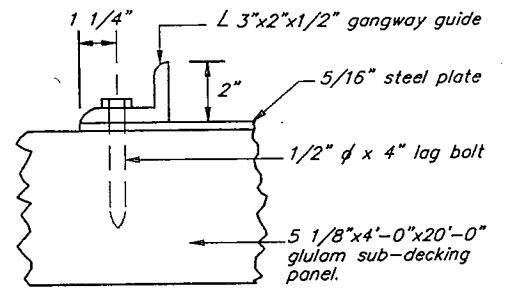


DECKING NOTES:

- 2x10 S1S2E milled decking shall be spaced 1/4" apart and secure w/ 20d galv. box nails. Pre-drill to prevent splitting if required.
- Milled side of 2x10 decking shall be toward inside of tree.
- See Detail 2 on Sheet 16 for nailing pattern.
- See Detail 6 on Sheet 16 for 2x10 milled decking detail.

FRAMING PLAN

SECTION C

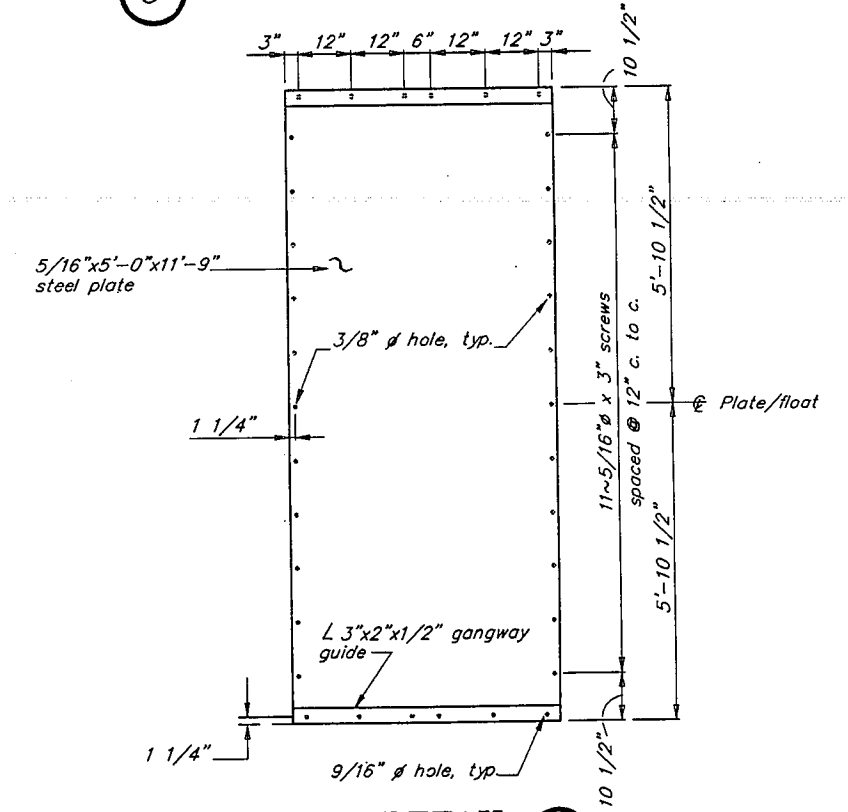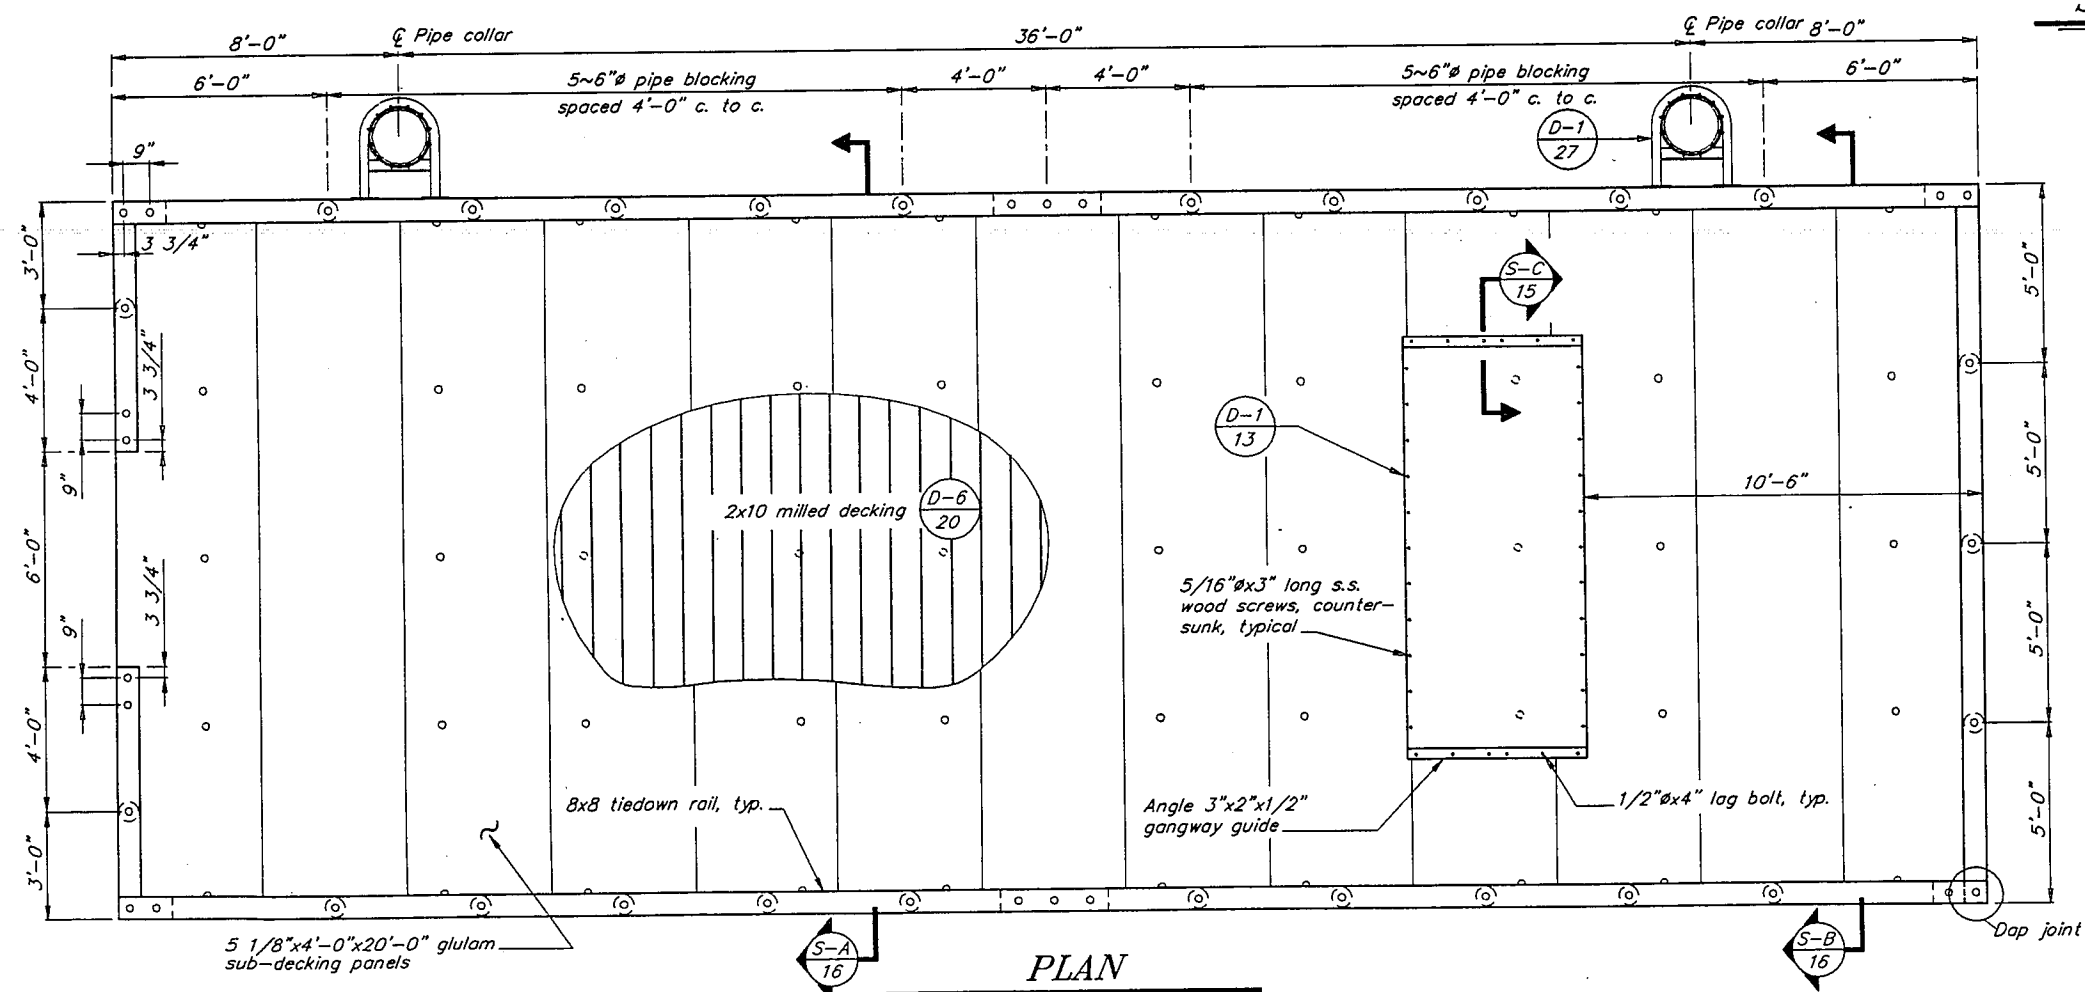


SLIDE PLATE DETAIL 1


BY	DATE	DESCRIPTION OF CHANGE
PATH: P:\CRG\SEAFL\DR\SH115.dwg < 1=32 >		

STATE OF ALASKA
DEPARTMENT OF TRANSPORTATION
AND PUBLIC FACILITIES
SOUTHEAST REGION DESIGN & CONSTRUCTION


CRAIG
CRAIG SEAPLANE BASE EXPANSION
A.I.P # 3-02-0071-01
SEAPLANE FLOAT "C" & "D" - SECTIONS

ALASKA	DESIGNED BY: D.D.S.	PROJECT No. 69958
	DRAWN BY: B.W.B.	DATE: JULY 1994
	CHECKED BY: D.D.S.	SHEET 15 OF 60

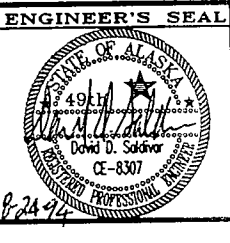


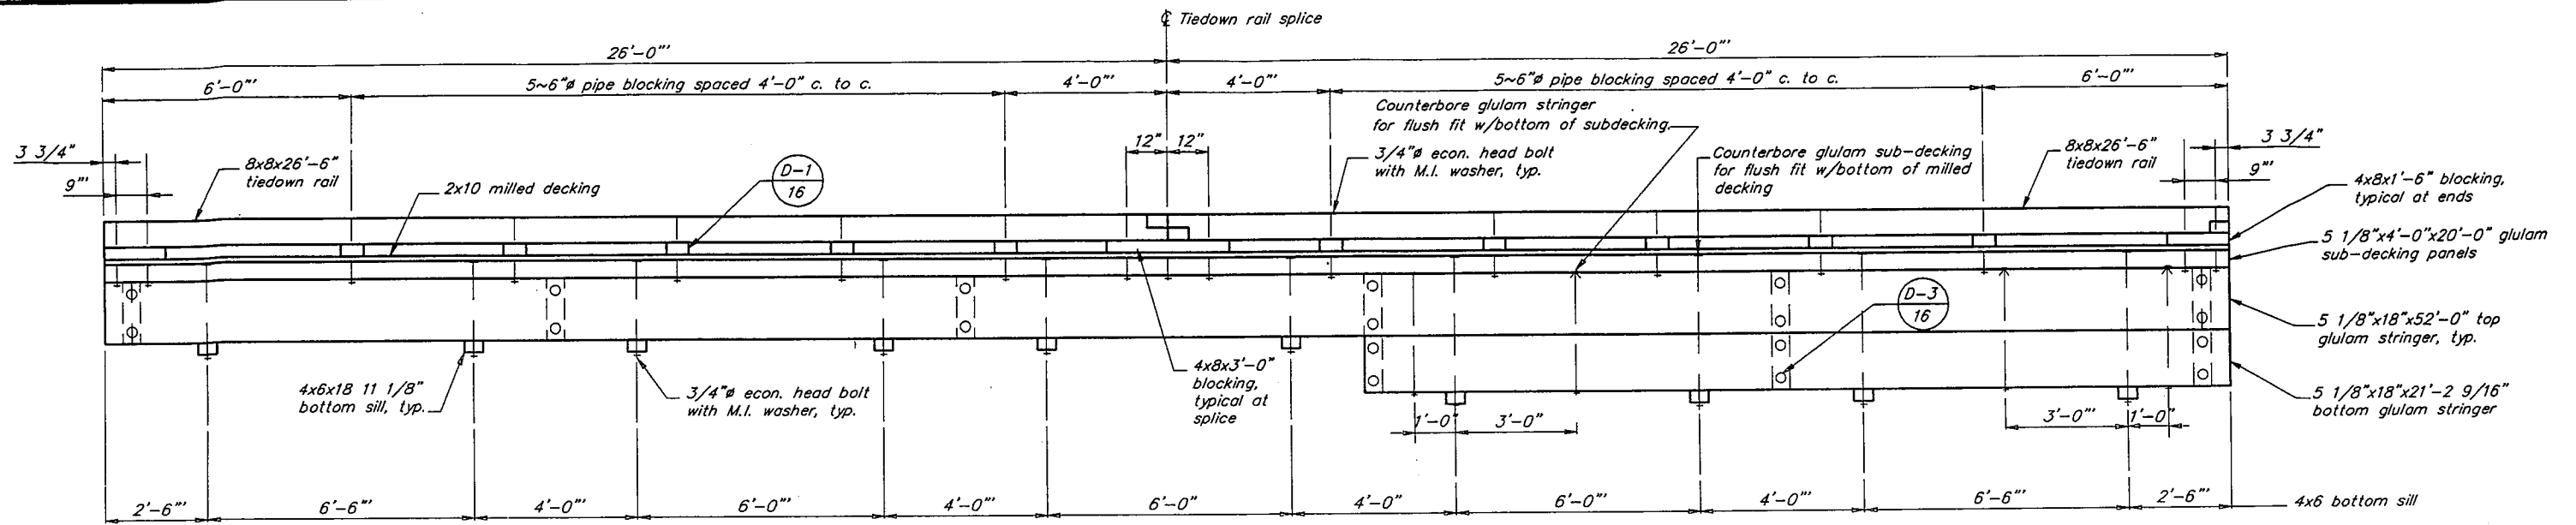

ELEVATION

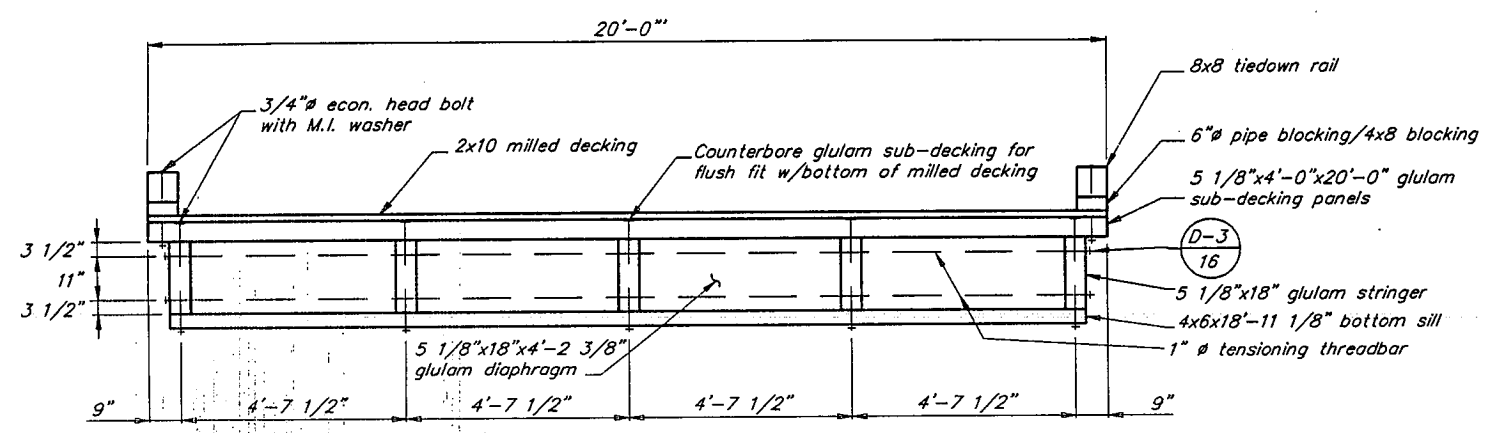





SECTION A

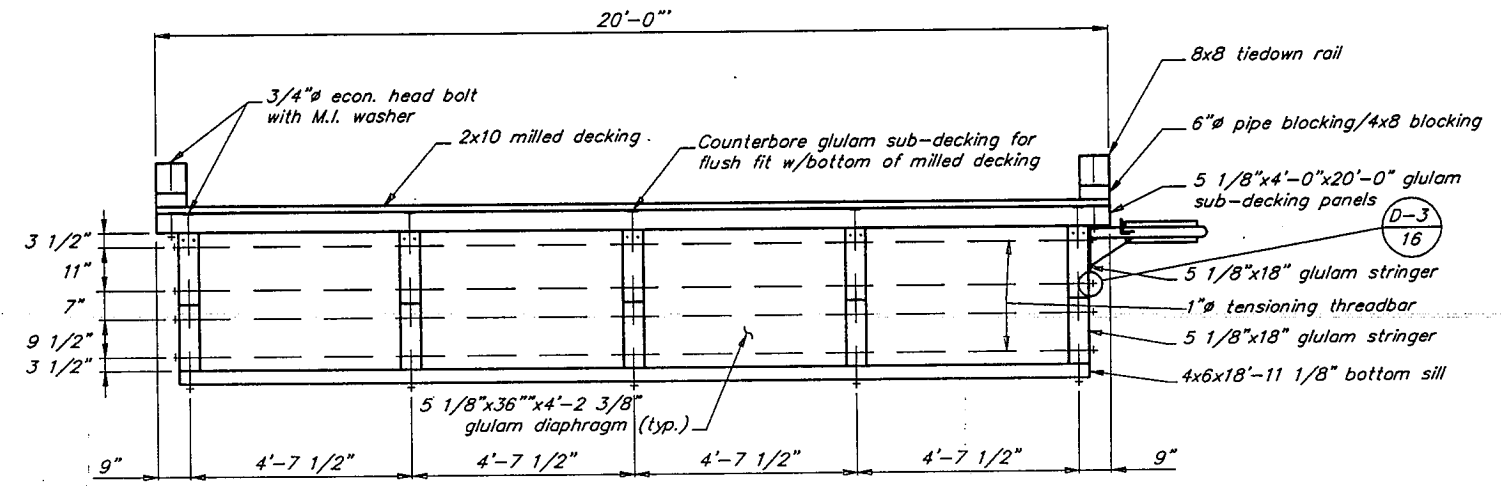

SECTION B

NOTE:

Glulam sub-decking shall be combination 5
Glulam stringers and diaphragm shall be 24F-4.

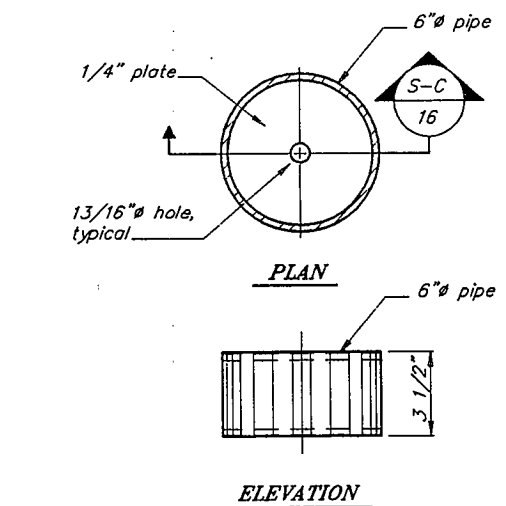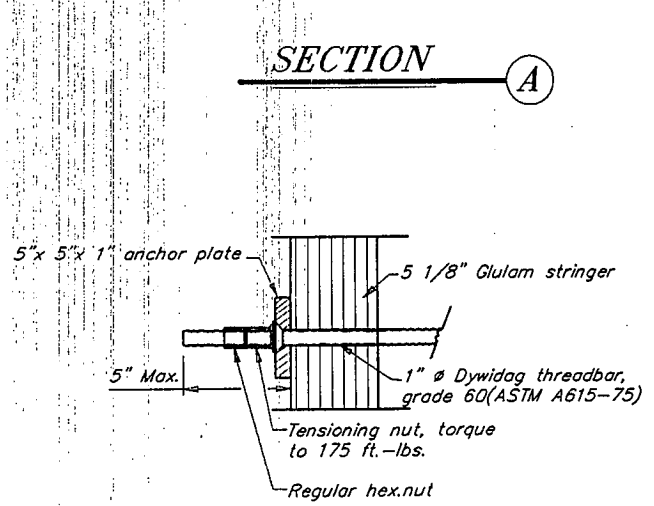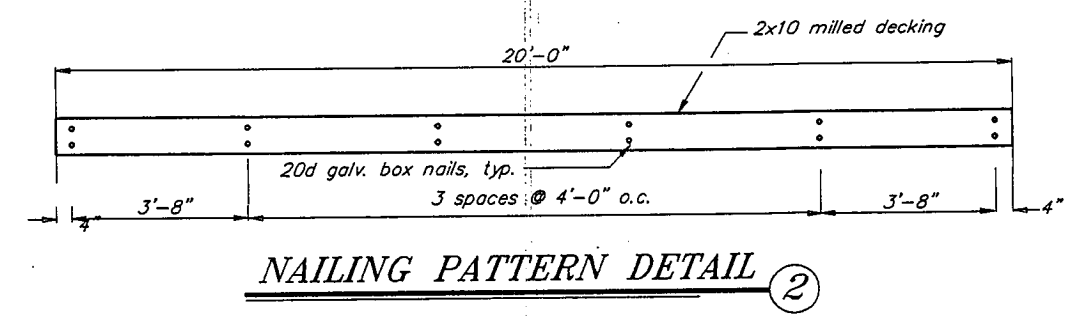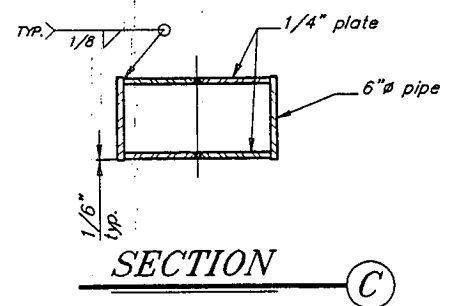

TENSIONING THREADBAR DETAIL


PIPE BLOCKING DETAILS


RECORD OF REVISIONS		
BY	DATE	DESCRIPTION OF CHANGE

STATE OF ALASKA
DEPARTMENT OF TRANSPORTATION
AND PUBLIC FACILITIES
SOUTHEAST REGION DESIGN & CONSTRUCTION


CRAIG
CRAIG SEAPLANE BASE EXPANSION
A.I.P. # 3-02-0071-01
GANGWAY FLOAT "A" - ELEVATION & SECTIONS

ALASKA	DESIGNED BY: D.D.S.	PROJECT No. 69958
	DRAWN BY: B.W.B.	DATE: JULY 1994
	CHECKED BY: C.A.B.	SHEET 16 OF 60

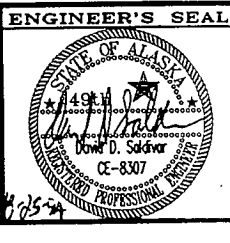


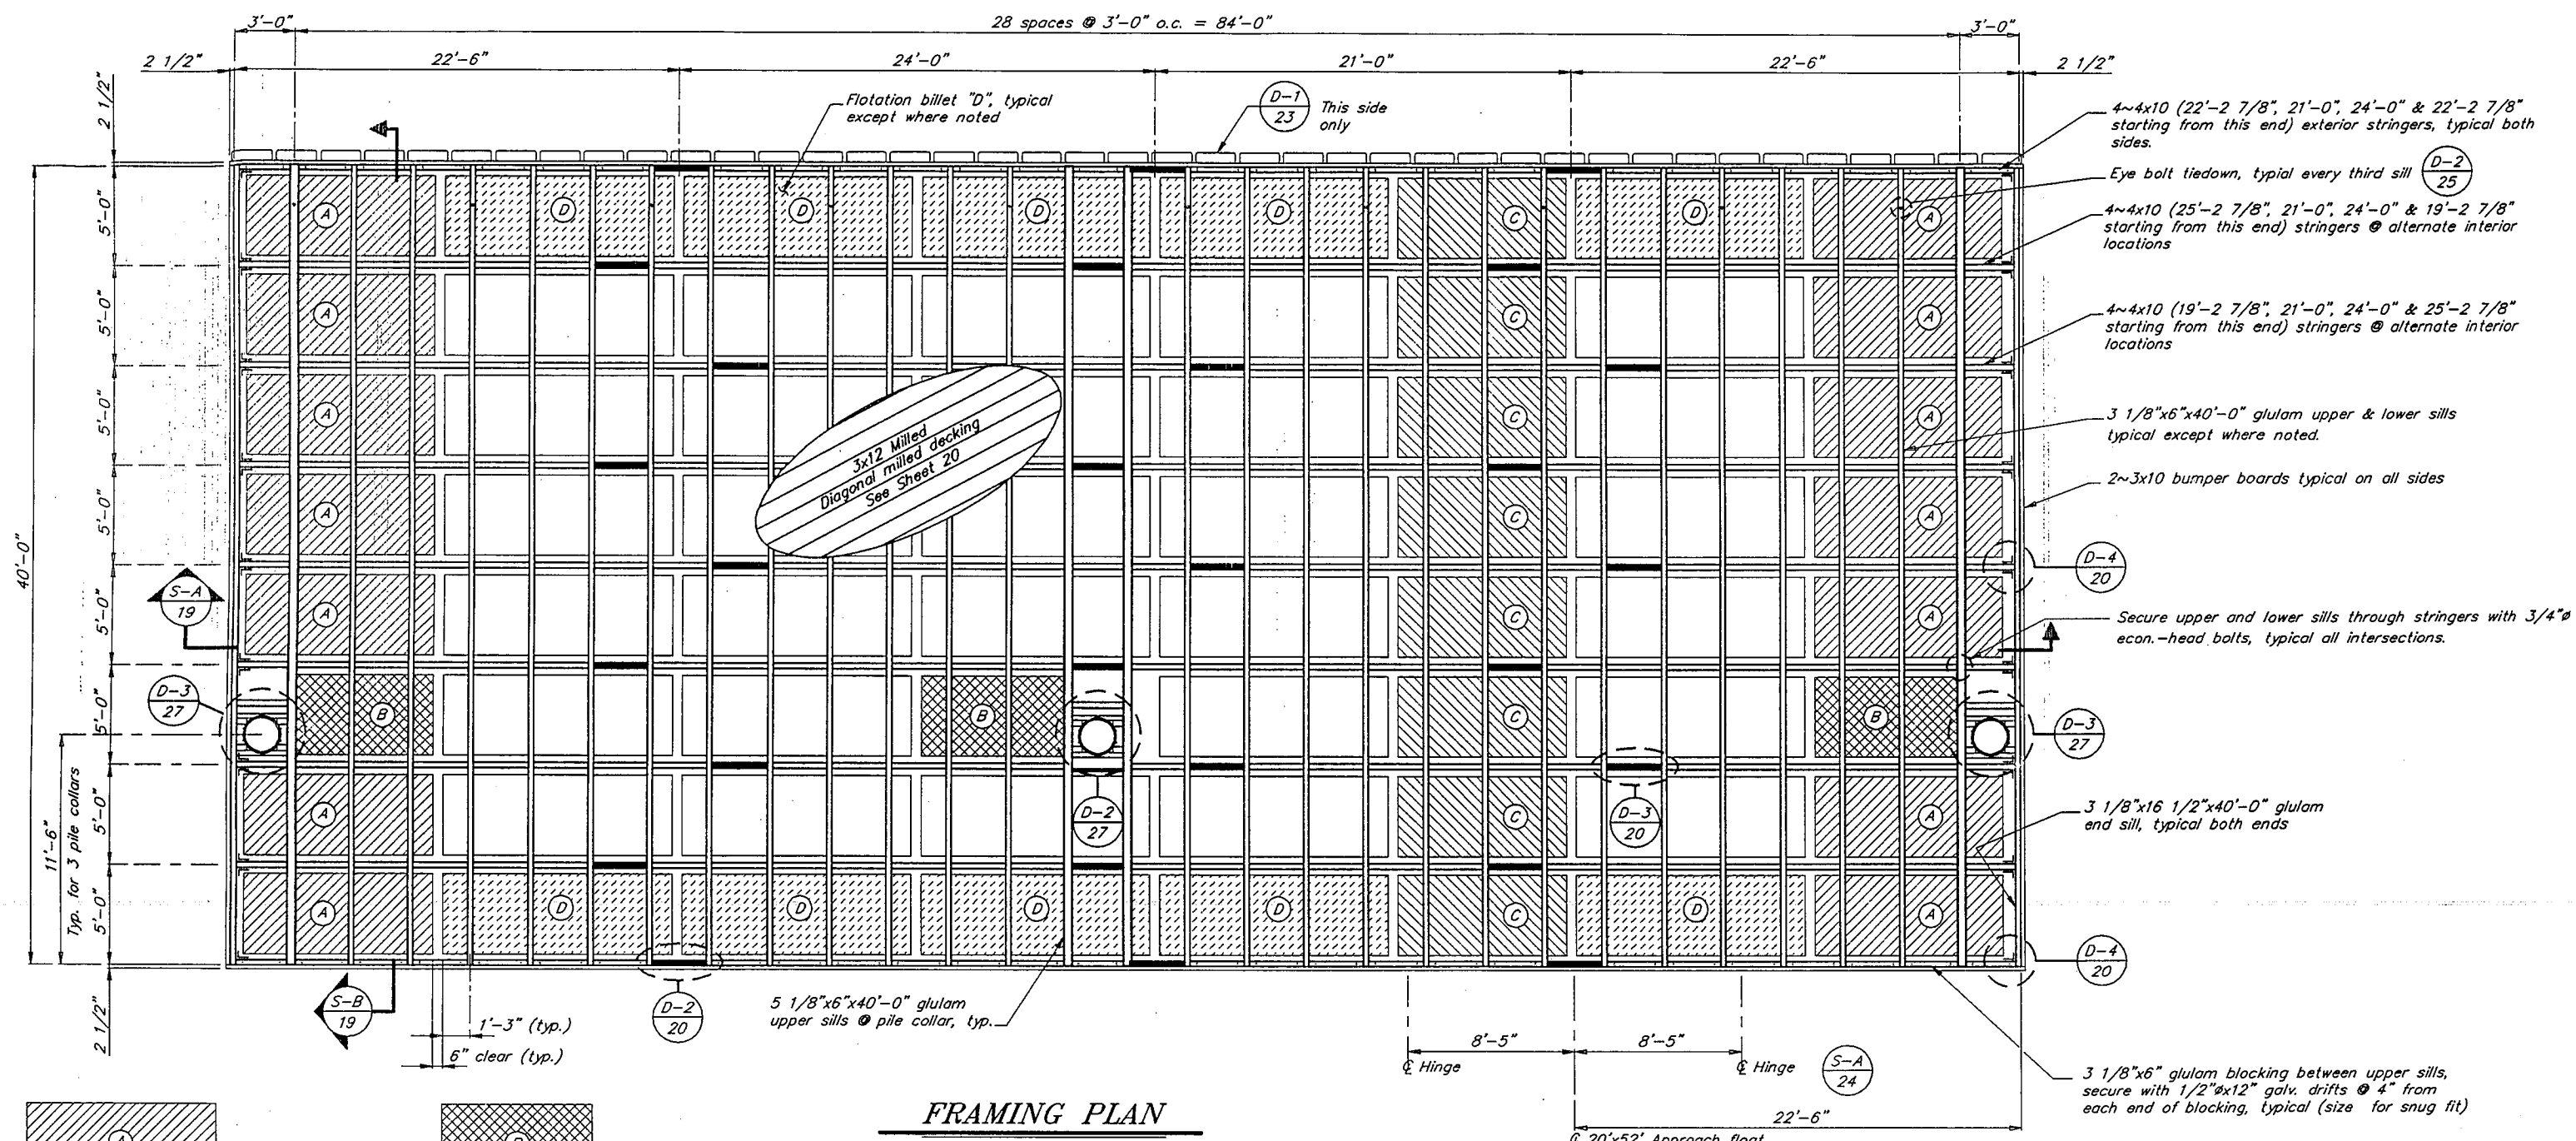


FRAMING PLAN

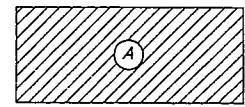


4'-0" x 9'-6" x 9 1/4" (14 required)

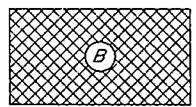

4'-0" x 7'-6" x 9 1/4" (3 required)

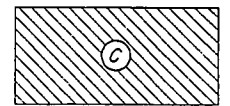

4'-0" x 8'-6" x 9 1/4" (8 required)

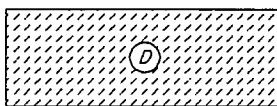

4'-0" x 11'-6" x 9 1/4" (39 required)

NOTE: Flotation size includes coating thickness.

GENERAL NOTES:

1. Apply non-skid deck carpet to decking at locations indicated on sheet 14.
2. Sills shall be full length members, no splicing will be allowed.
3. Bumper board minimum length is 10'-0". Secure bumper boards with 60d double hot dipped galvanized nails, staggered at 12" o.c. and 2~nails at ends.
4. 4x10 stringers shall be S4S.

DECKING NOTES:

1. 3x12 S1S2E milled decking spaced 1/4" apart.
2. Apply 3x12 decking diagonally. Secure to every sill with 2~60d double hot dipped galvanized nails. Pre-drill at ends to prevent splitting.
3. Milled side of 3x12 shall be toward inside of tree.
4. Decking splices shall be staggered so that a minimum of every other plank is spliced on the same sill. Average deck plank shall contact 5 sills minimum. Minimum length deck shall contact 3 sills, except at corners of float. See Specifications.
5. See sheet 20 for 3x12 milled decking detail.
6. Decking shall be cut to form around the edge of the 1/2" steel ring of the pile collar.

BY	DATE	DESCRIPTION OF CHANGE
PATH : P:\CRO\SEAPL\DR\SH117.dwg < 1=48 >		

RECORD OF REVISIONS

STATE OF ALASKA
DEPARTMENT OF TRANSPORTATION
AND PUBLIC FACILITIES
SOUTHEAST REGION DESIGN & CONSTRUCTION


CRAIG


CRAIG SEAPLANE BASE EXPANSION
A.I.P # 3-02-0071-01
SEAPLANE FLOAT "B" - FRAMING PLAN

ALASKA


DESIGNED BY: D.D.S.
DRAWN BY: B.W.B.
CHECKED BY: C.A.B.

PROJECT No. 69956
DATE: JULY 1994
SHEET 17 OF 60

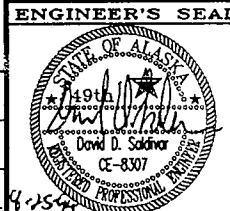

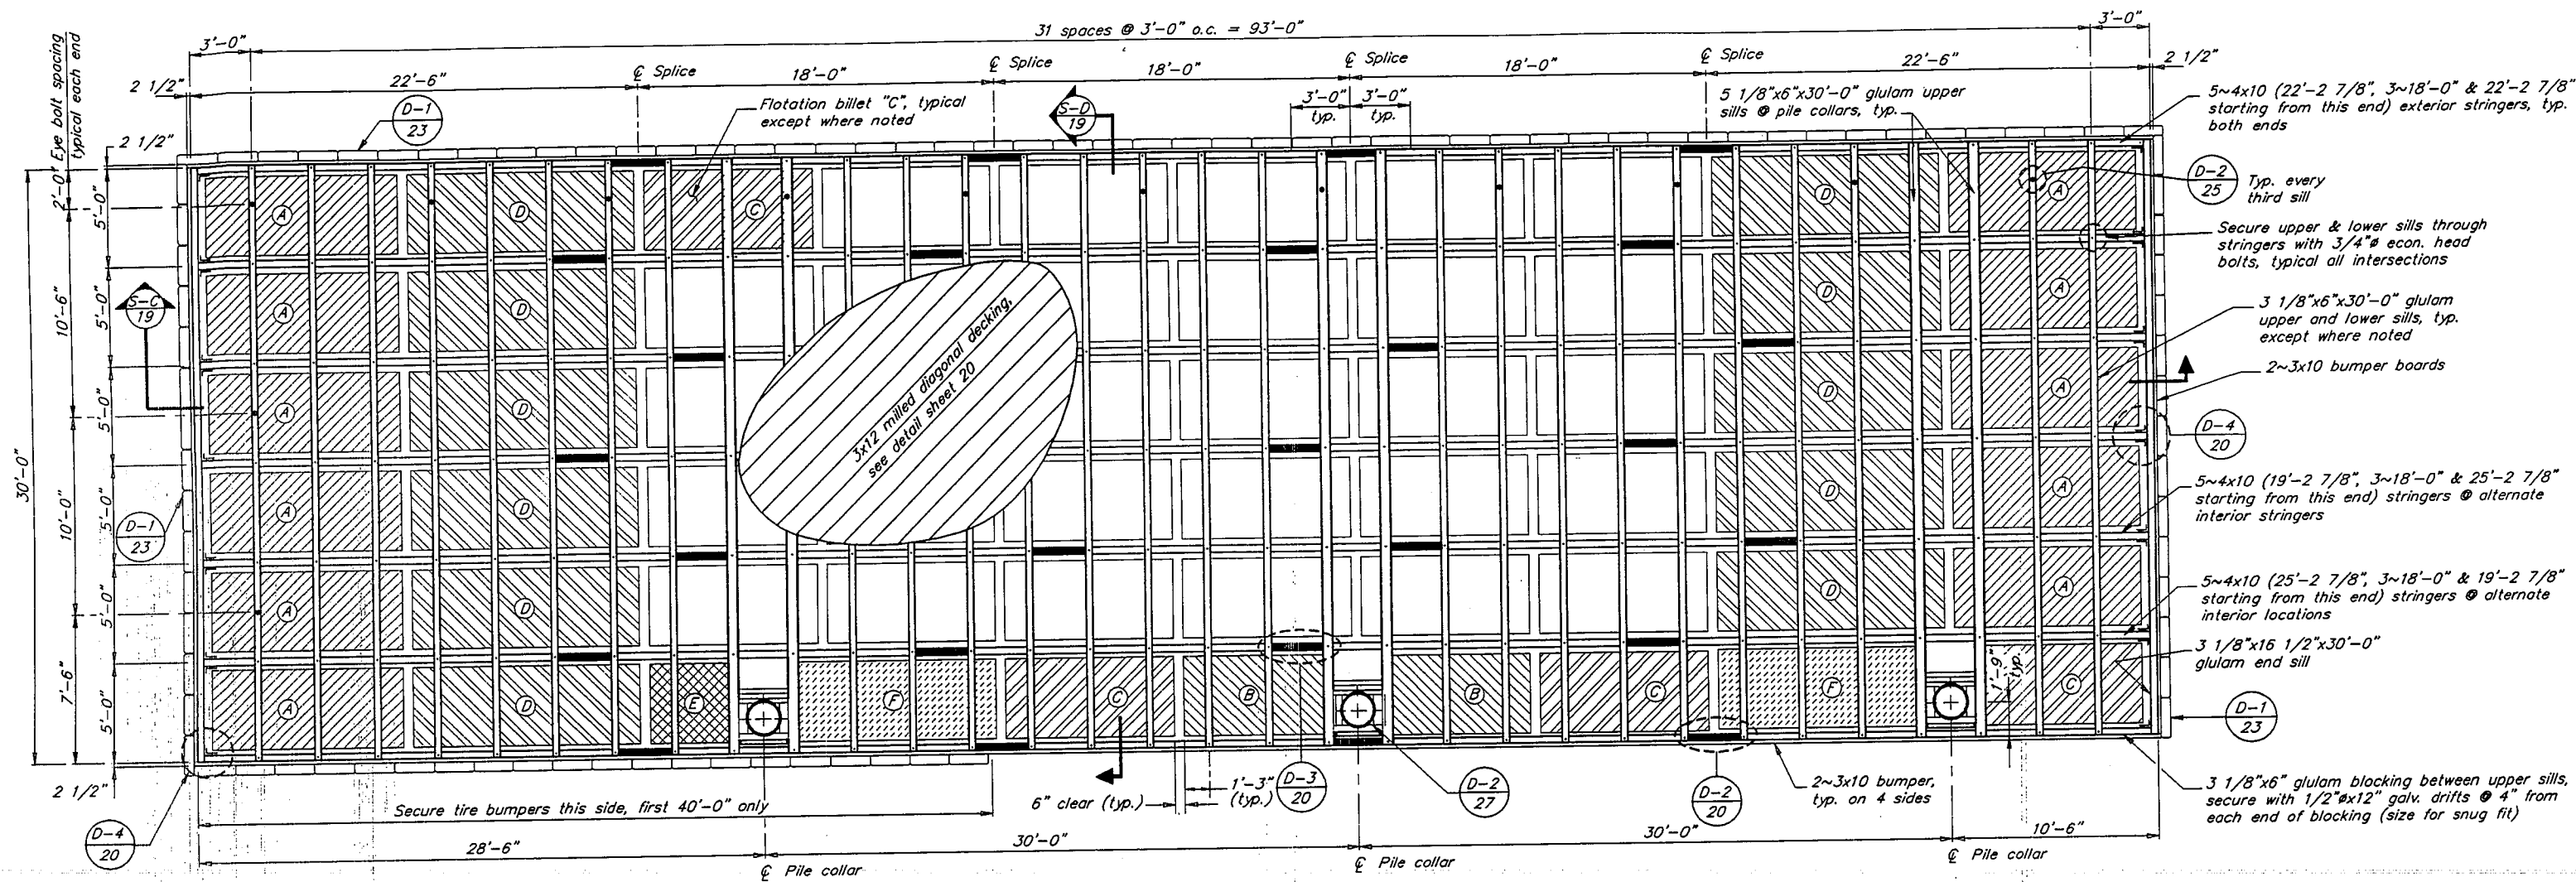

FRAMING PLAN
(Float "C" shown-Float "D" opposite hand)

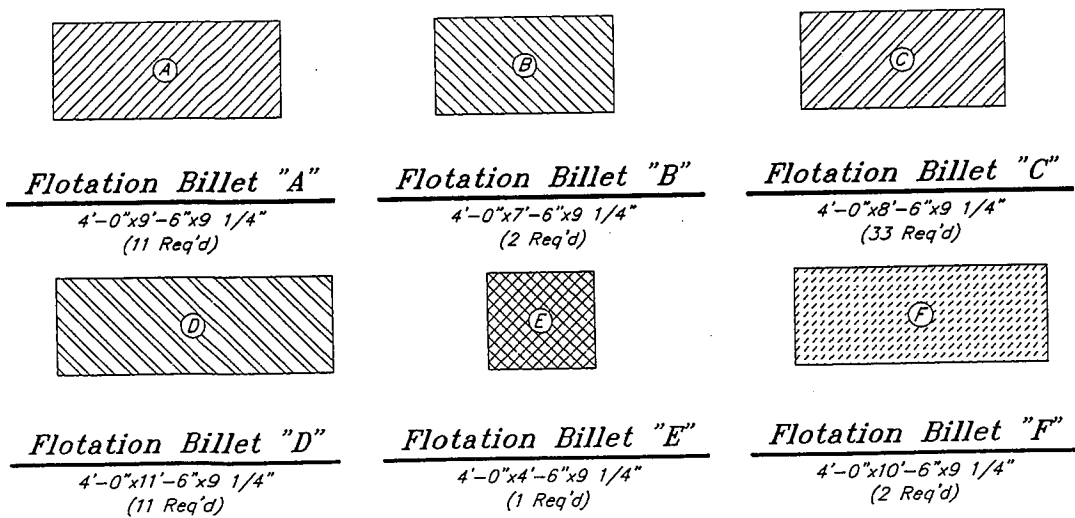

General Notes:

1. Apply non-skid deck carpet to decking as indicated on sheet 14.
2. Sills shall be full length members, no splicing will be allowed.
3. Bumper board minimum length is 10'-0". Secure bumper boards with 60d double hot dipped galvanized nails, staggered at 12" o.c. and 2~nails at ends.
4. 4x10 stringers shall be S4S.

Decking Notes:


1. 3x12 S1S2E milled decking spaced 1/4" apart.
2. Apply 3x12 decking diagonally. Secure to every sill with 2~60d double hot dipped galvanized nails. Predrill at ends to prevent splitting.
3. Milled side of 3x12 shall be toward inside of tree.
4. Decking splices shall be staggered so that only every third deck plank is spliced on the same sill. Average deck plank shall contact 5 sills minimum. Minimum length deck plank shall contact 3 sills, except at corners of float.
5. See sheet 20 for 3x12 milled decking detail.
6. Decking shall be cut to form around the edge of the 1/2" steel ring of the pile collar.





PATH: P:\CRAIG\SEAPLANE\DR\SH118.dwg < 1-48 >		
BY	DATE	DESCRIPTION OF CHANGE
RECORD OF REVISIONS		

STATE OF ALASKA
DEPARTMENT OF TRANSPORTATION
AND PUBLIC FACILITIES
SOUTHEAST REGION DESIGN & CONSTRUCTION

CRAIG
CRAIG SEAPLANE BASE EXPANSION
A.I.P. # 3-02-0071-01
SEAPLANE FLOAT "C" & "D" - FRAMING PLAN

ALASKA	DESIGNED BY: D.D.S.	PROJECT No. 69958
	DRAWN BY: B.W.B.	DATE: JULY 1994
	CHECKED BY: C.A.B.	SHEET 18 OF 60

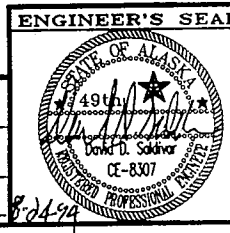

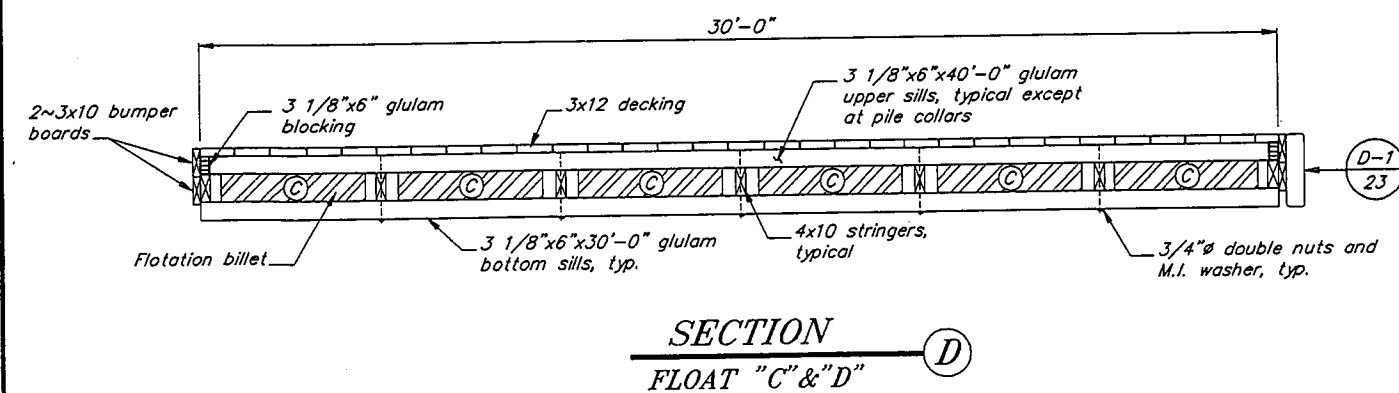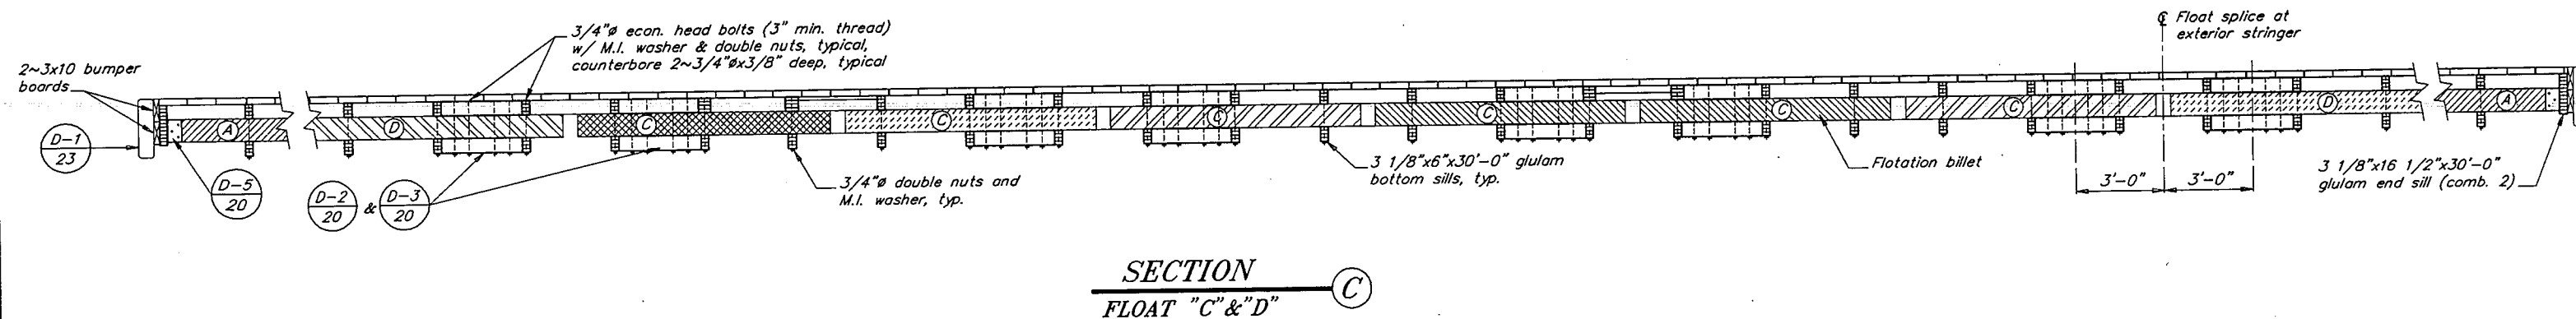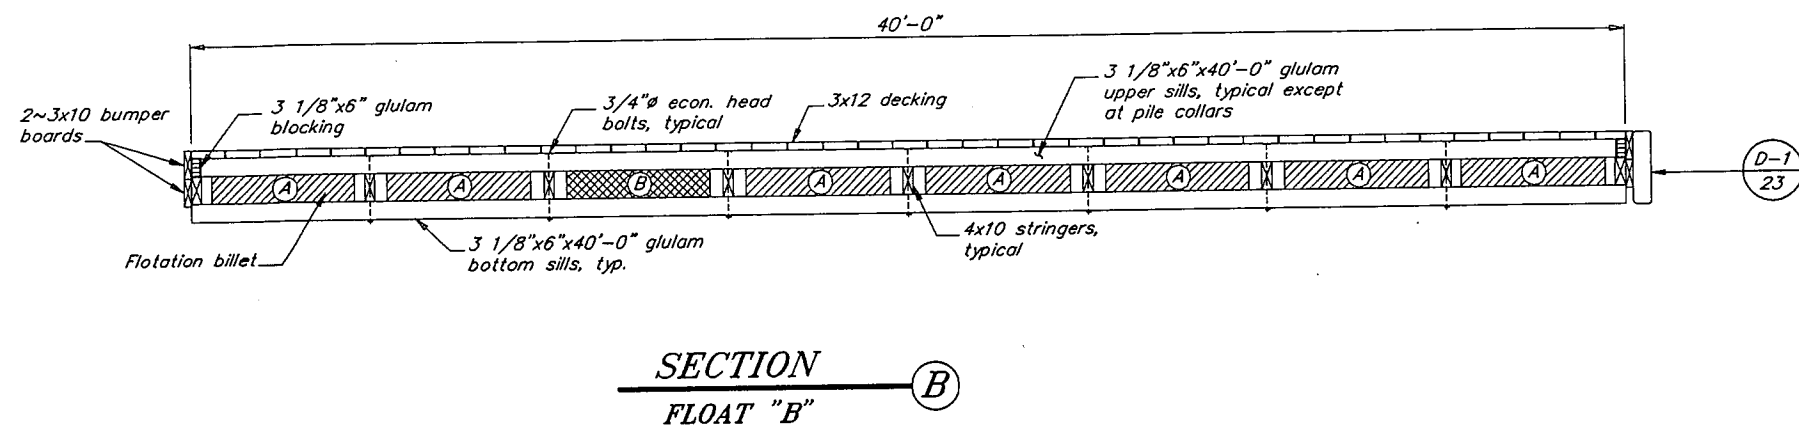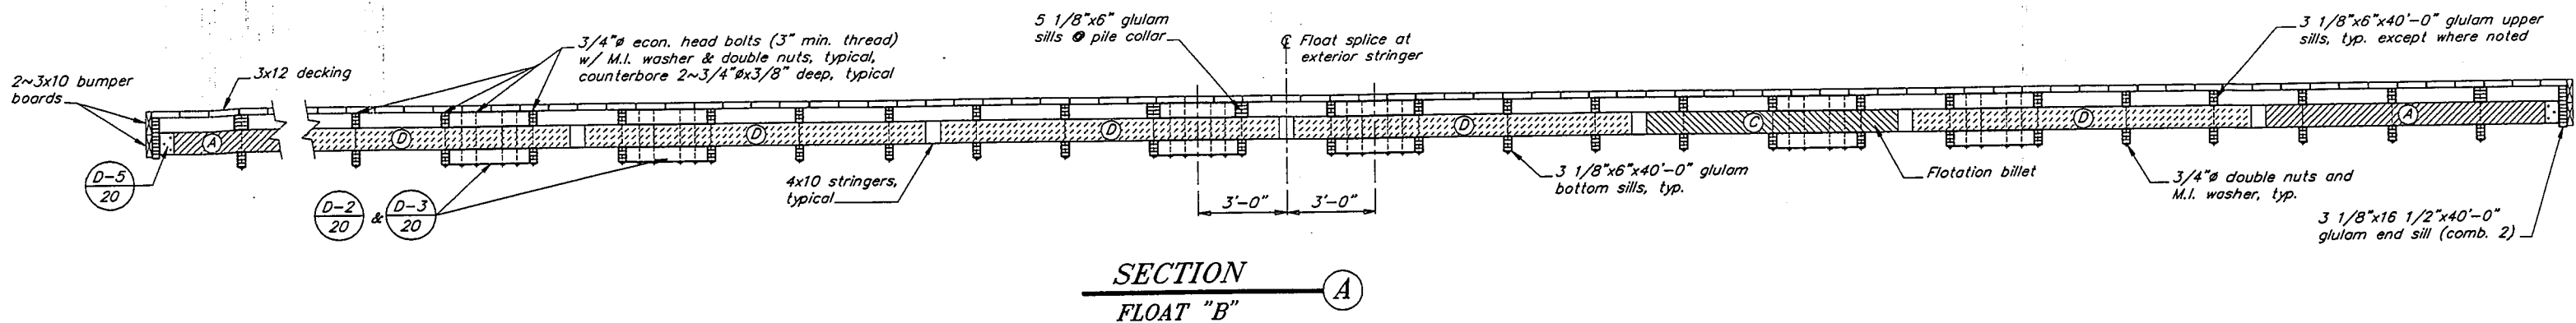


PATH : P:\CRG\SEAFLE\DR\SH119.dwg <1=32>		
BY	DATE	DESCRIPTION OF CHANGE


RECORD OF REVISIONS

STATE OF ALASKA
DEPARTMENT OF TRANSPORTATION
AND PUBLIC FACILITIES
SOUTHEAST REGION DESIGN & CONSTRUCTION

CRAIG
CRAIG SEAPLANE BASE EXPANSION
A.I.P. # 3-02-0071-01
SEAPLANE FLOAT "C" & "D" - SECTIONS


ALASKA	DESIGNED BY: D.D.S.	PROJECT No. 69956
	DRAWN BY: B.W.B.	DATE: JULY 1994
	CHECKED BY: C.A.B.	SHEET 19 OF 60

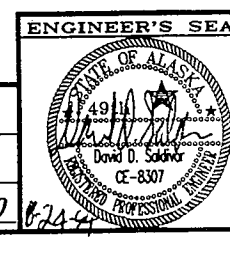

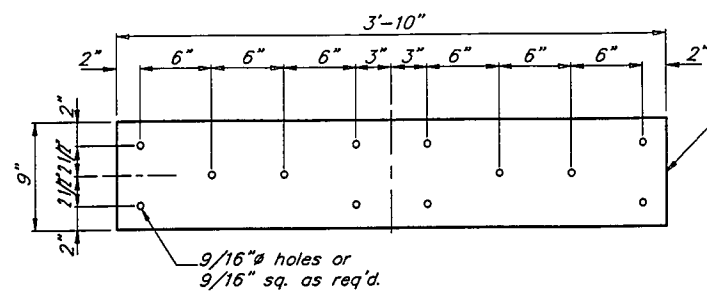


SPlice PLATE DETAIL 1


Splice plate 1/4"x9"x3'-10", one as shown and one with 9/16" square holes for 1/2"x4 1/2" carriage bolts & hex. nuts at each exterior stringer splice

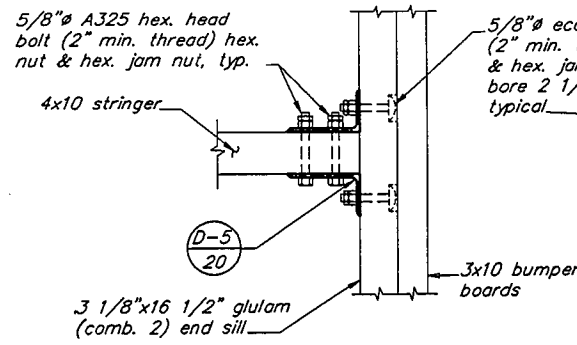

INTERMEDIATE CONNECTION @ END SILL

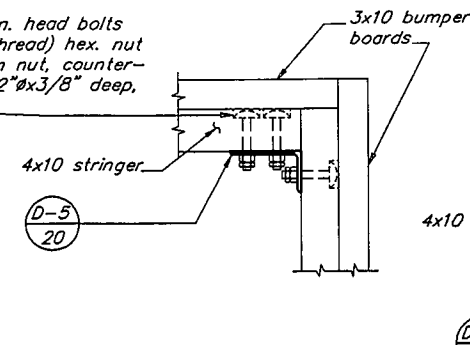


CORNER CONNECTION @ END SILL

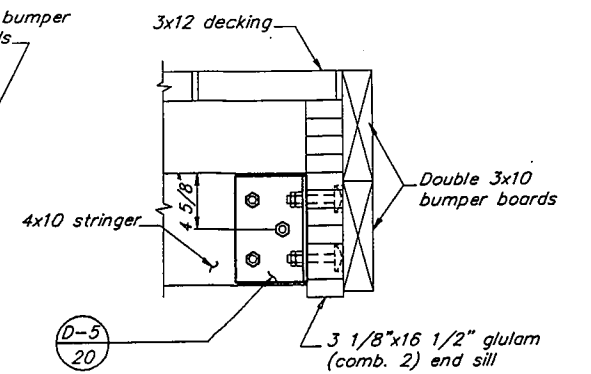


TYPICAL CONNECTION ELEVATION @ END SILL

CONNECTION DETAILS


4

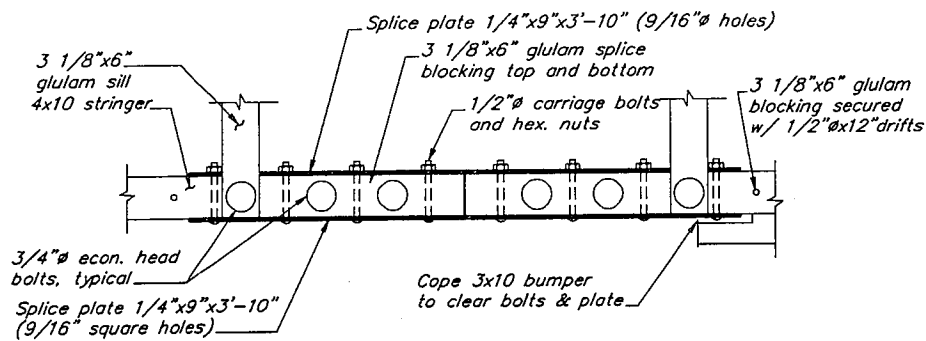


PLAN

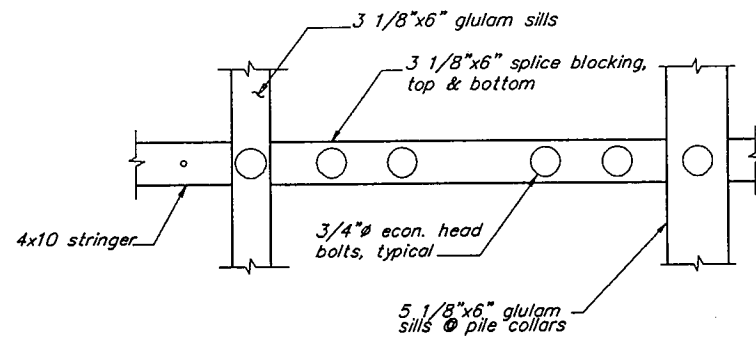


PLAN

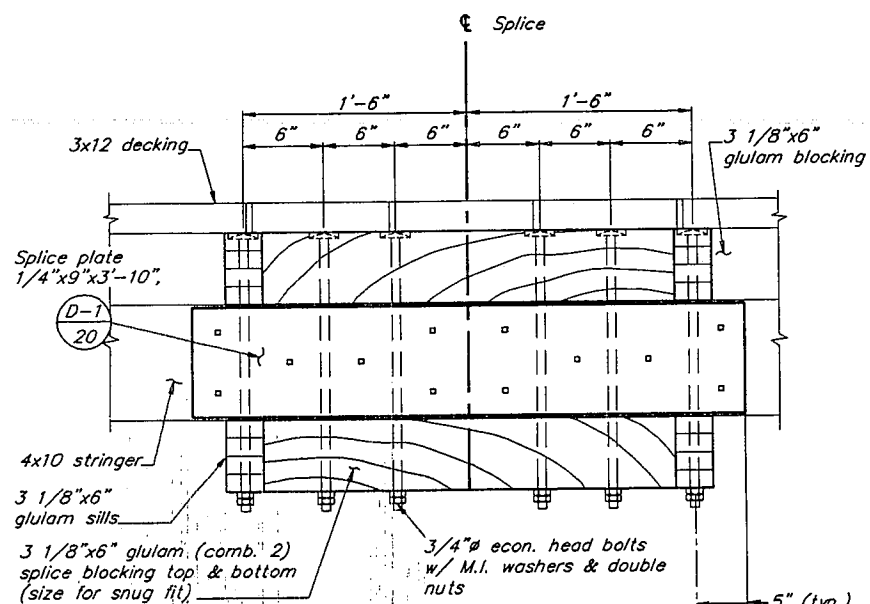

ELEVATION

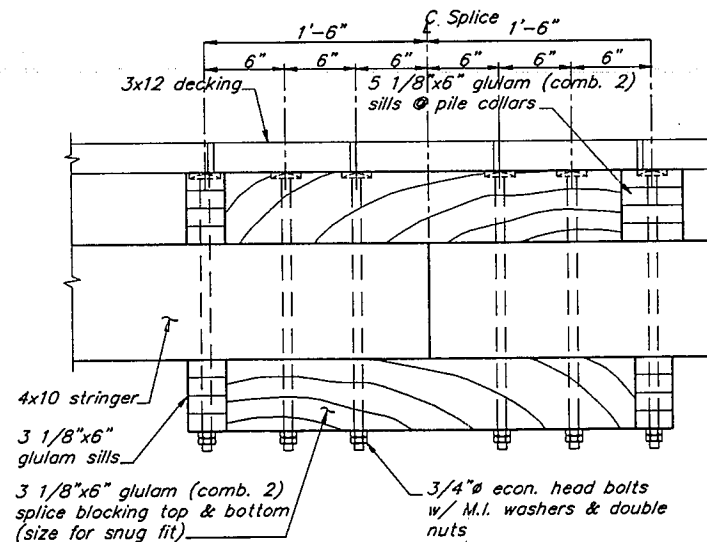


ELEVATION

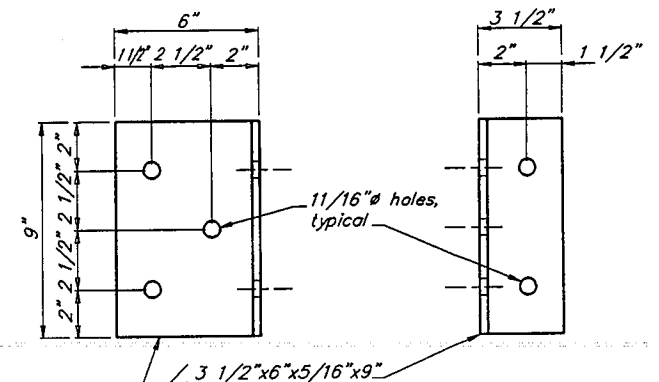

CONNECTOR DETAIL

5

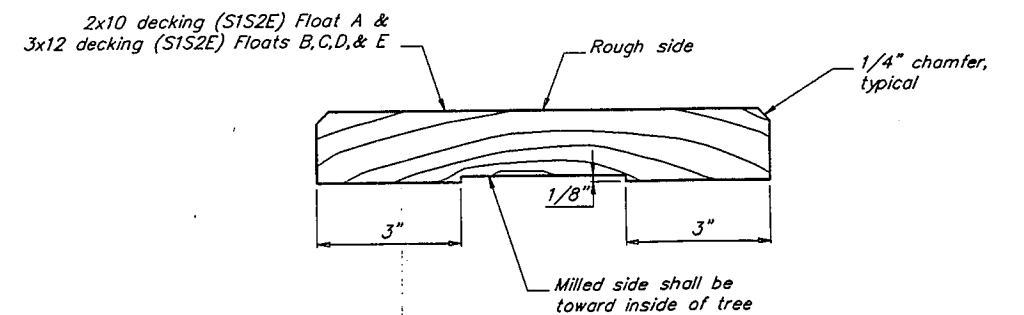

MILLED DECKING DETAIL

6

EXTERNAL STRINGER SPLICE DETAIL 2

INTERNAL STRINGER SPLICE DETAIL 3

PATH: P:\ORIG\SEAPL\DR\SH120.dwg < 1-32 >		
BY	DATE	DESCRIPTION OF CHANGE


STATE OF ALASKA
DEPARTMENT OF TRANSPORTATION
AND PUBLIC FACILITIES
SOUTHEAST REGION DESIGN & CONSTRUCTION


CRAIG

CRAIG SEAPLANE BASE EXPANSION
A.I.P. # 3-02-0071-01

SEAPLANE FLOAT DETAILS

ALASKA	DESIGNED BY: D.D.S.	PROJECT No. 69956
	DRAWN BY: B.W.B.	DATE: JULY 1994
	CHECKED BY: C.A.B.	SHEET 20 OF 60

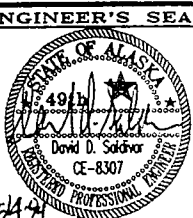


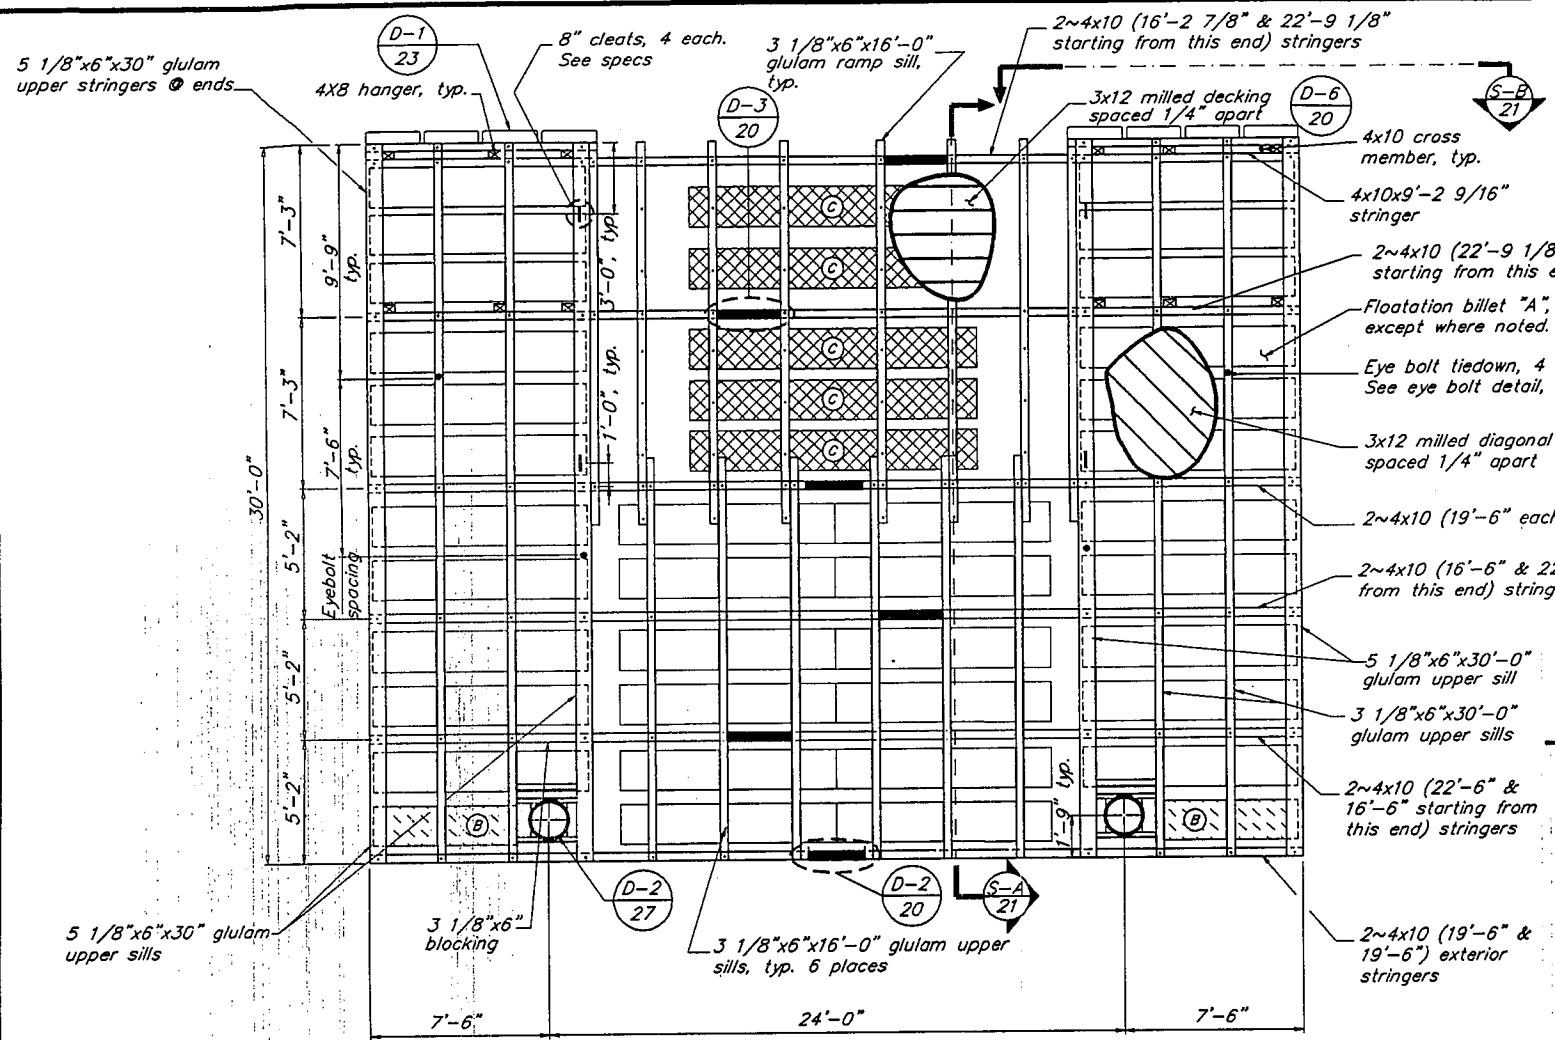


PLAN

NOTES :

1. 4x10 stringers shall be S4S, size to allow for a snug fit to flotation plank.
2. All hardware to be hot dip galvanized.
3. All bolts shall be 5/8" economy head type with lugs, unless otherwise noted.
4. A malleable iron washer shall be placed between nuts and timber.
5. Bolt heads shall be drilled 1/16" oversize, drift holes 1/16" undersize.
6. Bolt holes facing decking shall be countersunk 3/8".
7. All vertical stringer bolts shall have double nuts.
8. Apply 3x12 milled decking diagonally except at the ramp. Secure to every sill with 2~60d double hot-dipped galv. nails. Pre-drill to prevent splitting if required.
9. Apply 3x12 milled decking at the ramp perpendicular to the ramp sill. Secure to every sill with 2~60d double hot-dipped galv. nails. Pre-drill to prevent splitting if required.

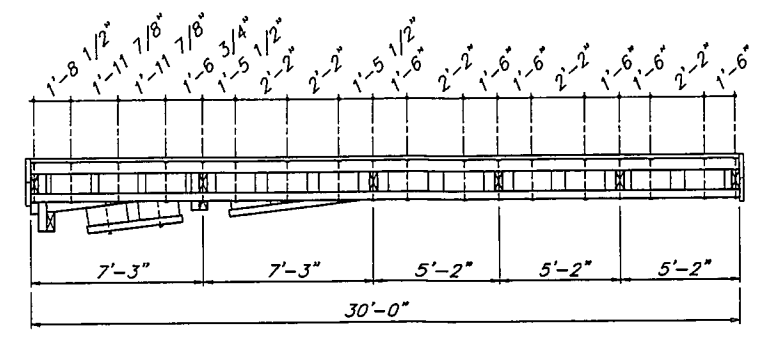


PROFILE

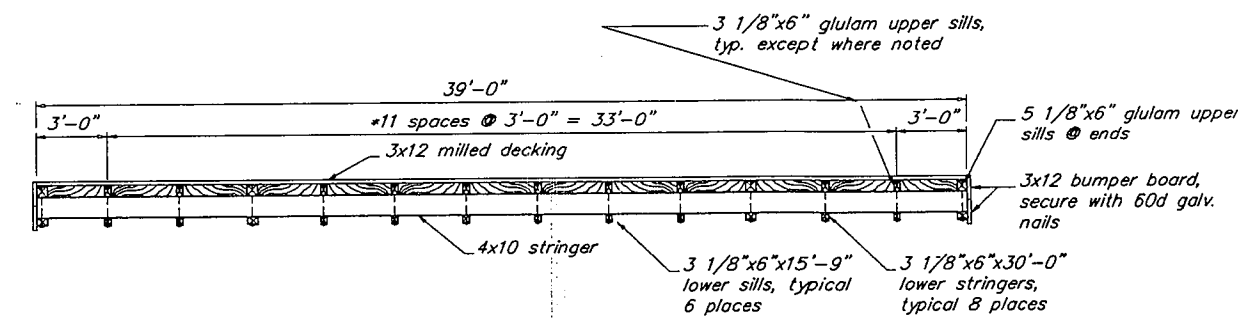


ELEVATION

* Space between pile collar shall be adjusted to fit

D-2
27

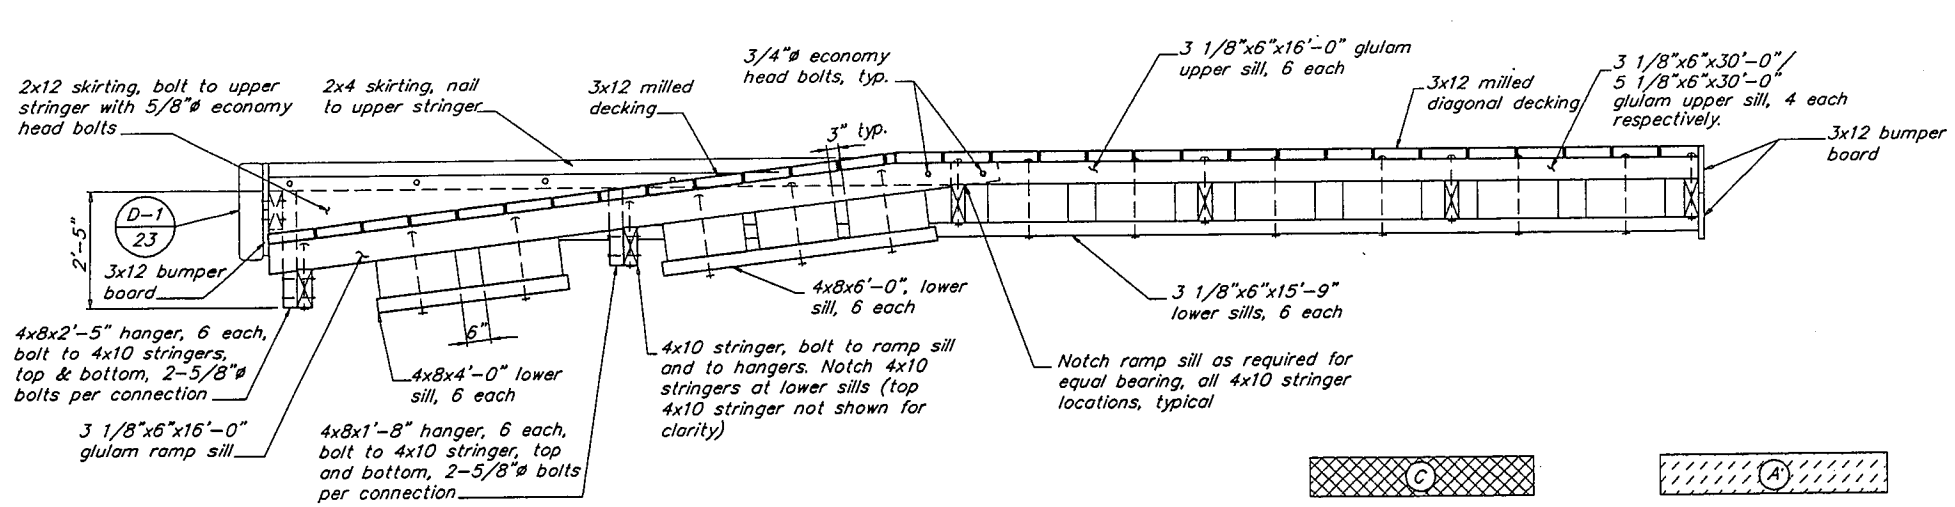

SECTION A

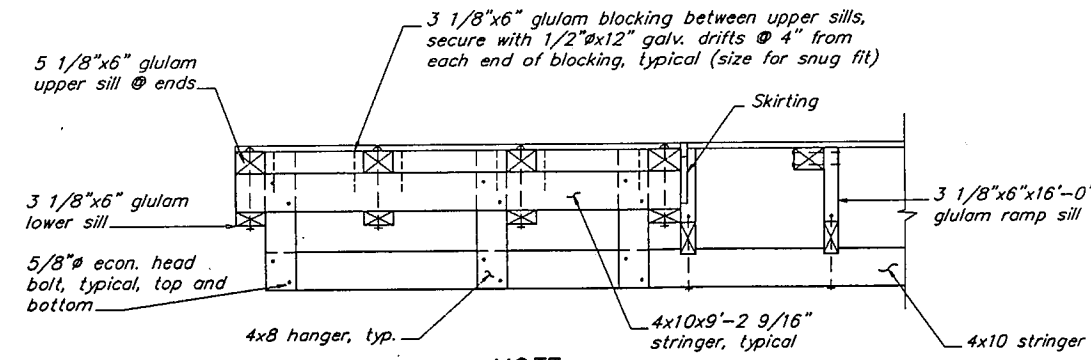


SECTION B

NOTE: MIDDLE STRINGER NOT SHOWN.



20" x 9 1/4" x 11'-0" (5 required)

Flotation Billet "C"

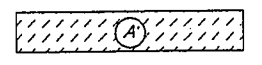

20" x 9 1/4" x 9'-0" (34 required)

Flotation Billet "A"



20" x 9 1/4" x 6'-0" (2 required)


Flotation Billet "B"


PATH : P:\CRG\SEARCH\DR\RAMPLT.DWG < 1=48 >		
BY	DATE	DESCRIPTION OF CHANGE

STATE OF ALASKA
DEPARTMENT OF TRANSPORTATION
AND PUBLIC FACILITIES
SOUTHEAST REGION DESIGN & CONSTRUCTION

CRAIG
CRAIG SEAPLANE BASE EXPANSION
A.I.P # 3-02-0071-01
RAMP FLOAT "E"


ALASKA	DESIGNED BY: D.D.S.	PROJECT No. 69956
	DRAWN BY: B.W.B.	DATE: JULY 1994
	CHECKED BY: C.A.B.	SHEET 21 OF 60

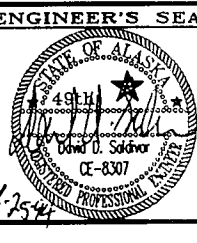

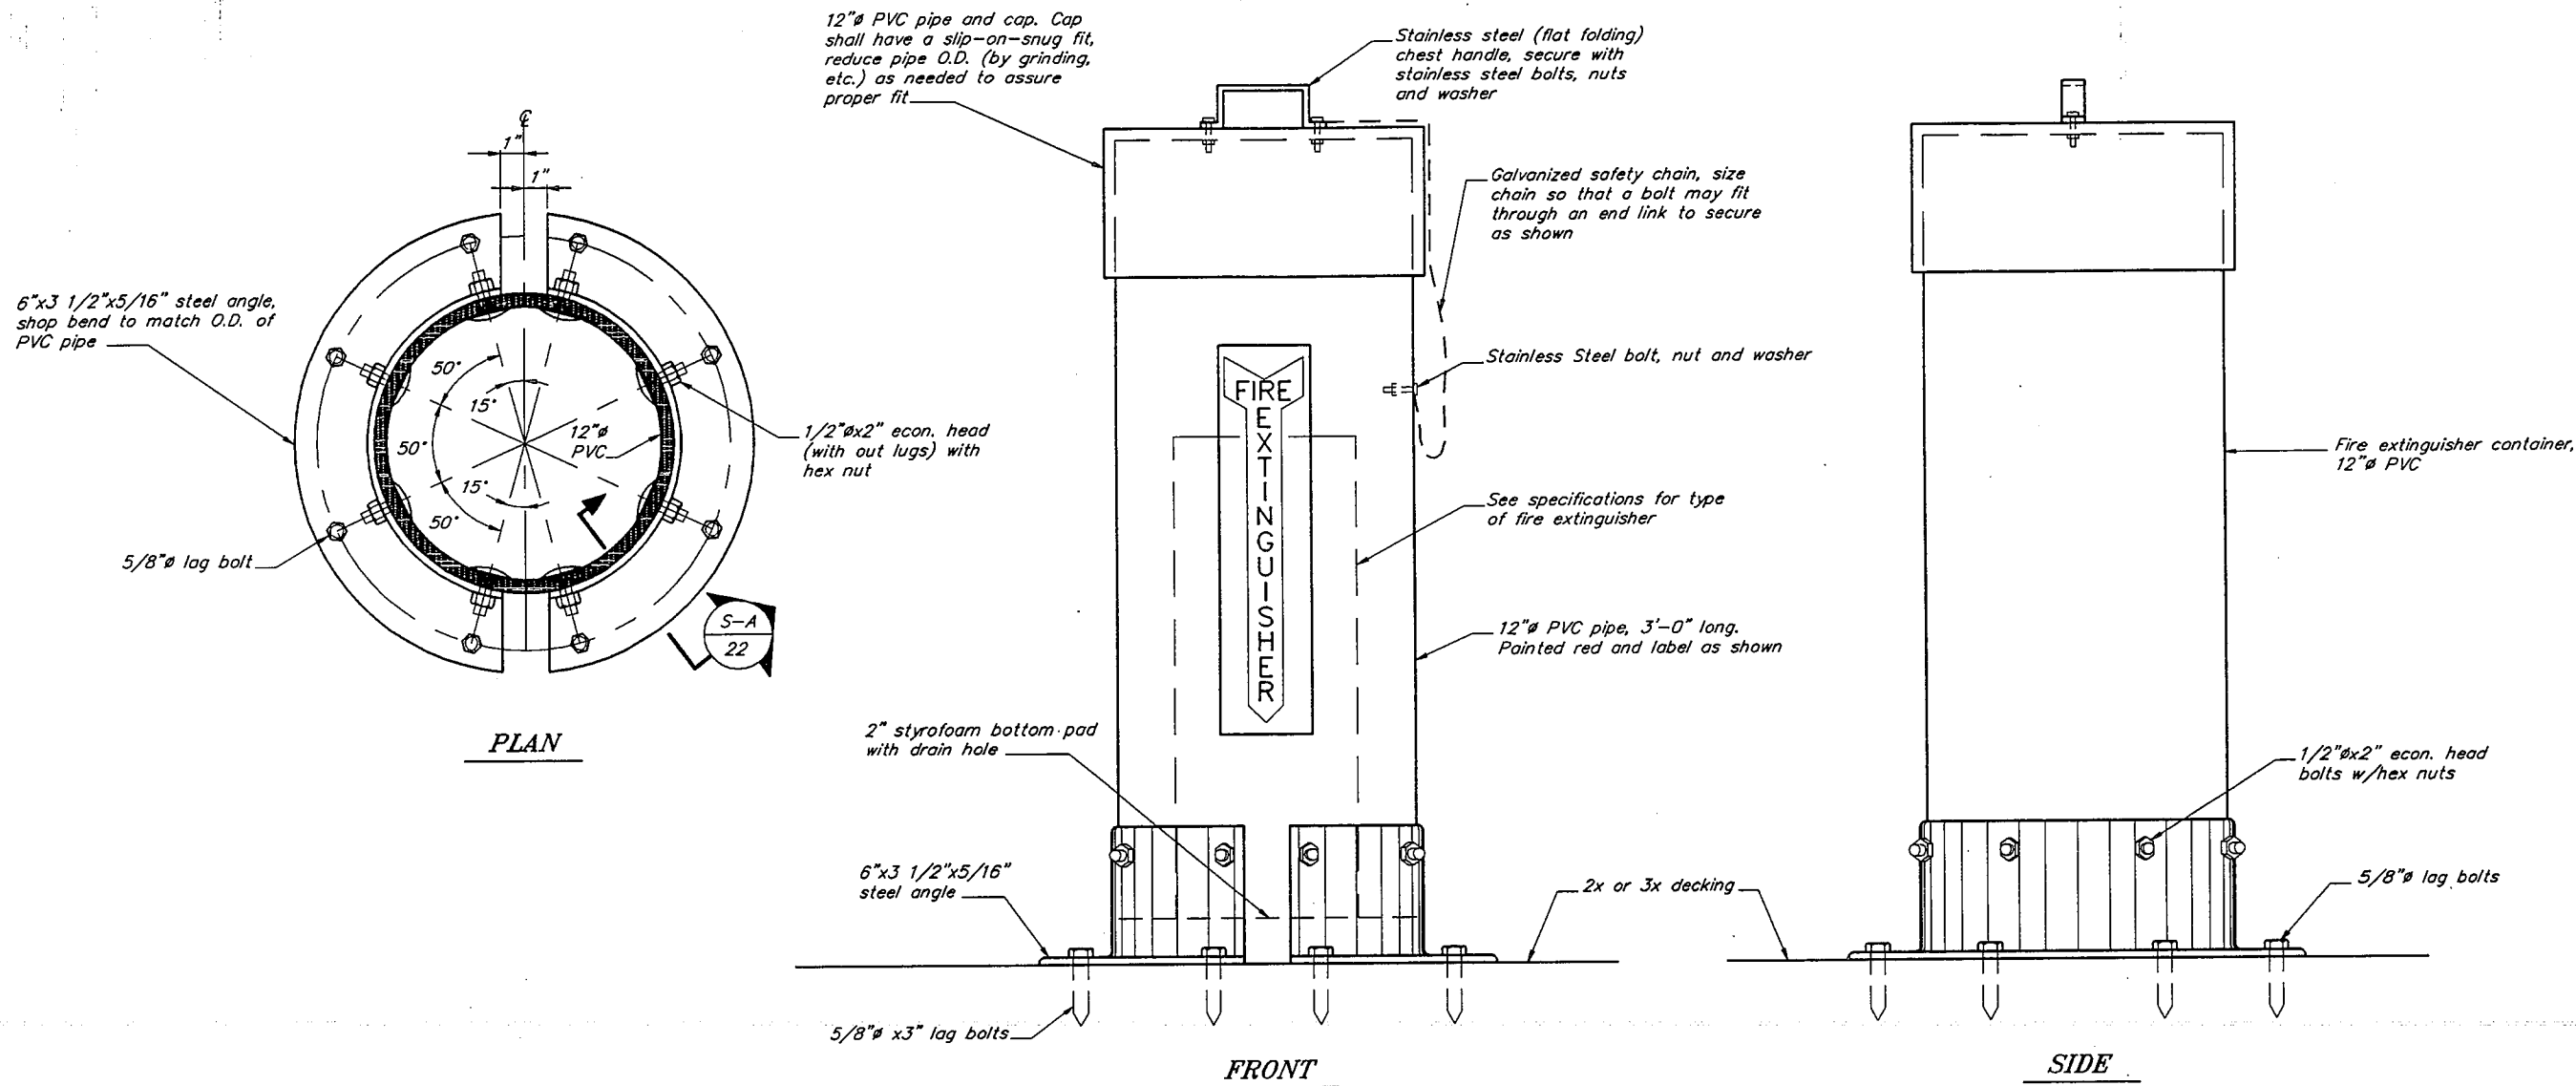

FIRE EXTINGUISHER & CONTAINER
(4 REQUIRED)

1

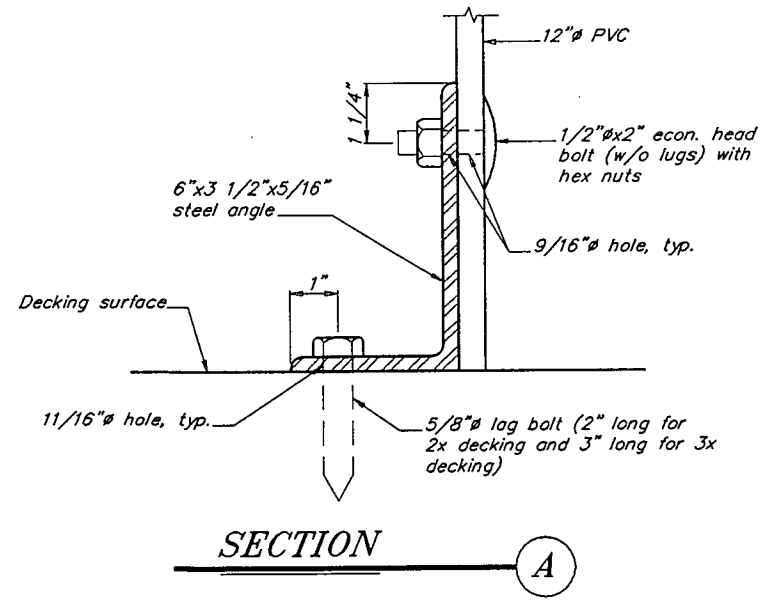


BY	DATE	DESCRIPTION OF CHANGE
RECORD OF REVISIONS		

STATE OF ALASKA
DEPARTMENT OF TRANSPORTATION
AND PUBLIC FACILITIES
SOUTHEAST REGION DESIGN & CONSTRUCTION


CRAIG
CRAIG SEAPLANE BASE EXPANSION
A.I.P # 3-02-0071-01
ALASKA
FIRE EXTINGUISHER & CONTAINER DETAILS

DESIGNED BY: D.D.S.	PROJECT No. 69958
DRAWN BY: B.W.B.	DATE: JULY 1994
CHECKED BY: C.A.B.	SHEET 22 OF 60

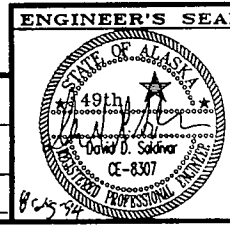


NOTES :

1. Tires shall be 13" with a minimum 1/8" deep summer or all season tread. No heavy lugs or studs.
2. All of the tires shall be of the same width with a maximum allowable variation of 1/2".
3. Paint tires per specification.

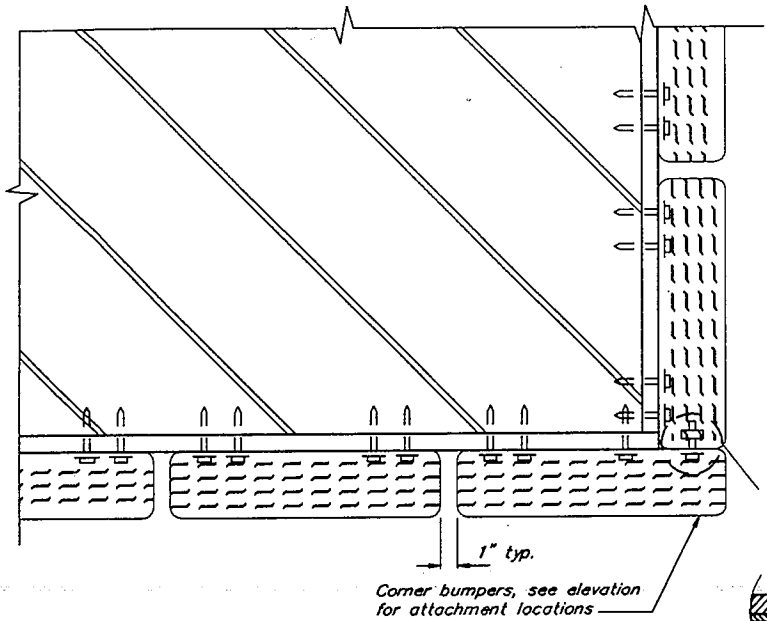


PLAN

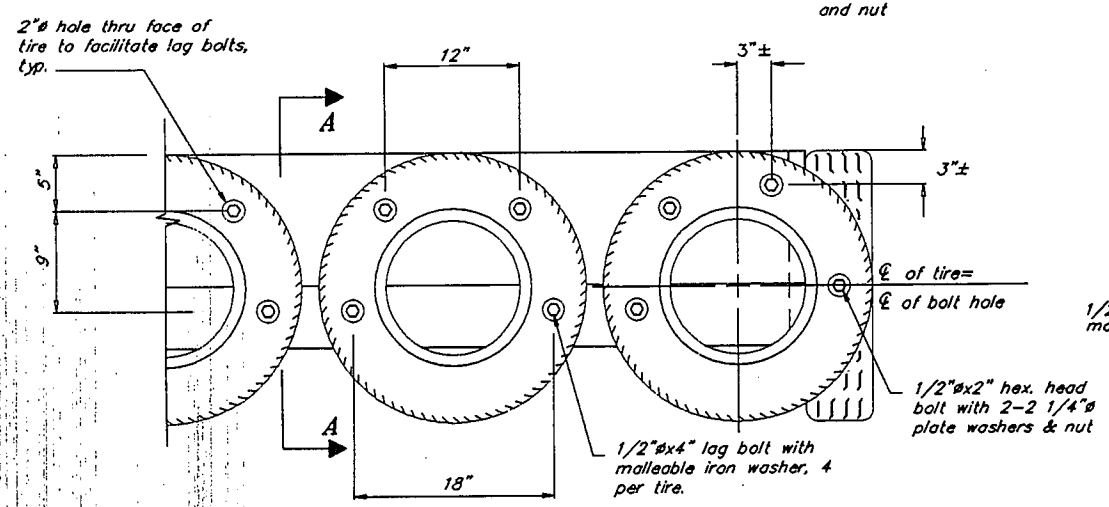

ELEVATION


TIRE BUMPER DETAILS

1

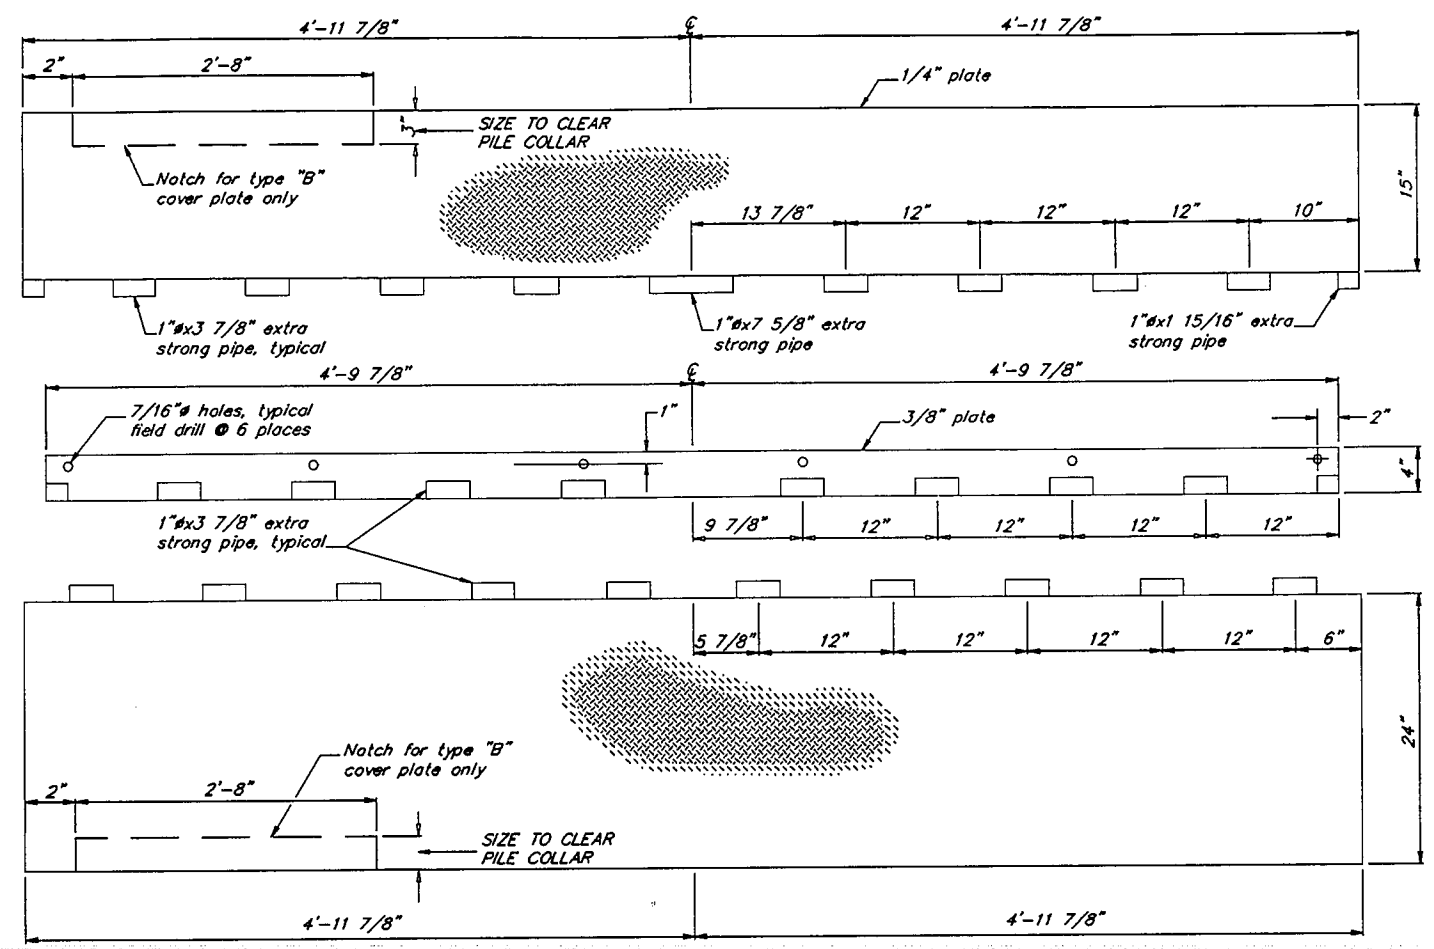


TYPE "A" & "B" COVER PLATE

2

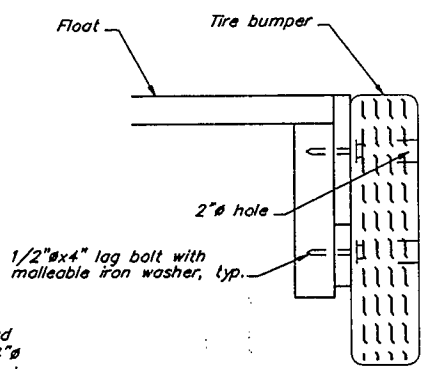

SECTION

A

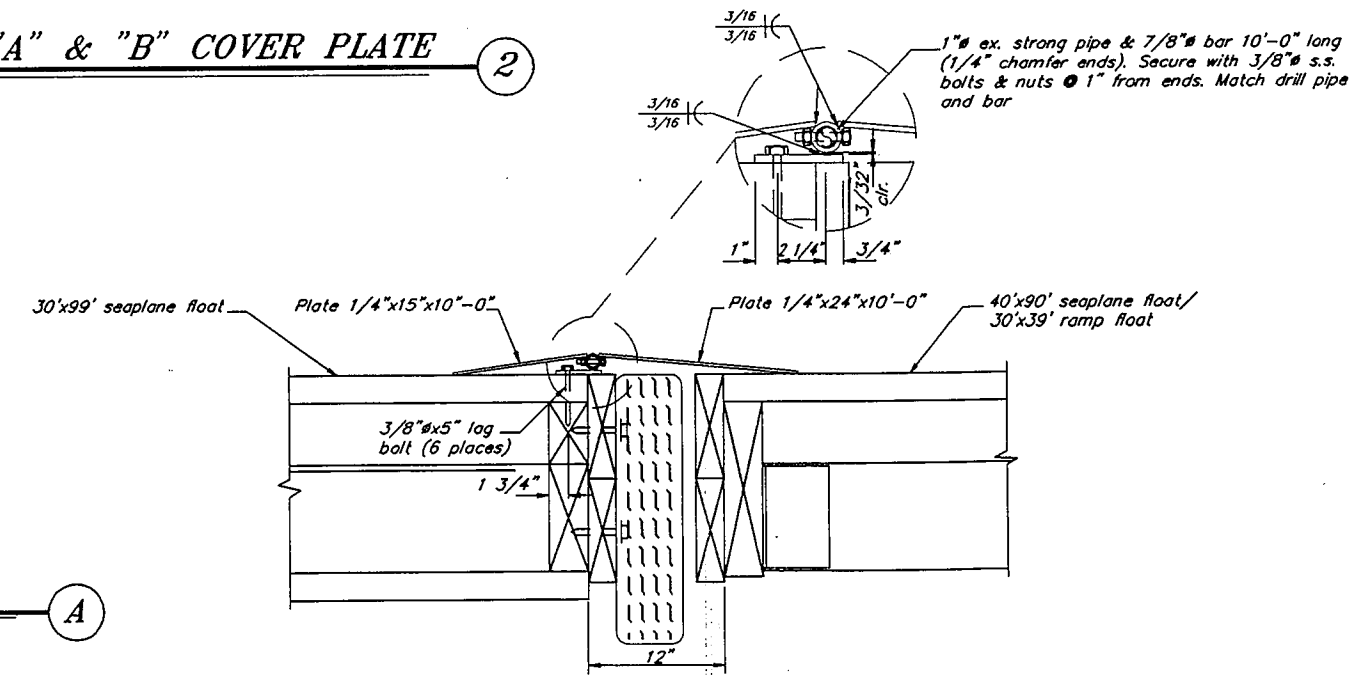

SECTION


B


RECORD OF REVISIONS		
BY	DATE	DESCRIPTION OF CHANGE

STATE OF ALASKA
DEPARTMENT OF TRANSPORTATION
AND PUBLIC FACILITIES
SOUTHEAST REGION DESIGN & CONSTRUCTION

CRAIG
CRAIG SEAPLANE BASE EXPANSION
A.I.P. # 3-02-0071-01
TIRE BUMPER & COVER PLATE DETAILS


ALASKA	DESIGNED BY: D.D.S.	PROJECT No. 69956
	DRAWN BY: B.W.B.	DATE: JULY 1994
	CHECKED BY: C.A.B.	SHEET 23 OF 60

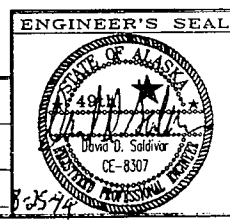

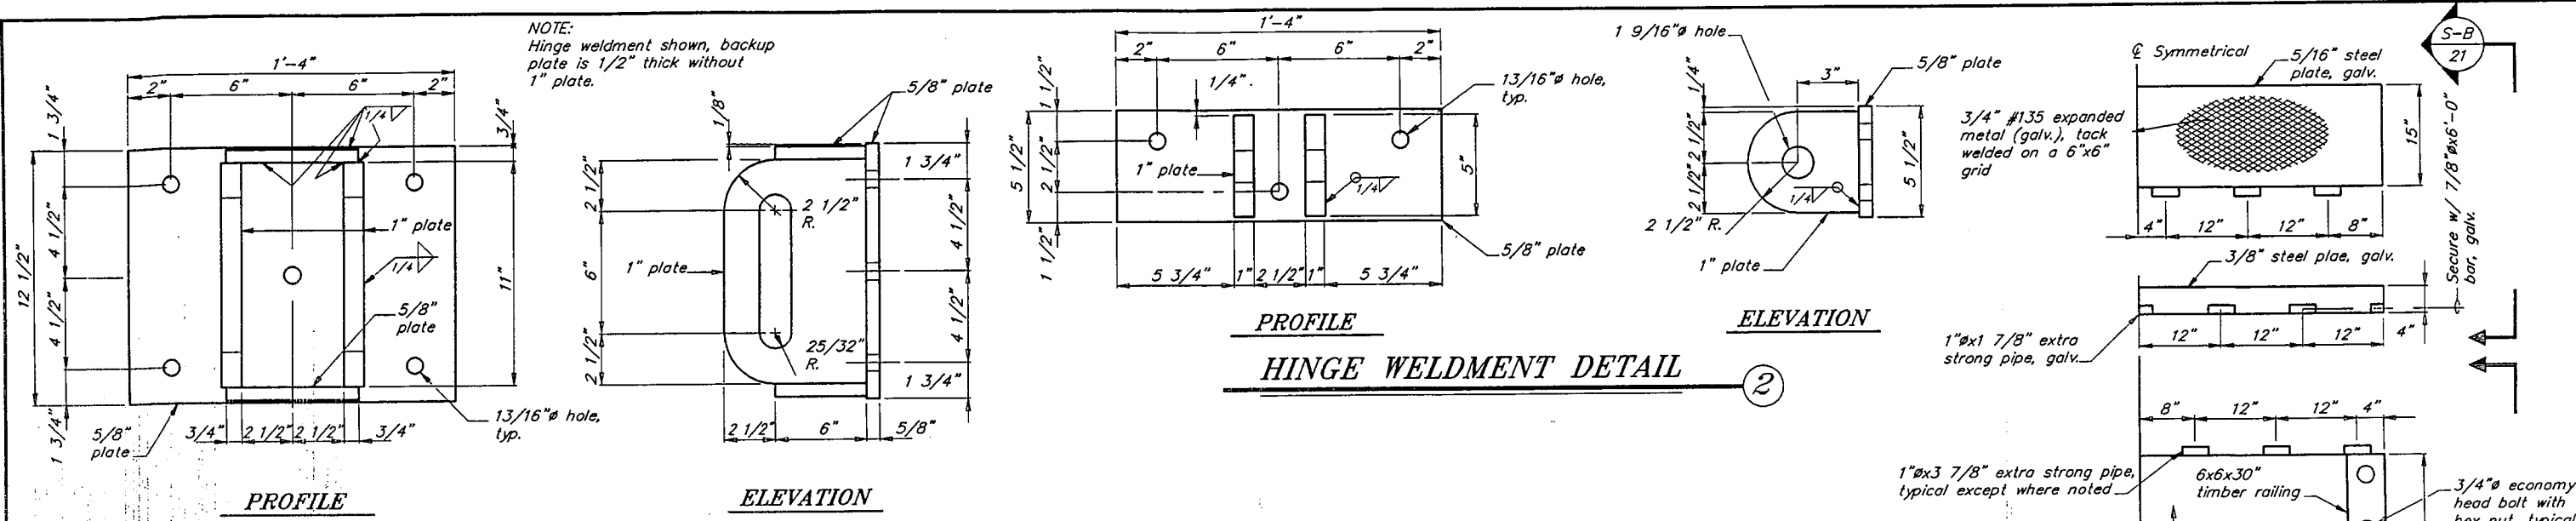


HINGE WELDMENT DETAIL 1


HINGE WELDMENT DETAIL 2

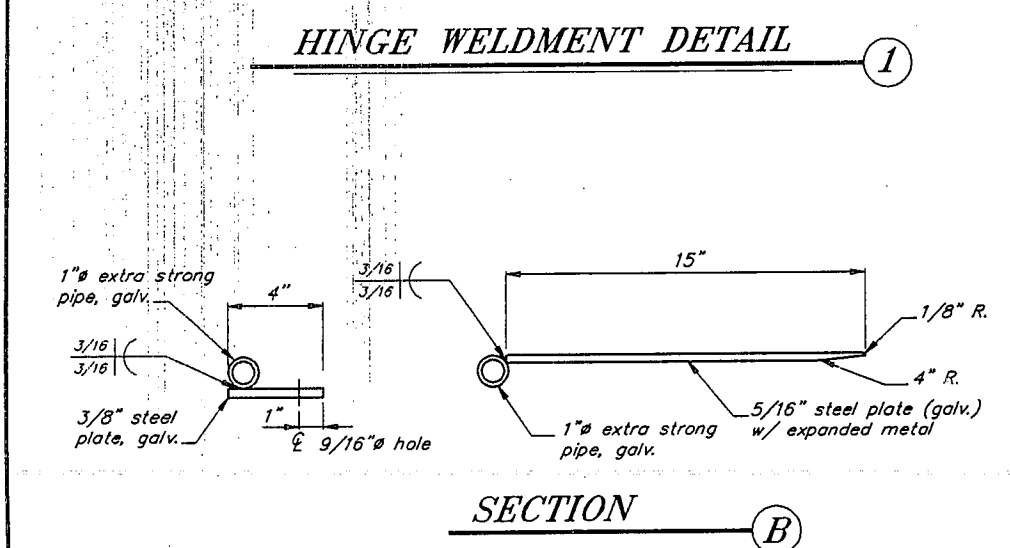


SECTION B

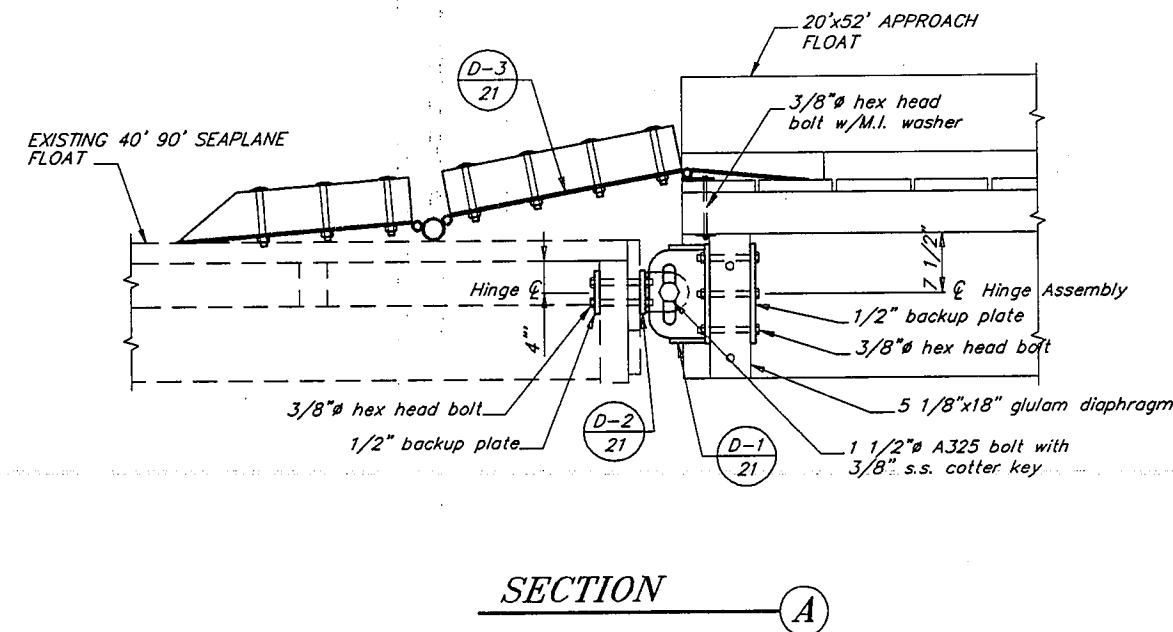


SECTION A

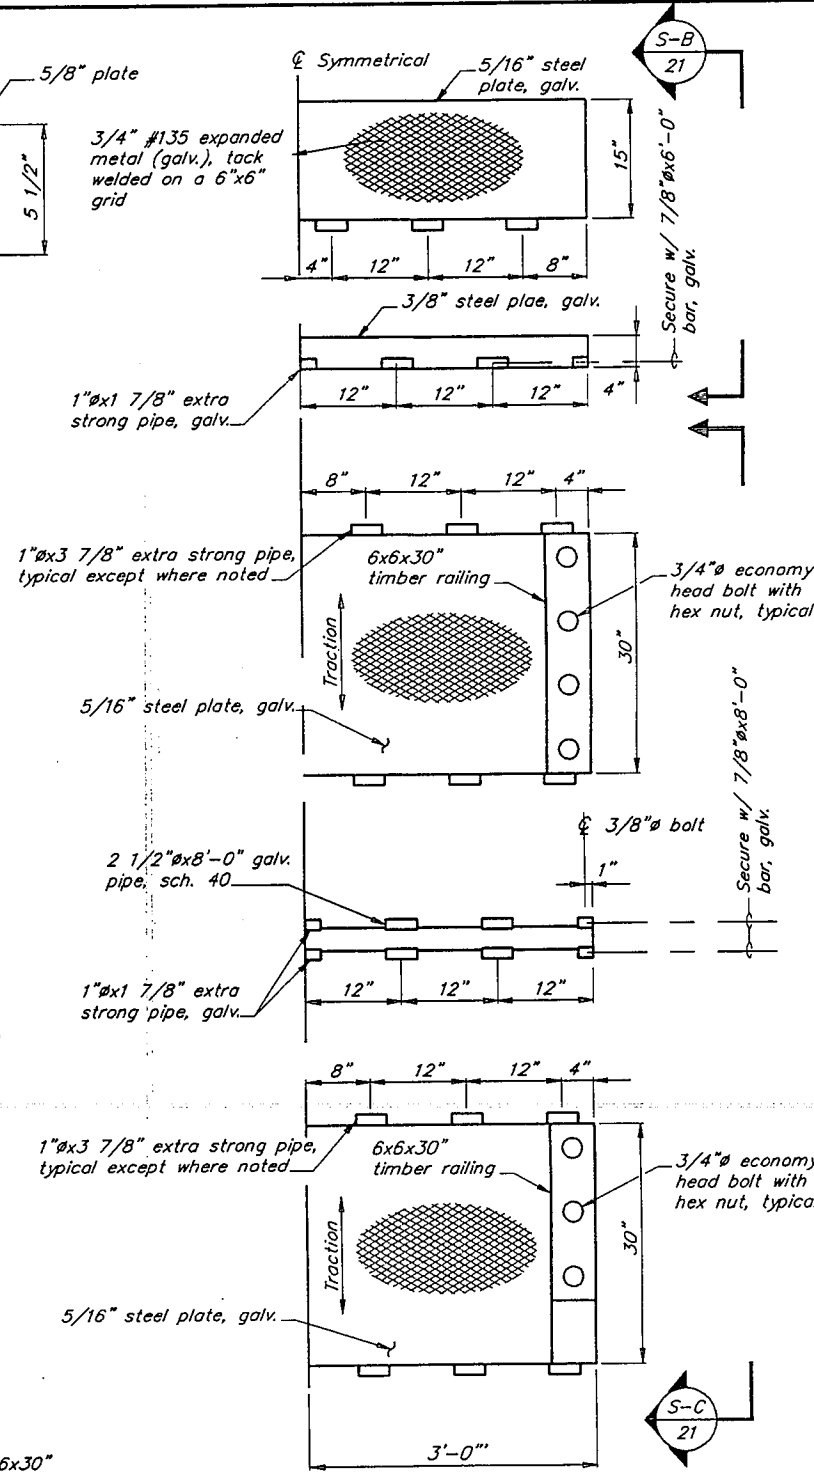

TRANSITION PLATE DETAIL 3

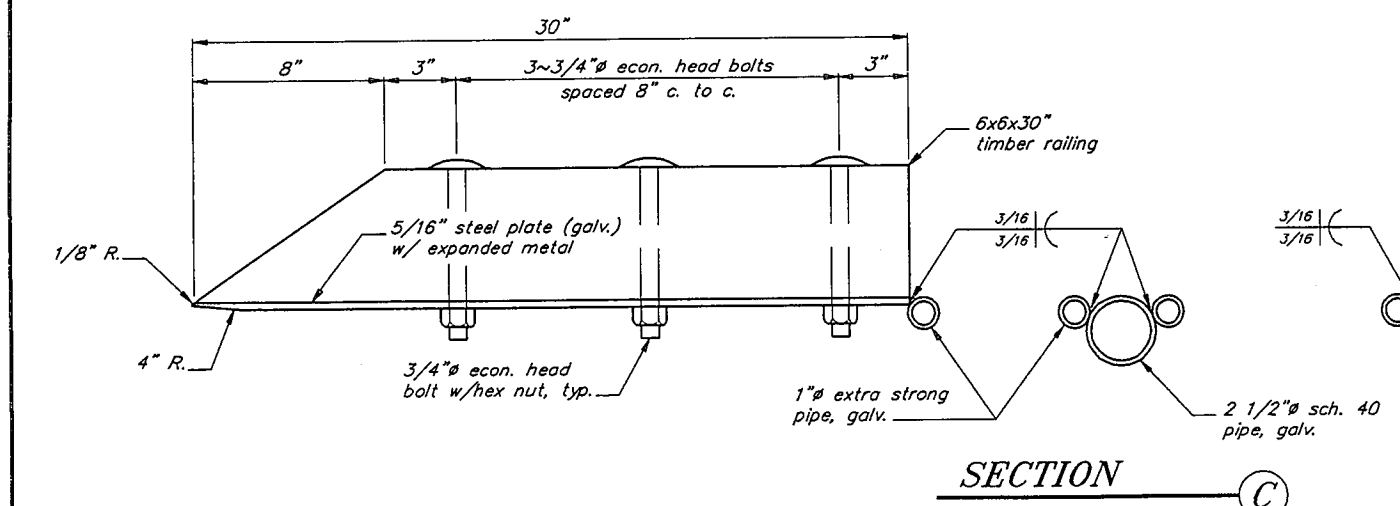

SECTION C

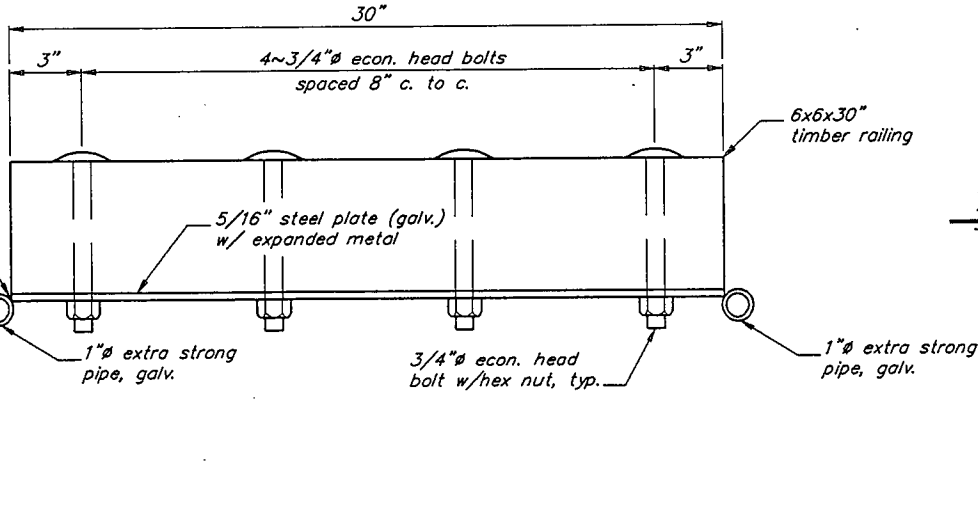



PATH: P:\CRG\SEAFLT\DR\ TRANSPLT 1=12		
BY:	DATE:	DESCRIPTION OF CHANGE:
RECORD OF REVISIONS		

STATE OF ALASKA
DEPARTMENT OF TRANSPORTATION
AND PUBLIC FACILITIES
SOUTHEAST REGION DESIGN & CONSTRUCTION


CRAIG
CRAIG SEAPLANE BASE EXPANSION
ALASKA
A.I.P. # 3-02-0071-01
TRANSITION PLATE DETAILS

DESIGNED BY: D.D.S.	PROJECT NO. 69956
DRAWN BY: B.W.B.	DATE: JULY 1994
CHECKED BY: M.H.	SHEET 24 OF 60


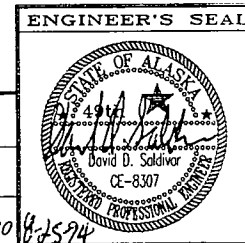


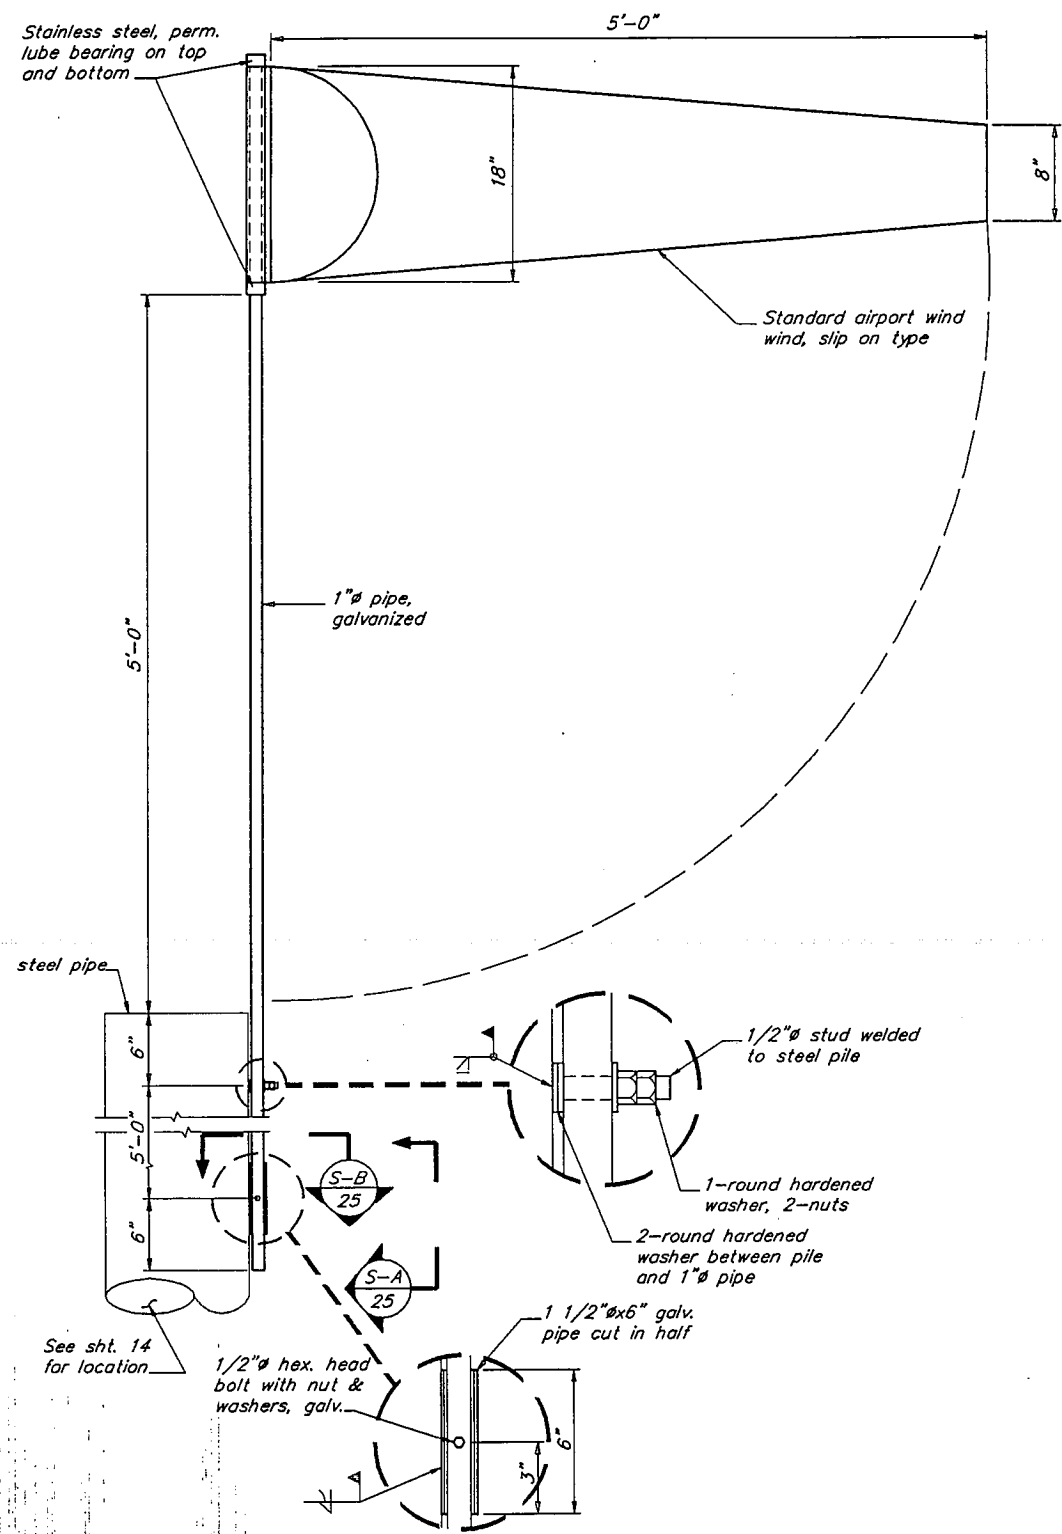

WIND CONE DETAIL
1 REQUIRED

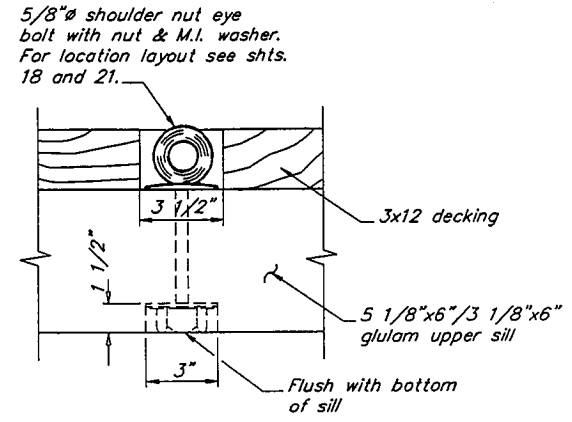

TIE-DOWN DETAIL
NOTE: Install 1/2" x 10 L.F. soft nylon strand rope at all eye bolts.

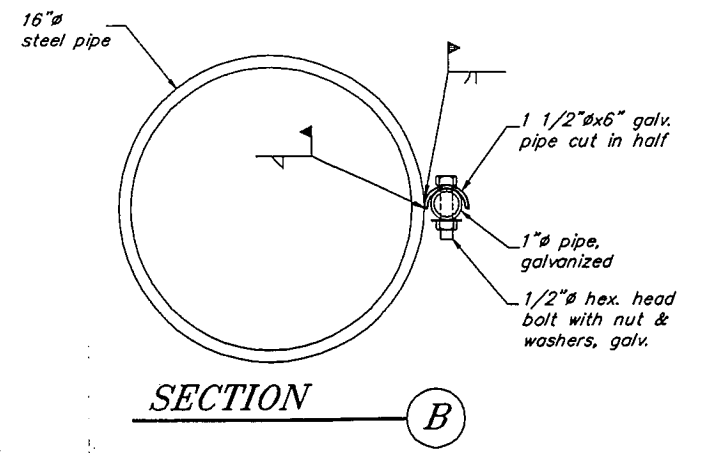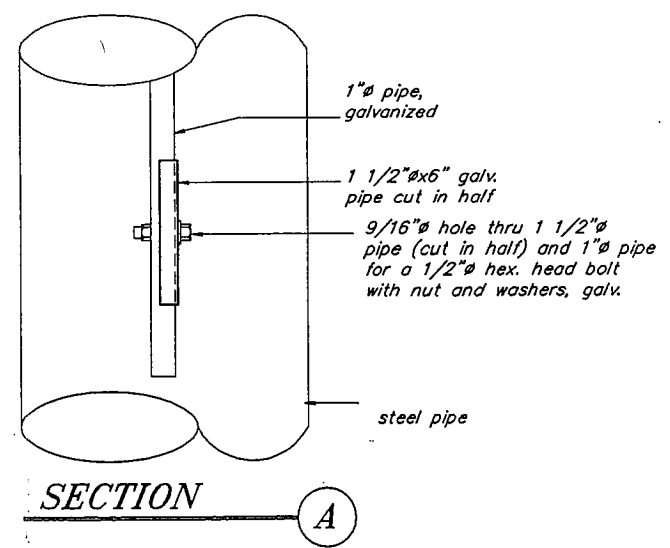


BY	DATE	DESCRIPTION OF CHANGE


RECORD OF REVISIONS

STATE OF ALASKA
DEPARTMENT OF TRANSPORTATION
AND PUBLIC FACILITIES
SOUTHEAST REGION DESIGN & CONSTRUCTION


CRAIG
CRAIG SEAPLANE BASE EXPANSION
A.I.P. # 3-02-0071-01
TIE DOWN & WIND CONE DETAILS

ALASKA	DESIGNED BY: D.D.S.	PROJECT No. 69958
	DRAWN BY: E.W.B.	DATE: JULY 1994
	CHECKED BY: C.A.B.	SHEET 25 OF 60

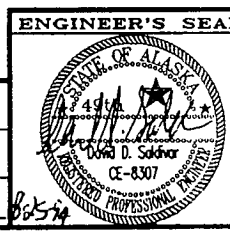

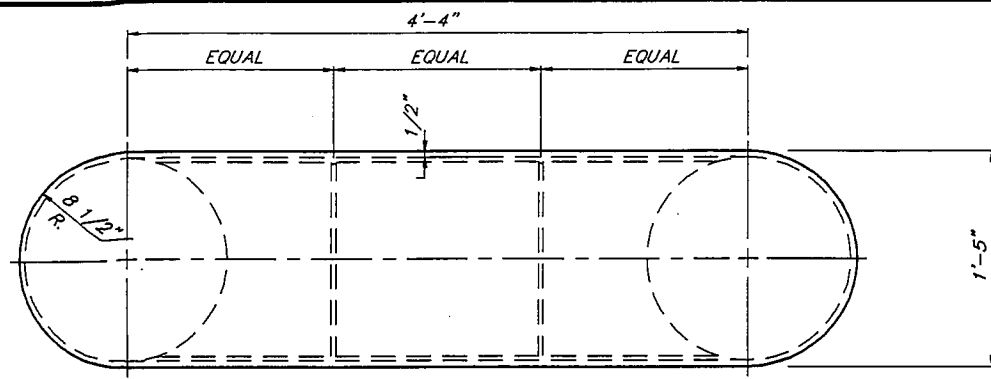


PLAN

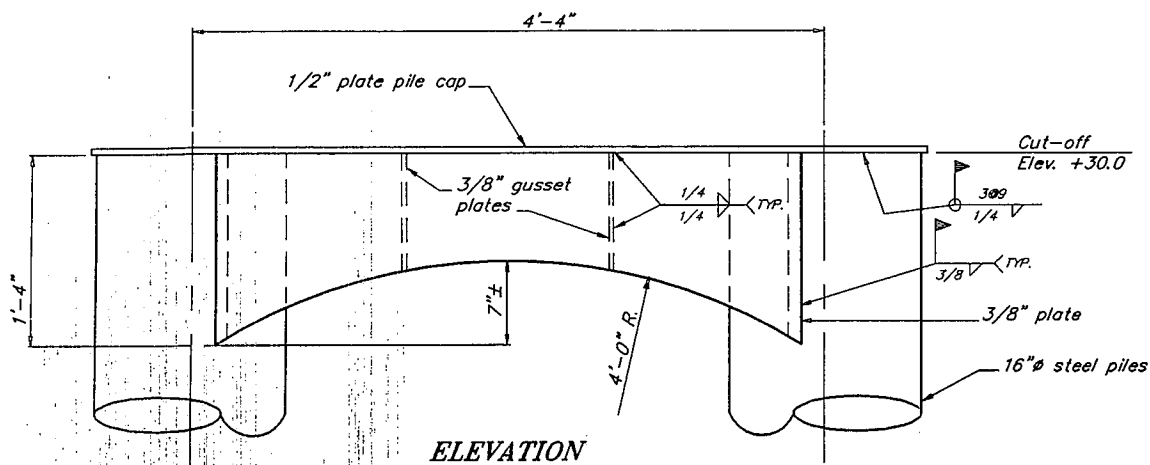


ELEVATION


DOUBLE PILE CAP DETAIL 4

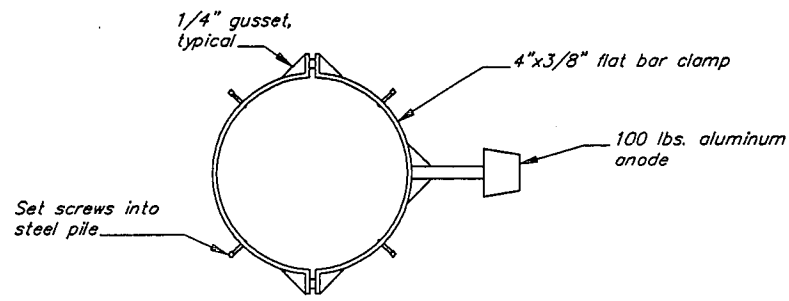

Section C

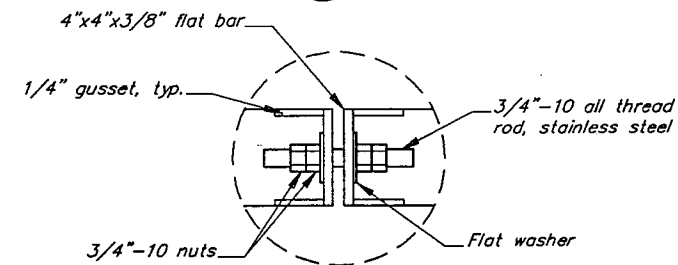


CLAMP CONNECTION DETAIL 3

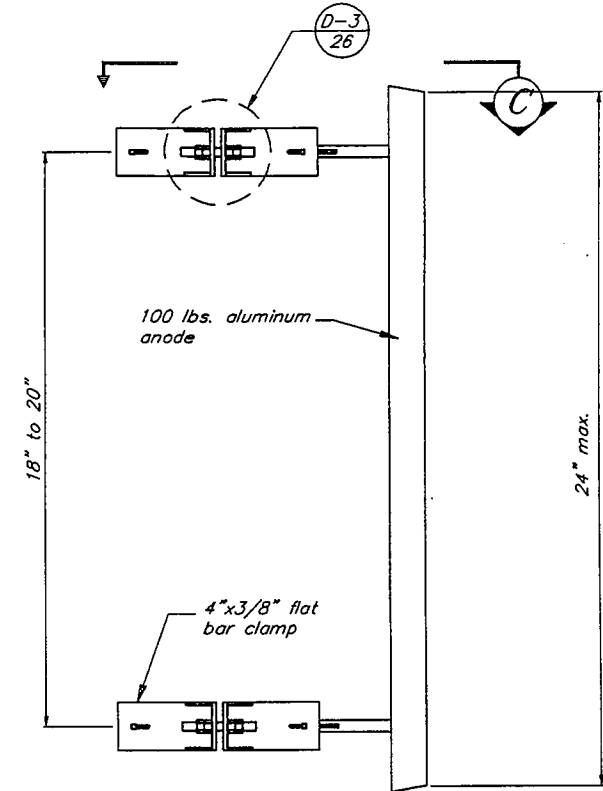


ANODE BRACLET DETAIL 2

(17 REQUIRED)

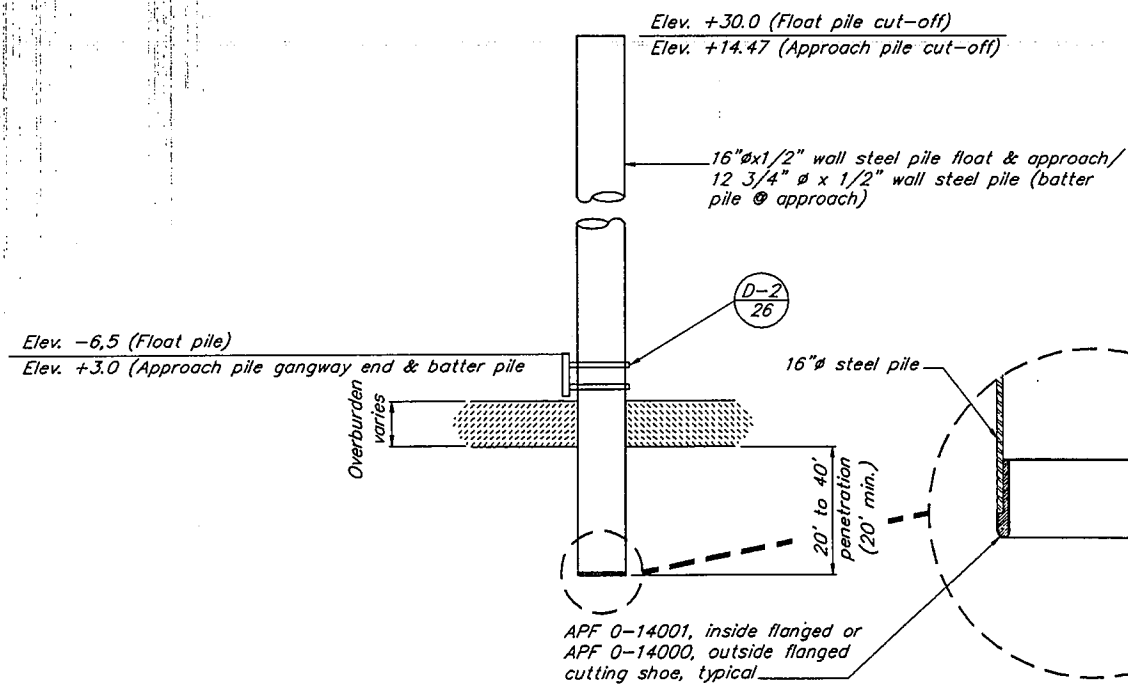

NON-SOCKET

STEEL PILE DETAIL 5

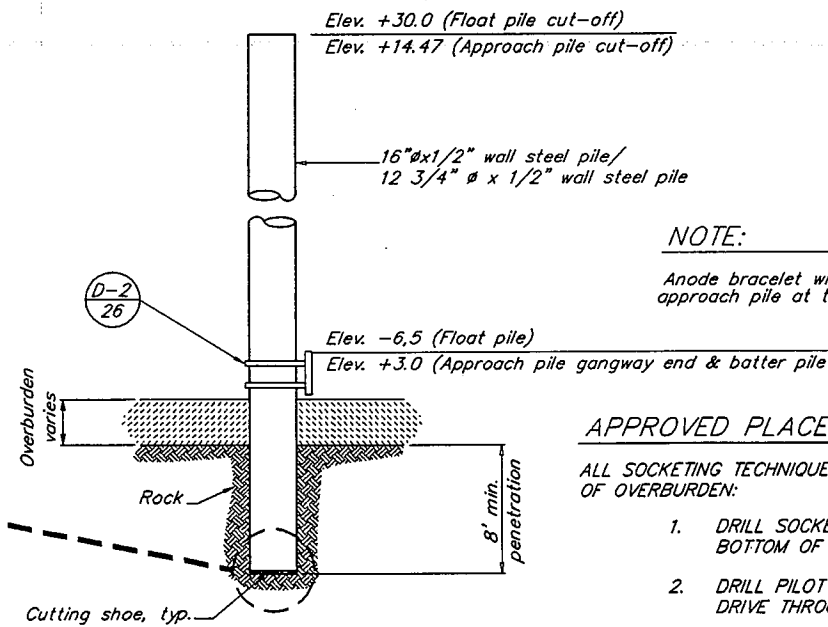

SOCKET

NOTE:

Anode bracelet will not be required on the approach pile at the uplands end only.

APPROVED PLACEMENT:

ALL SOCKETING TECHNIQUES TO DISPLACE A MINIMUM AMOUNT OF OVERBURDEN:

1. DRILL SOCKET, CLEAN OUT HOLE, DRIVE PILE TO BOTTOM OF SOCKET, OR
2. DRILL PILOT HOLE, BLAST TO FRACTURE ROCK, DRIVE THROUGH FRACTURED ROCK.

RECORD OF REVISIONS		
BY	DATE	DESCRIPTION OF CHANGE

STATE OF ALASKA
DEPARTMENT OF TRANSPORTATION
AND PUBLIC FACILITIES
SOUTHEAST REGION DESIGN & CONSTRUCTION

CRAIG


CRAIG SEAPLANE BASE EXPANSION
A.I.P. # 3-02-0071-01



PILE DETAILS

ALASKA

DESIGNED BY: D.D.S.
DRAWN BY: B.W.B.
CHECKED BY: C.A.B.

PROJECT No. 69958
DATE: JULY 1994
SHEET 26 OF 60

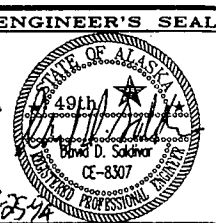

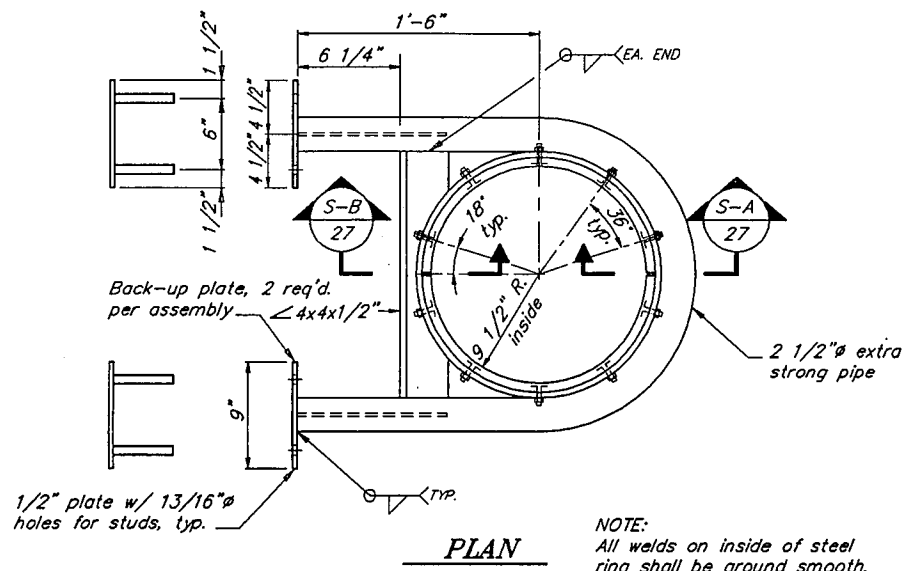
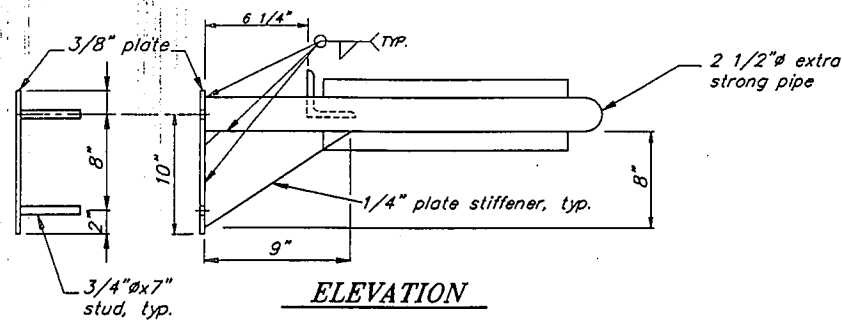


NOTE:
All welds on inside of steel ring shall be ground smooth.

PILE COLLAR DETAIL

1


NOTE: All welds on inside of steel ring shall be ground smooth.

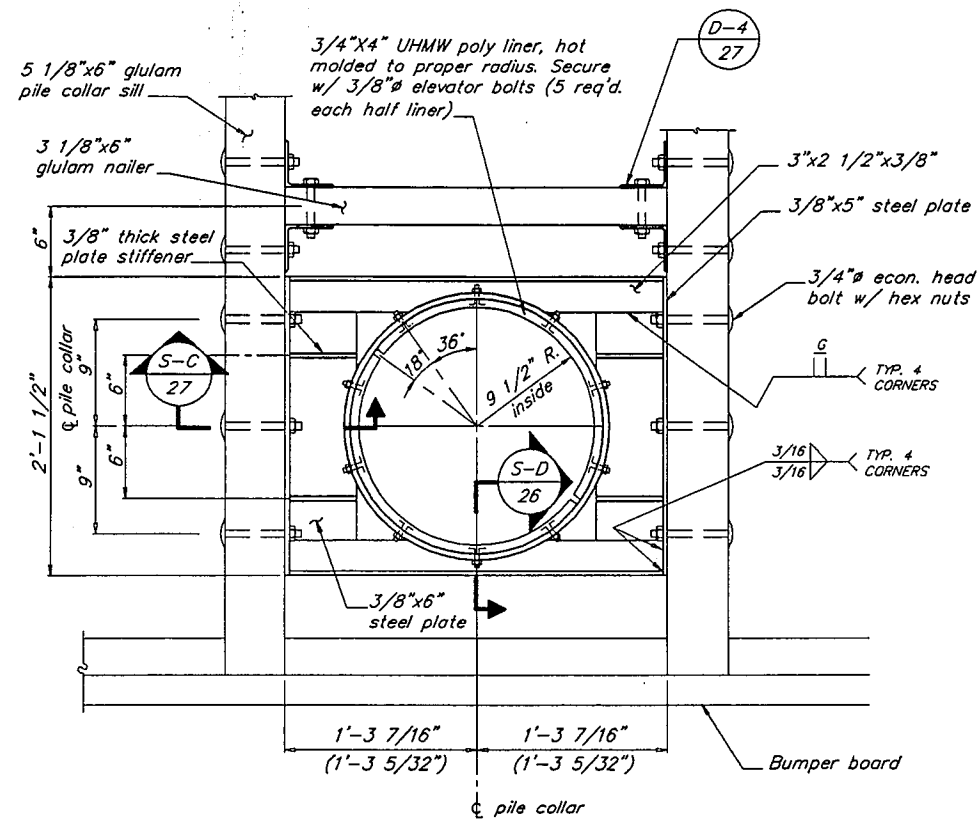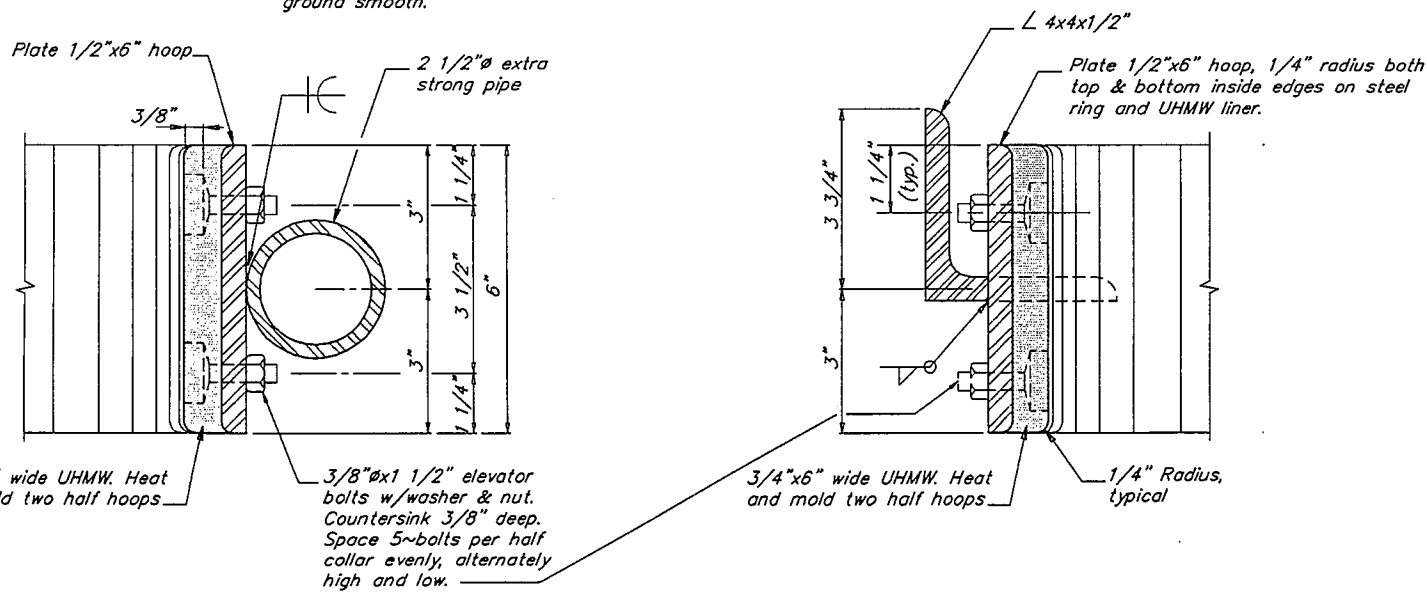

NOTE: Dimensions in parenthesis applies to Detail 3
All other dimensions are the same.


PILE COLLAR DETAIL

2 & 3

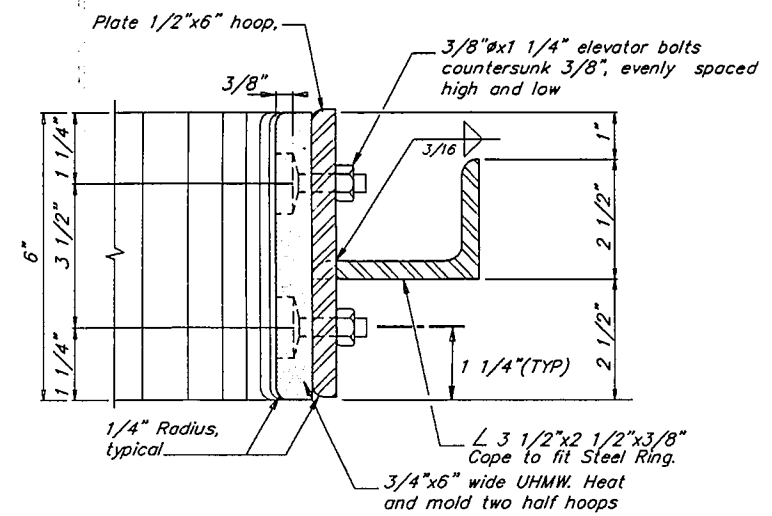


SECTION

D

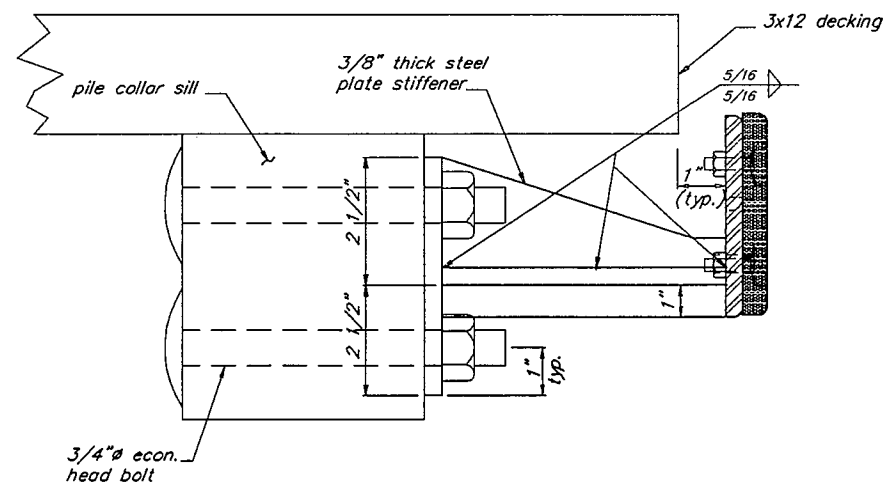

SECTION

C

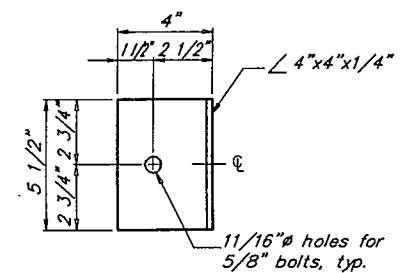

NAILER BRACKET DETAIL

4

BY	DATE	DESCRIPTION OF CHANGE
RECORD OF REVISIONS		

STATE OF ALASKA
DEPARTMENT OF TRANSPORTATION
AND PUBLIC FACILITIES
SOUTHEAST REGION DESIGN & CONSTRUCTION

CRAIG


CRAIG SEAPLANE BASE EXPANSION
A.I.P. # 3-02-0071-01


PILE COLLAR DETAILS

ALASKA


DESIGNED BY: D.D.S.
DRAWN BY: B.W.B.
CHECKED BY: C.A.B.

PROJECT No. 69956
DATE: JULY 1994
SHEET 27 OF 60

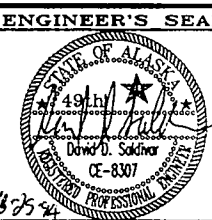


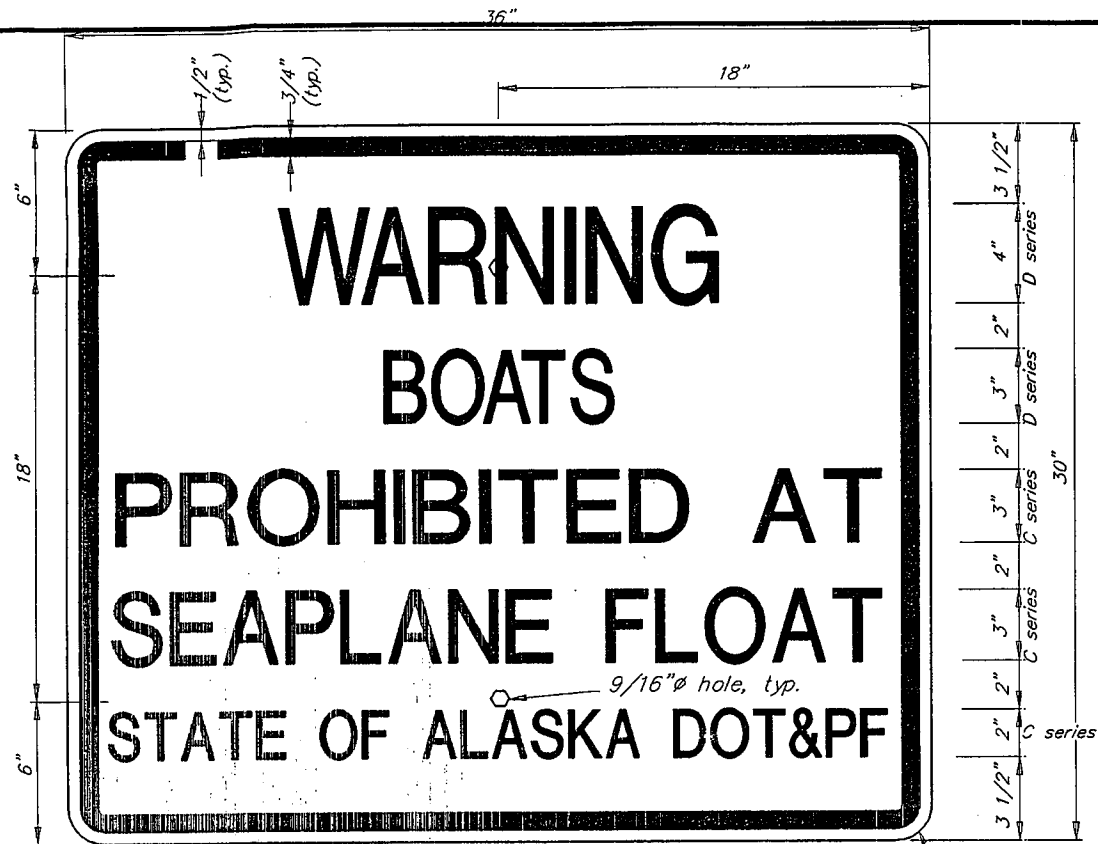


SIGN "A"
1 REQUIRED (1)

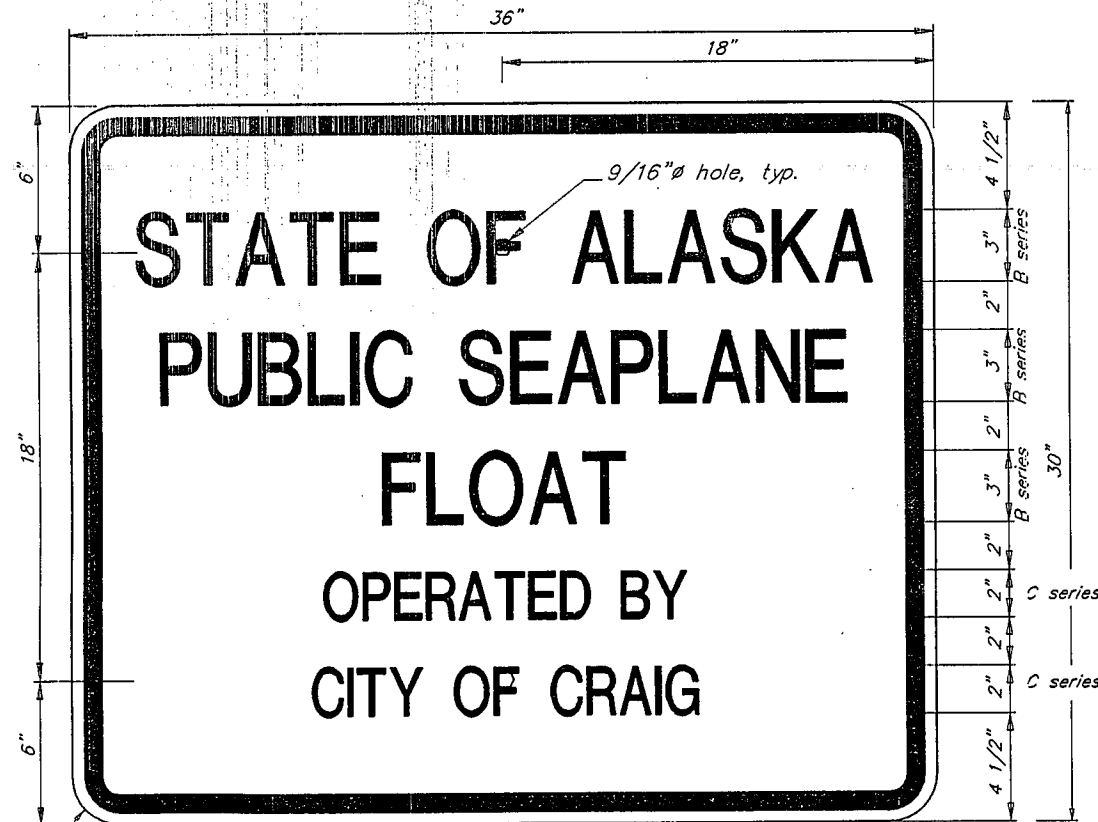


SIGN "B"
1 REQUIRED (2)

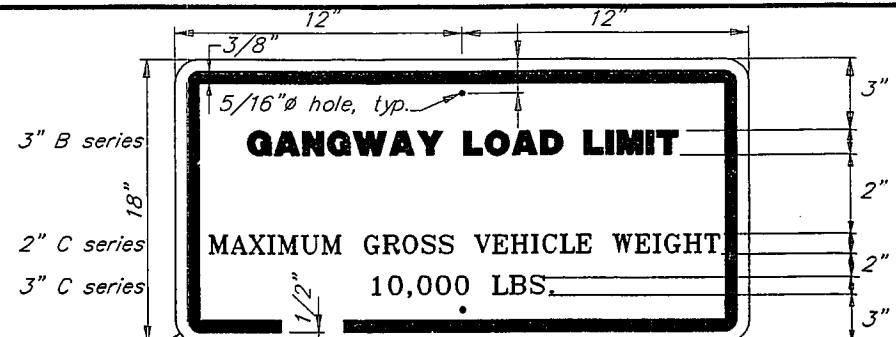


SIGN "C"
1 REQUIRED (3)

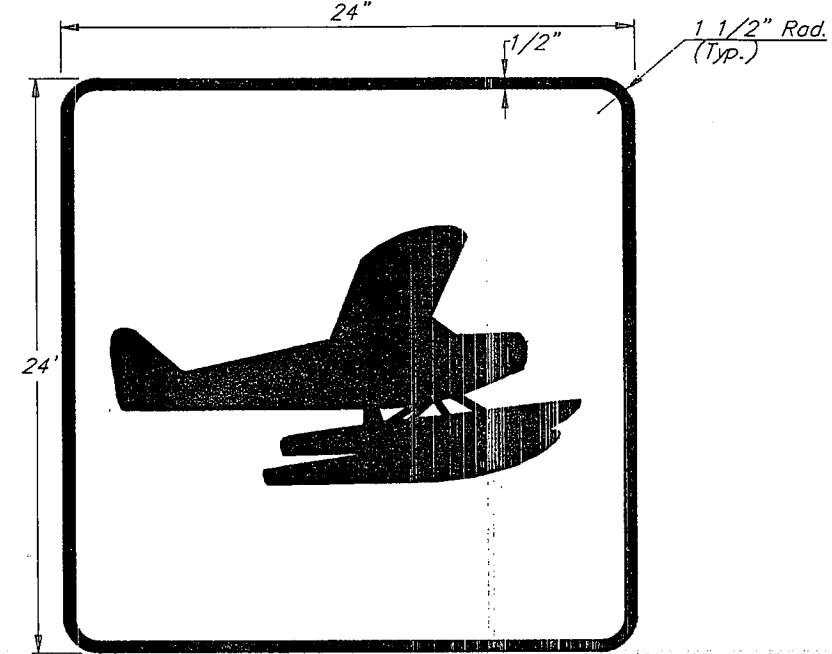

SIGN "D"
2 REQUIRED (4)

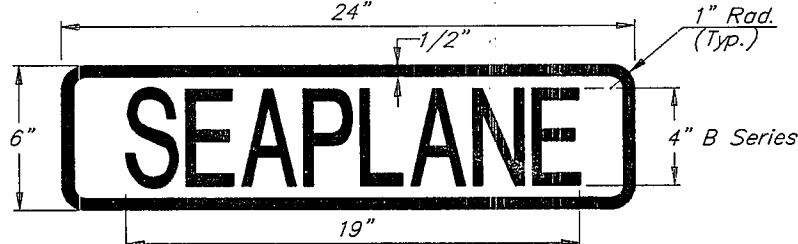

SIGN "E"
2 REQUIRED (5)

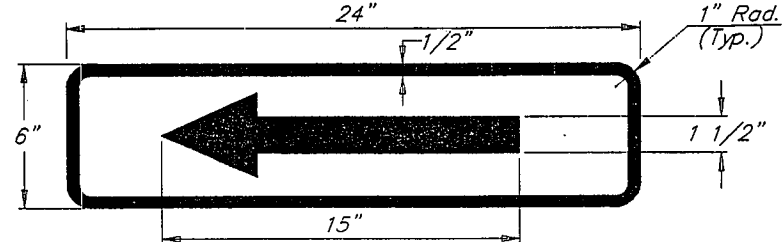

SIGN "F"
2 REQUIRED (6)

PATH : P: CRG SEAPLANE DR SIGNS 1-4		
BY	DATE	DESCRIPTION OF CHANGE


RECORD OF REVISIONS


STATE OF ALASKA
DEPARTMENT OF TRANSPORTATION
AND PUBLIC FACILITIES
SOUTHEAST REGION DESIGN & CONSTRUCTION

CRAIG
CRAIG SEAPLANE BASE EXPANSION
A.I.P # 3-02-0071-01
SIGN DETAILS


ALASKA
DESIGNED BY: D.D.S.
DRAWN BY: B.W.B.
CHECKED BY: D.D.S.

PROJECT No. 69956
DATE: JULY 1994
SHEET 29 OF 60

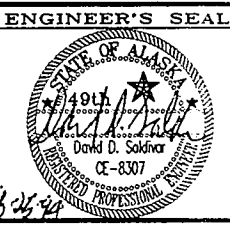

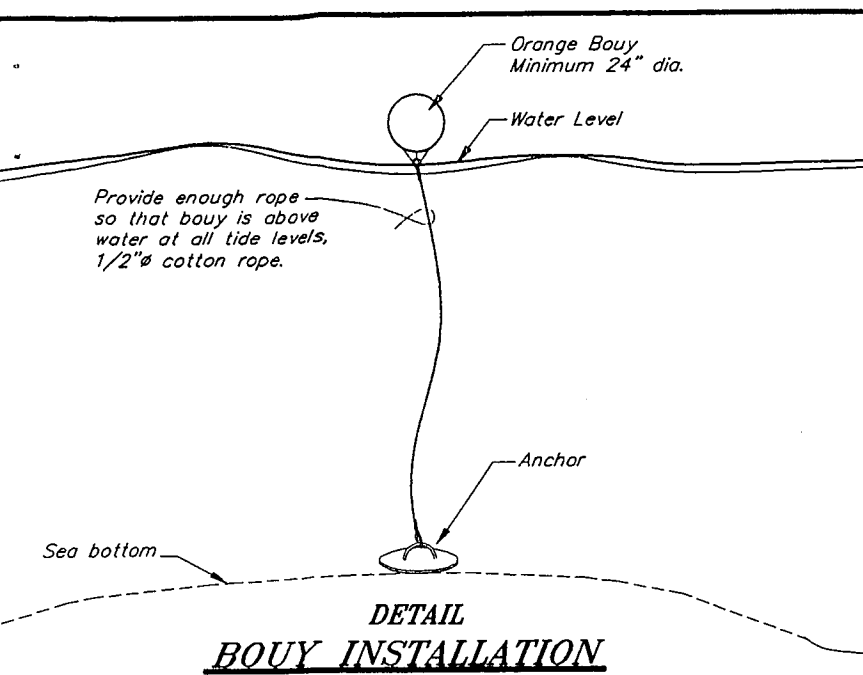

- NOTES:**
1. BOUY FOR TRAFFIC CONTROL SHALL BE SET IN-PLACE PRIOR TO ANY ACTIVITIES IN-WATER.
 2. LOCAL AIRLINES SHALL BE NOTIFIED AT LEAST 24 HOURS PRIOR TO THE START OF PILE DRIVING.
 3. BOUYS SHALL BE MAINTAINED DURING CONSTRUCTION OF THE FACILITY. ANY LOST OR DAMAGED BOUYS SHALL BE REPLACED.
 4. IN-WATER TRAFFIC CONTROL SHALL REMAIN IN-PLACE UNTIL THE EXISTING SEAPLANE FLOAT IS REMOVED.
 5. LOCAL BUSINESSES AND RESIDENCE SHALL REMAIN ACCESSIBLE AT ALL TIMES.
 6. EXISTING ROADWAY TO THE FACILITY SHALL BE MAINTAINED BY THE CONTRACTOR. POTHOLES SHALL BE LEVELED AND GRADED AT THE END OF EACH WORK SHIFT OR WHEN NEEDED AS DIRECTED BY THE ENGINEER.

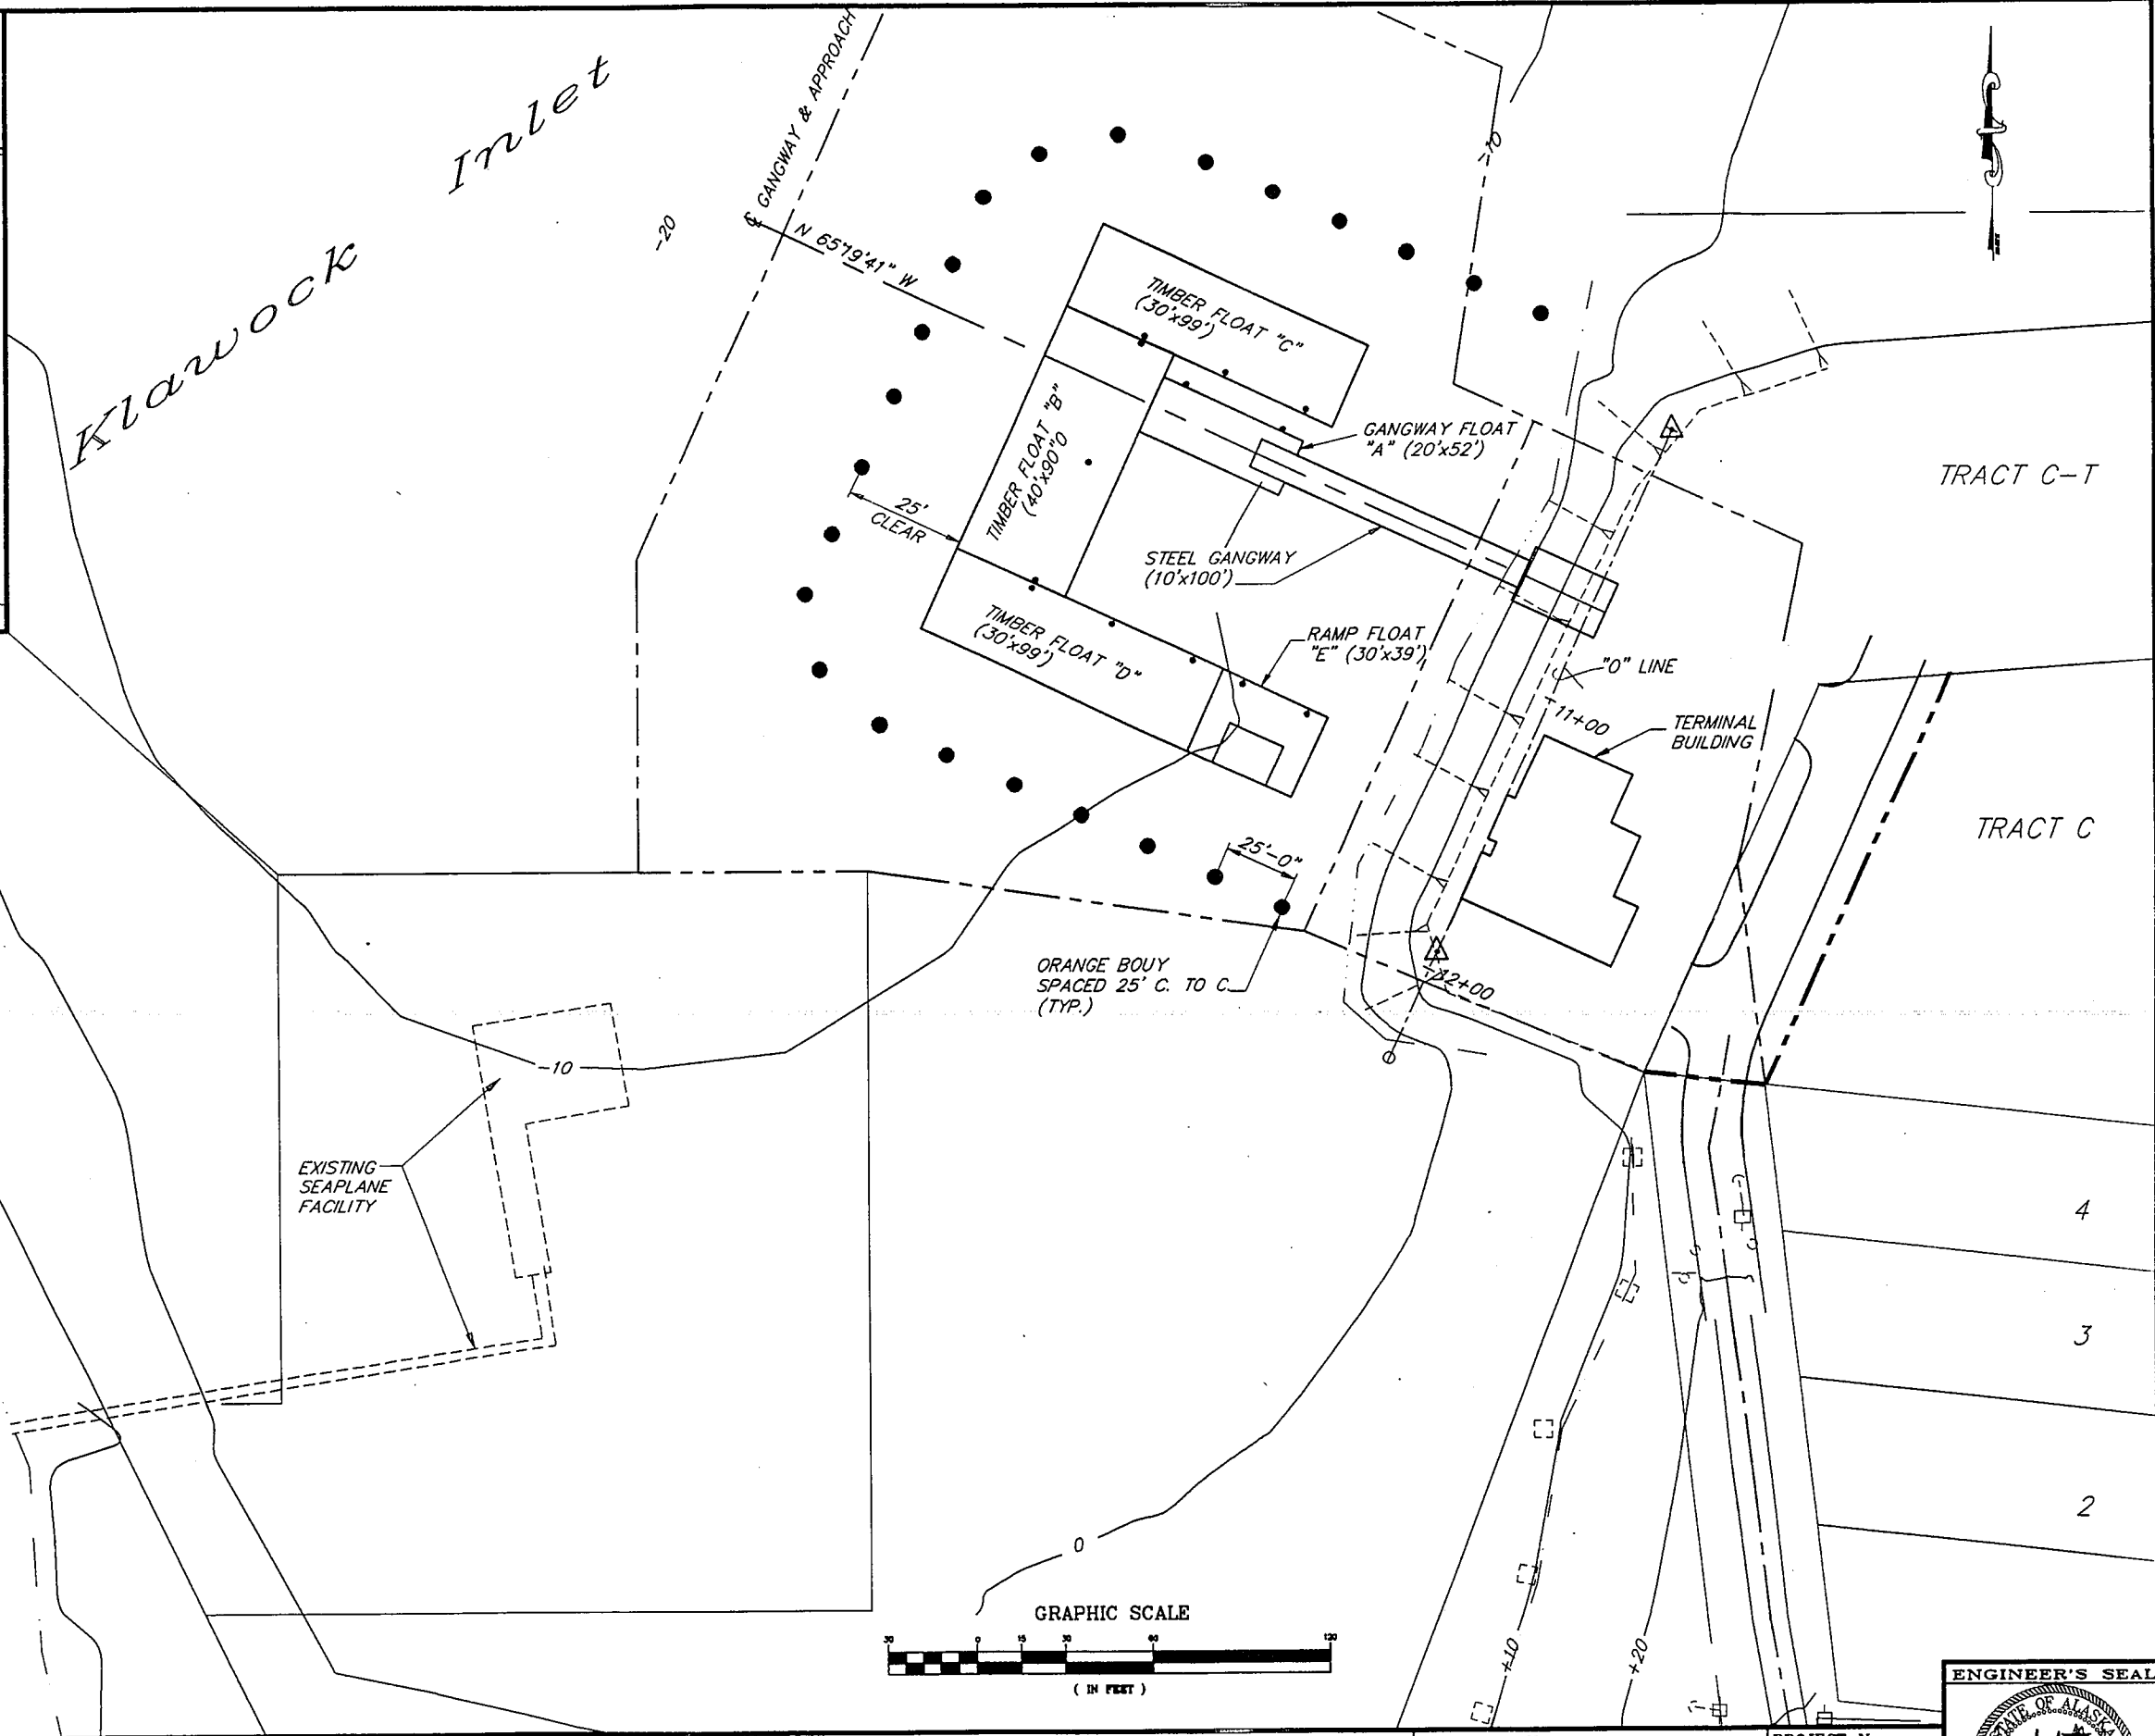


PATH : P:\CRG\SEAPL\DR\TRAFCONT.dwg < 1-30 >		
BY	DATE	DESCRIPTION OF CHANGE

STATE OF ALASKA
 DEPARTMENT OF TRANSPORTATION
 AND PUBLIC FACILITIES
 SOUTHEAST REGION DESIGN & CONSTRUCTION

CRAIG
 CRAIG SEAPLANE BASE EXPANSION
 A.I.P. # 3-02-0071-01
TRAFFIC CONTROL PLAN

DESIGNED BY: D.D.S.	PROJECT No. 69956
DRAWN BY: R.K.S./ B.W.B.	DATE: JULY 1994
CHECKED BY: C.A.B.	SHEET 30 OF 60

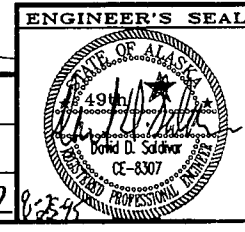

CODE USED:
UNIFORM BUILDING CODE, 1991 EDITION

OCCUPANCY TYPE
B.2

TYPE OF CONSTRUCTION:
TYPE V-N
NO REQUIREMENTS FOR FIRE RESISTANCE IN EXTERIOR WALLS, STRUCTURAL FRAME OR INTERIOR CONSTRUCTION BASED ON OCCUPANCY OR TYPE OF CONSTRUCTION

NO REQUIREMENTS FOR FIRE RESISTANCE IN EXTERIOR WALLS OR OPENINGS IN EXTERIOR WALLS BASED ON LOCATION ON PROPERTY.


OCCUPANT LOAD:
318 SF WAITING @ 3 SF/OCCUPANT= 106 OCC
1500 SF @ OFFICES @ 100 SF/OCCUPANT=15 OCC

MINIMUM 2 EXITS REQUIRED AT WAITING AREA
ONE EXIT REQUIRED AT EACH OFFICE AREA


BUILDING AREA
ALLOWABLE AREA: 8000 SF
ACTUAL AREA: 2,770 SF

BUILDING HEIGHT:
ALLOWABLE: 40', 2 STORY
ACTUAL: 18', 1 STORY


1 CODE DATA

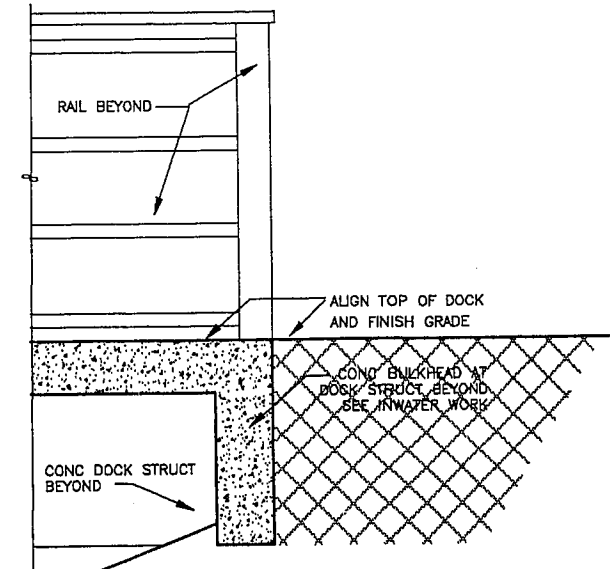


3 RETAINING WALL AT DOCK STRUCTURE

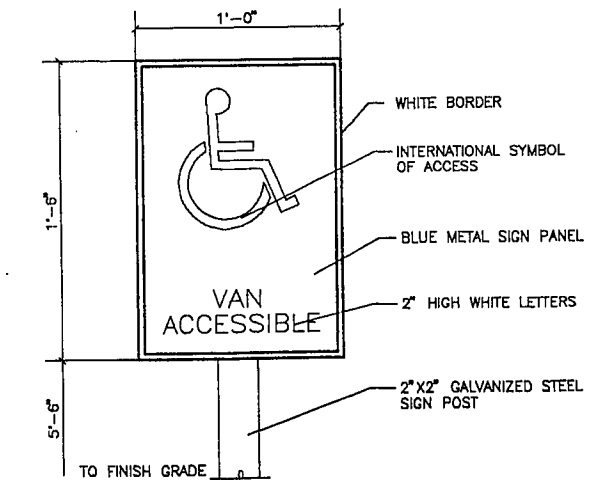

2 ACCESSIBLE PARKING SIGN

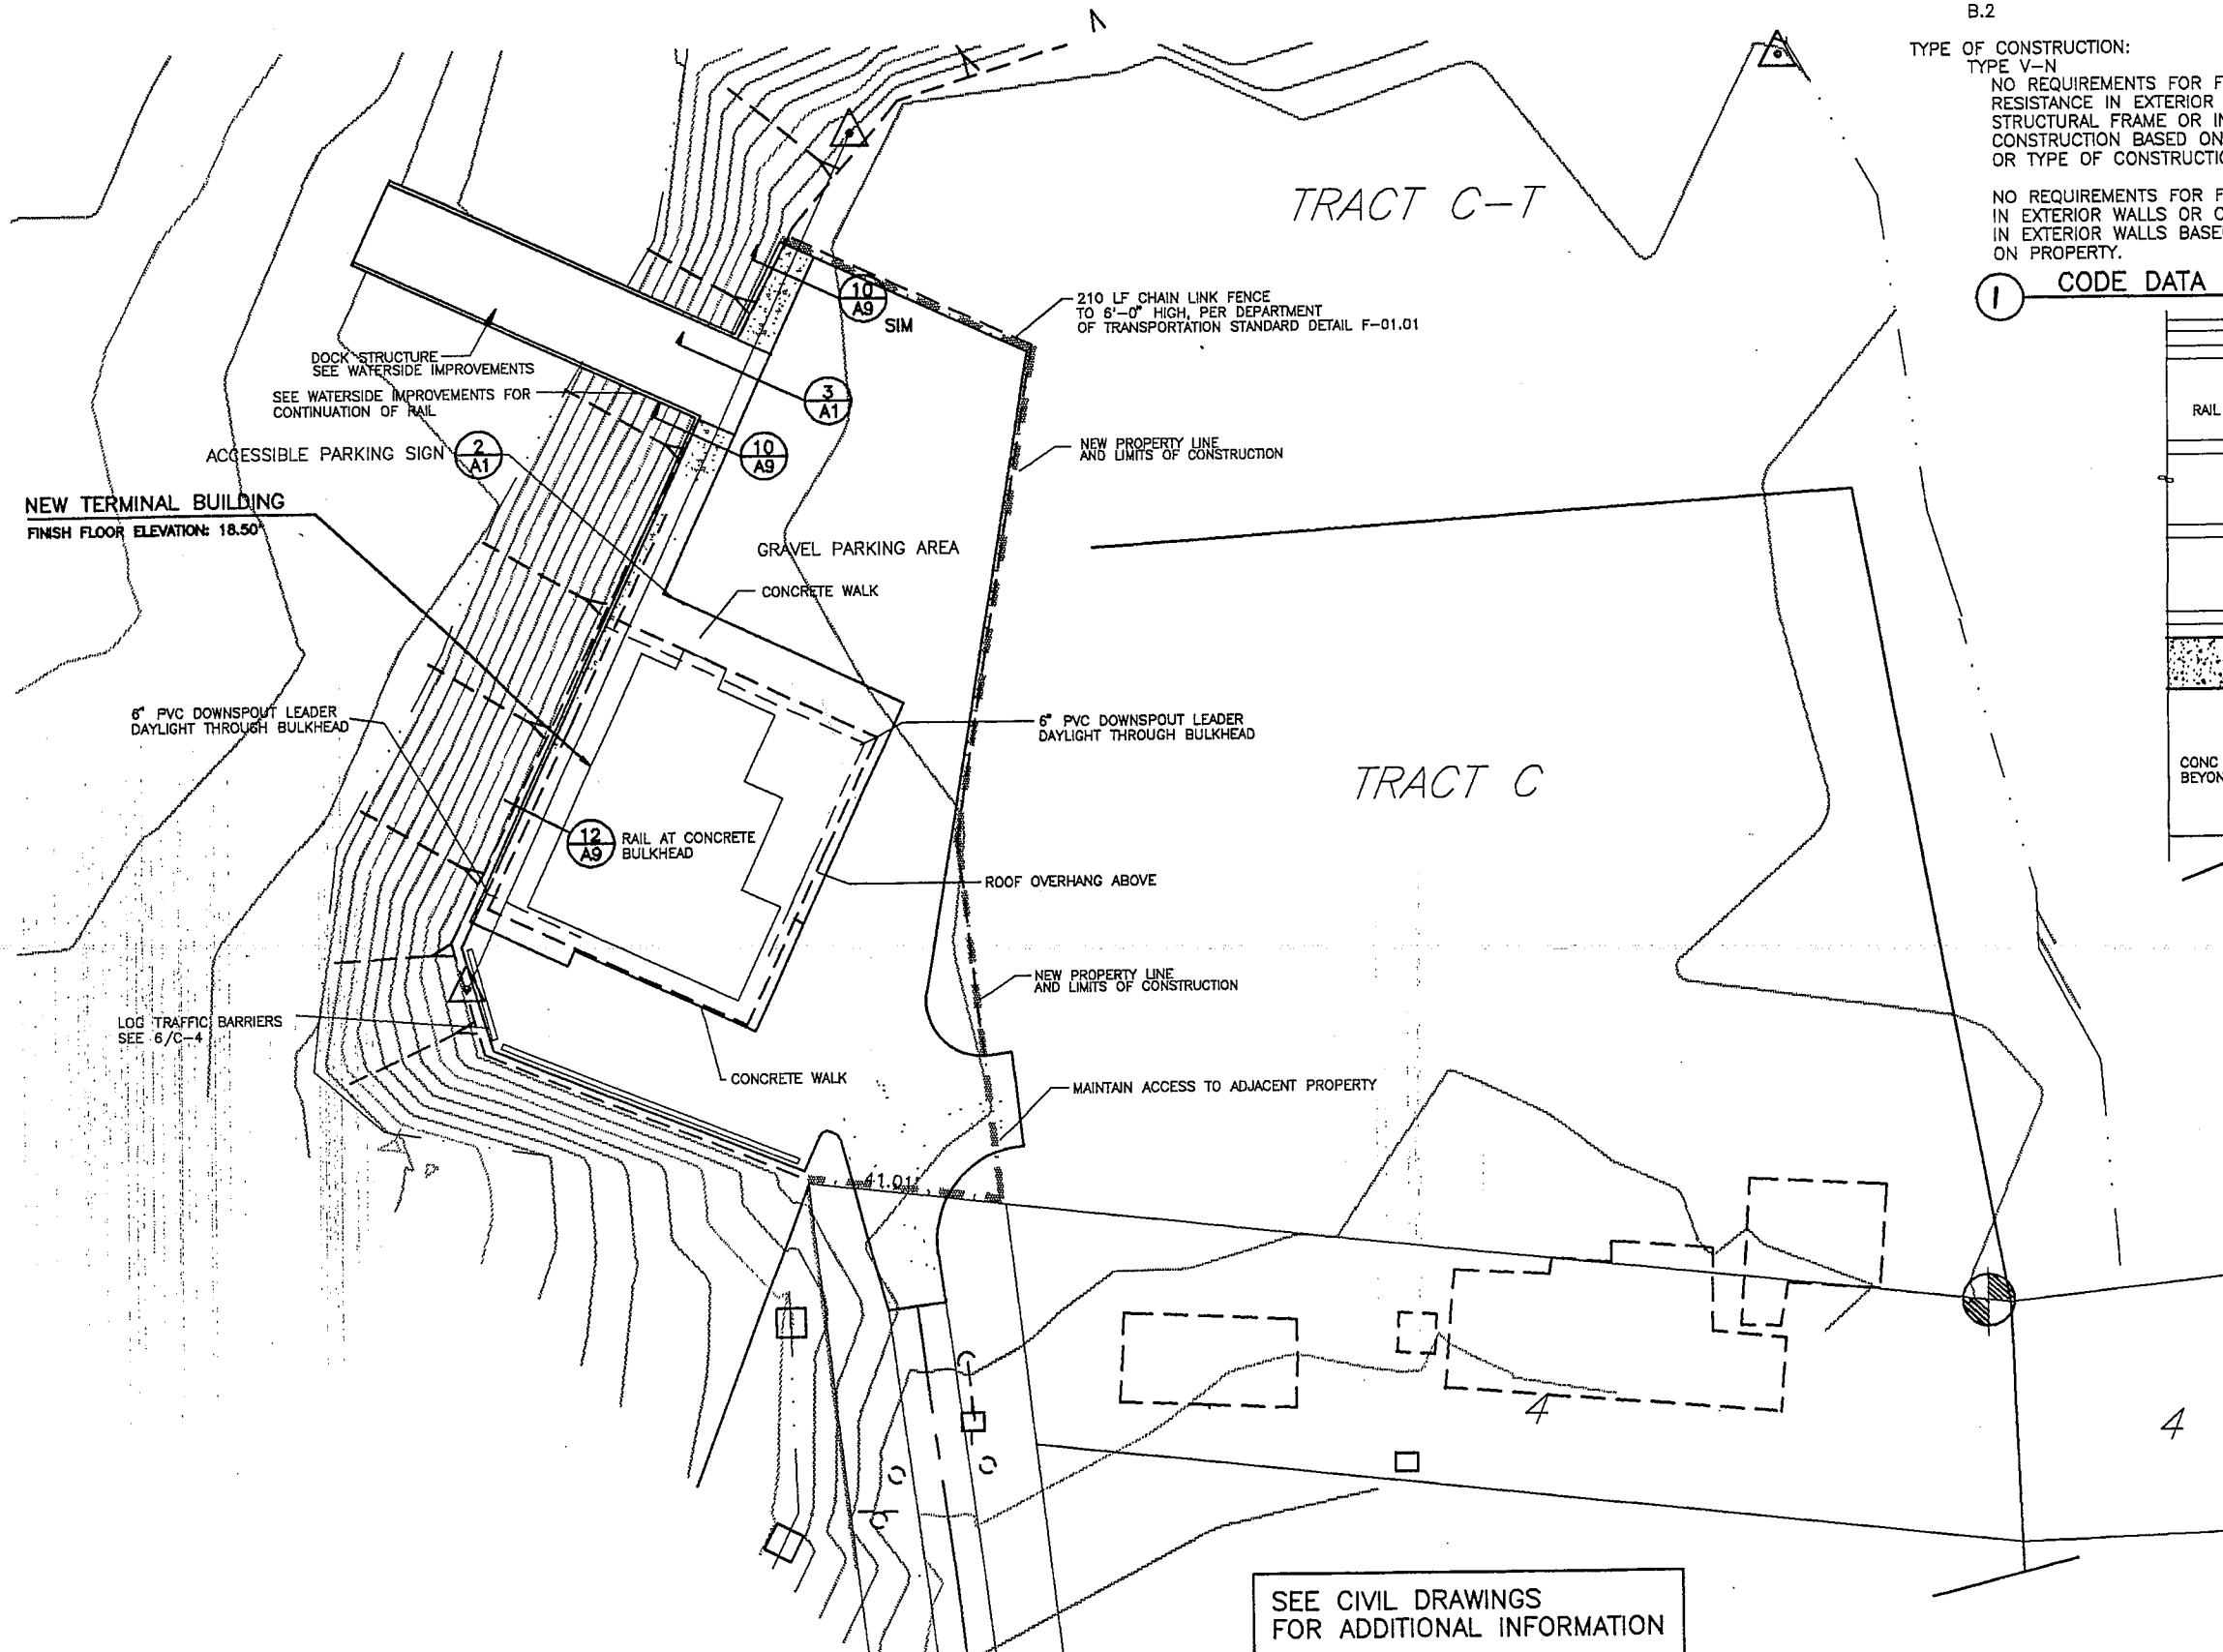

SEE CIVIL DRAWINGS FOR ADDITIONAL INFORMATION

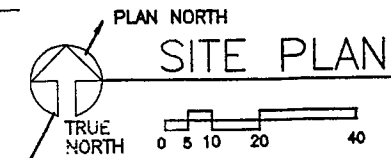

DRAWING A1

RECORD OF REVISIONS		
DATE	BY	DESCRIPTION OF CHANGE

STATE OF ALASKA
DEPARTMENT OF TRANSPORTATION
AND PUBLIC FACILITIES
SOUTHEAST REGION DESIGN & CONSTRUCTION


CRAIG
CRAIG SEAPLANE BASE EXPANSION
AIP # 3-02-0071-01
SITE PLAN

ALASKA

DESIGNED BY:
DRAWN BY:
CHECKED BY:




PROJECT NO. 69956
DATE: 8-94
SHEET 31 OF 60



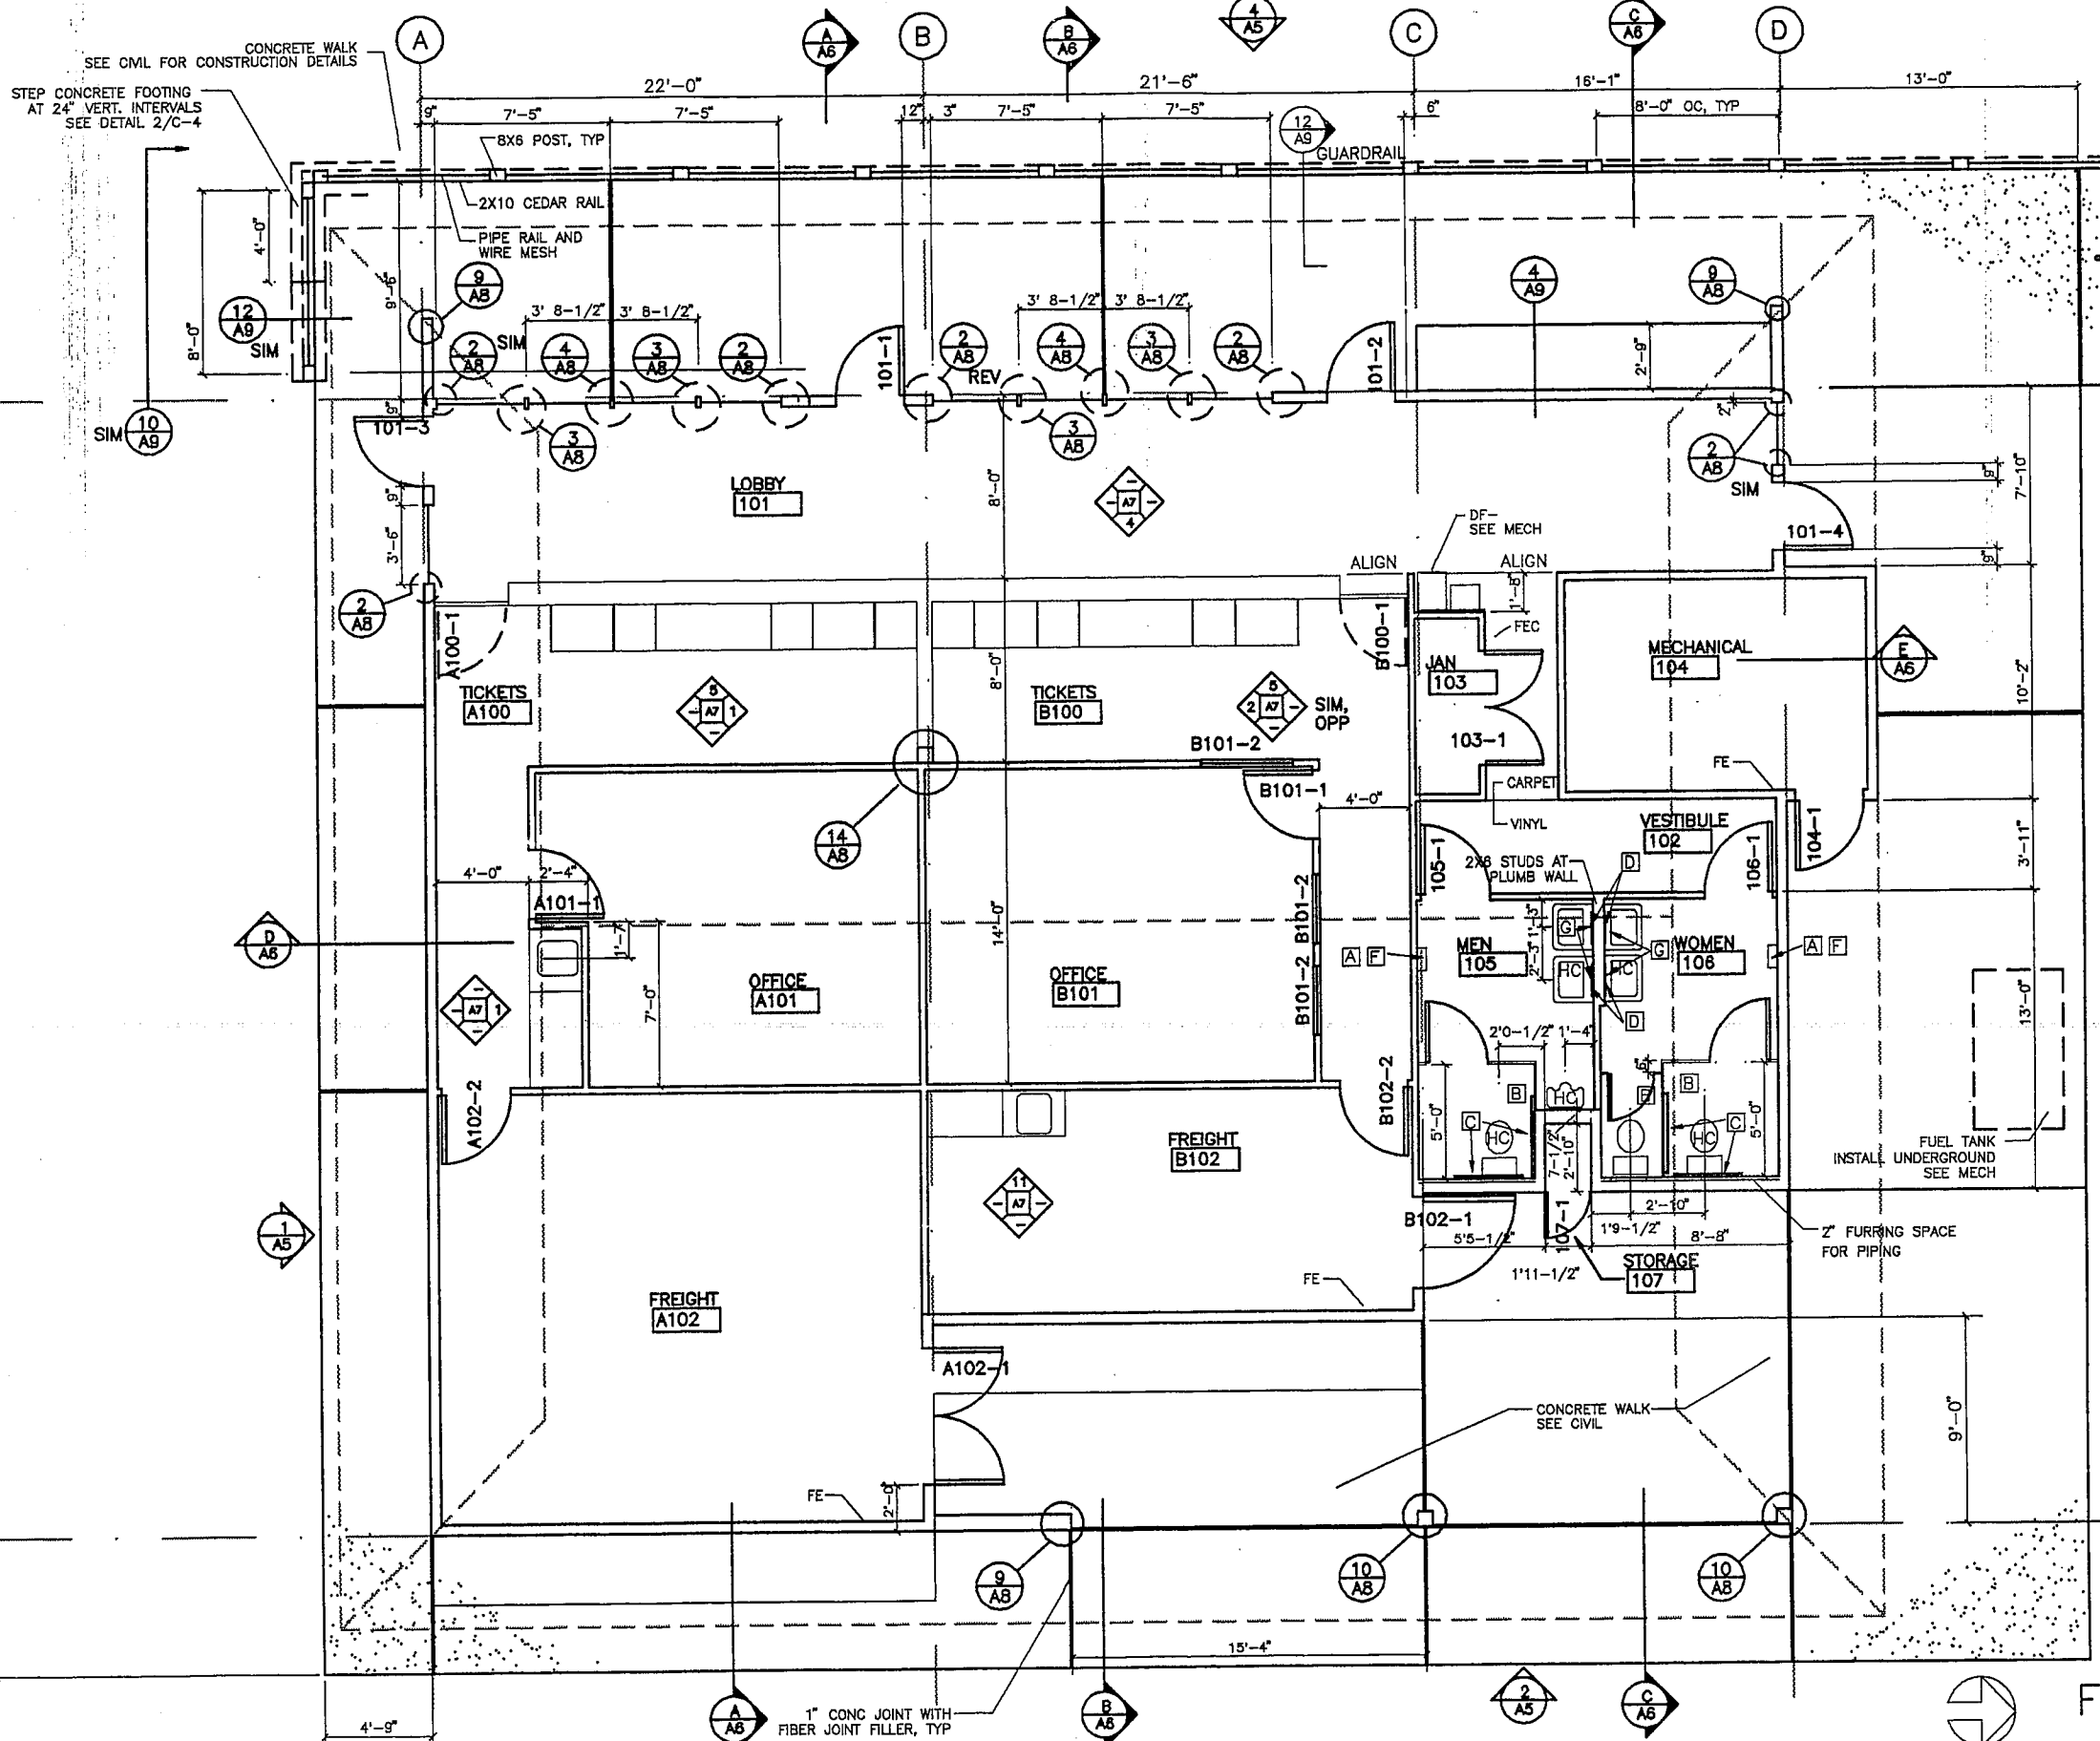

ACCESSORY	MODEL NO.	REMARKS
A	PAPER TOWEL DISPENSER B262	
B	TOILET PAPER DISPENSER B2730	
C	GRAB BAR B6206	36" REAR/42" SIDE
D	MIRROR B290	24" X 30"
E	MOP HOLDER B224	36"
F	WASTE RECEPTACLE B3649	W/ LINER
G	SOAP DISPENSER B112	

NOTE: ALL MODEL NUMBERS ARE BY BOBRICK WASHROOM EQUIPMENT AND ARE LISTED FOR REFERENCE ONLY

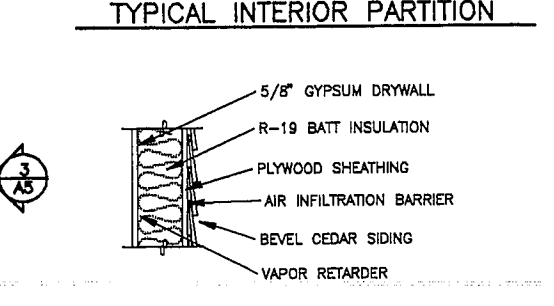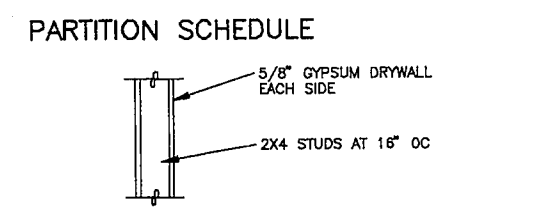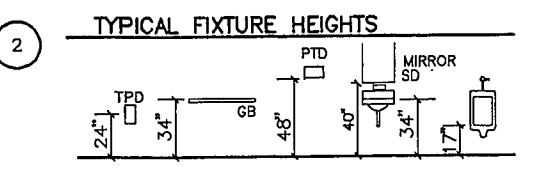

TYPICAL EXTERIOR WALL

NOTES

ALL INTERIOR PARTITIONS CONTINUOUS TO UNDERSIDE OF TRUSSES ABOVE.


SET INTERIOR SILLS IN DOUBLE BEAD OF SEALANT

PROVIDE 2X BLOCKING FOR ALL WALL MOUNTED EQUIPMENT.

SEE STRUCTURAL FOR ADDITIONAL FRAMING REQUIREMENTS.

FUR WALLS WITH 2X WOOD FURRING WHERE SHOWN ON PLANS. PLACE VAPOR BARRIER AT INSIDE FACE OF EXTERIOR STUDS

FE FIRE EXTINGUISHER, WALL MOUNTED
 FEC FIRE EXTINGUISHER AND CABINET
 HC HANDICAPPED ACCESSIBLE

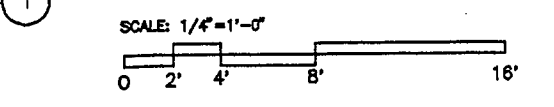

DRAWING A-2

FLOOR PLAN

RECORD OF REVISIONS		
DATE	DESCRIPTION OF CHANGE	BY


STATE OF ALASKA
 DEPARTMENT OF TRANSPORTATION
 AND PUBLIC FACILITIES
 SOUTHEAST REGION DESIGN & CONSTRUCTION


CRAIG
 CRAIG SEAPLANE BASE EXPANSION
 AIP # 3-02-0071-01
 FLOOR PLAN

ALASKA




DESIGNED BY:
 DRAWN BY:
 CHECKED BY:

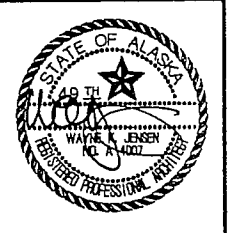PROJECT NO.
 69956
 DATE:
 8-94
 SHEET 32 OF 60

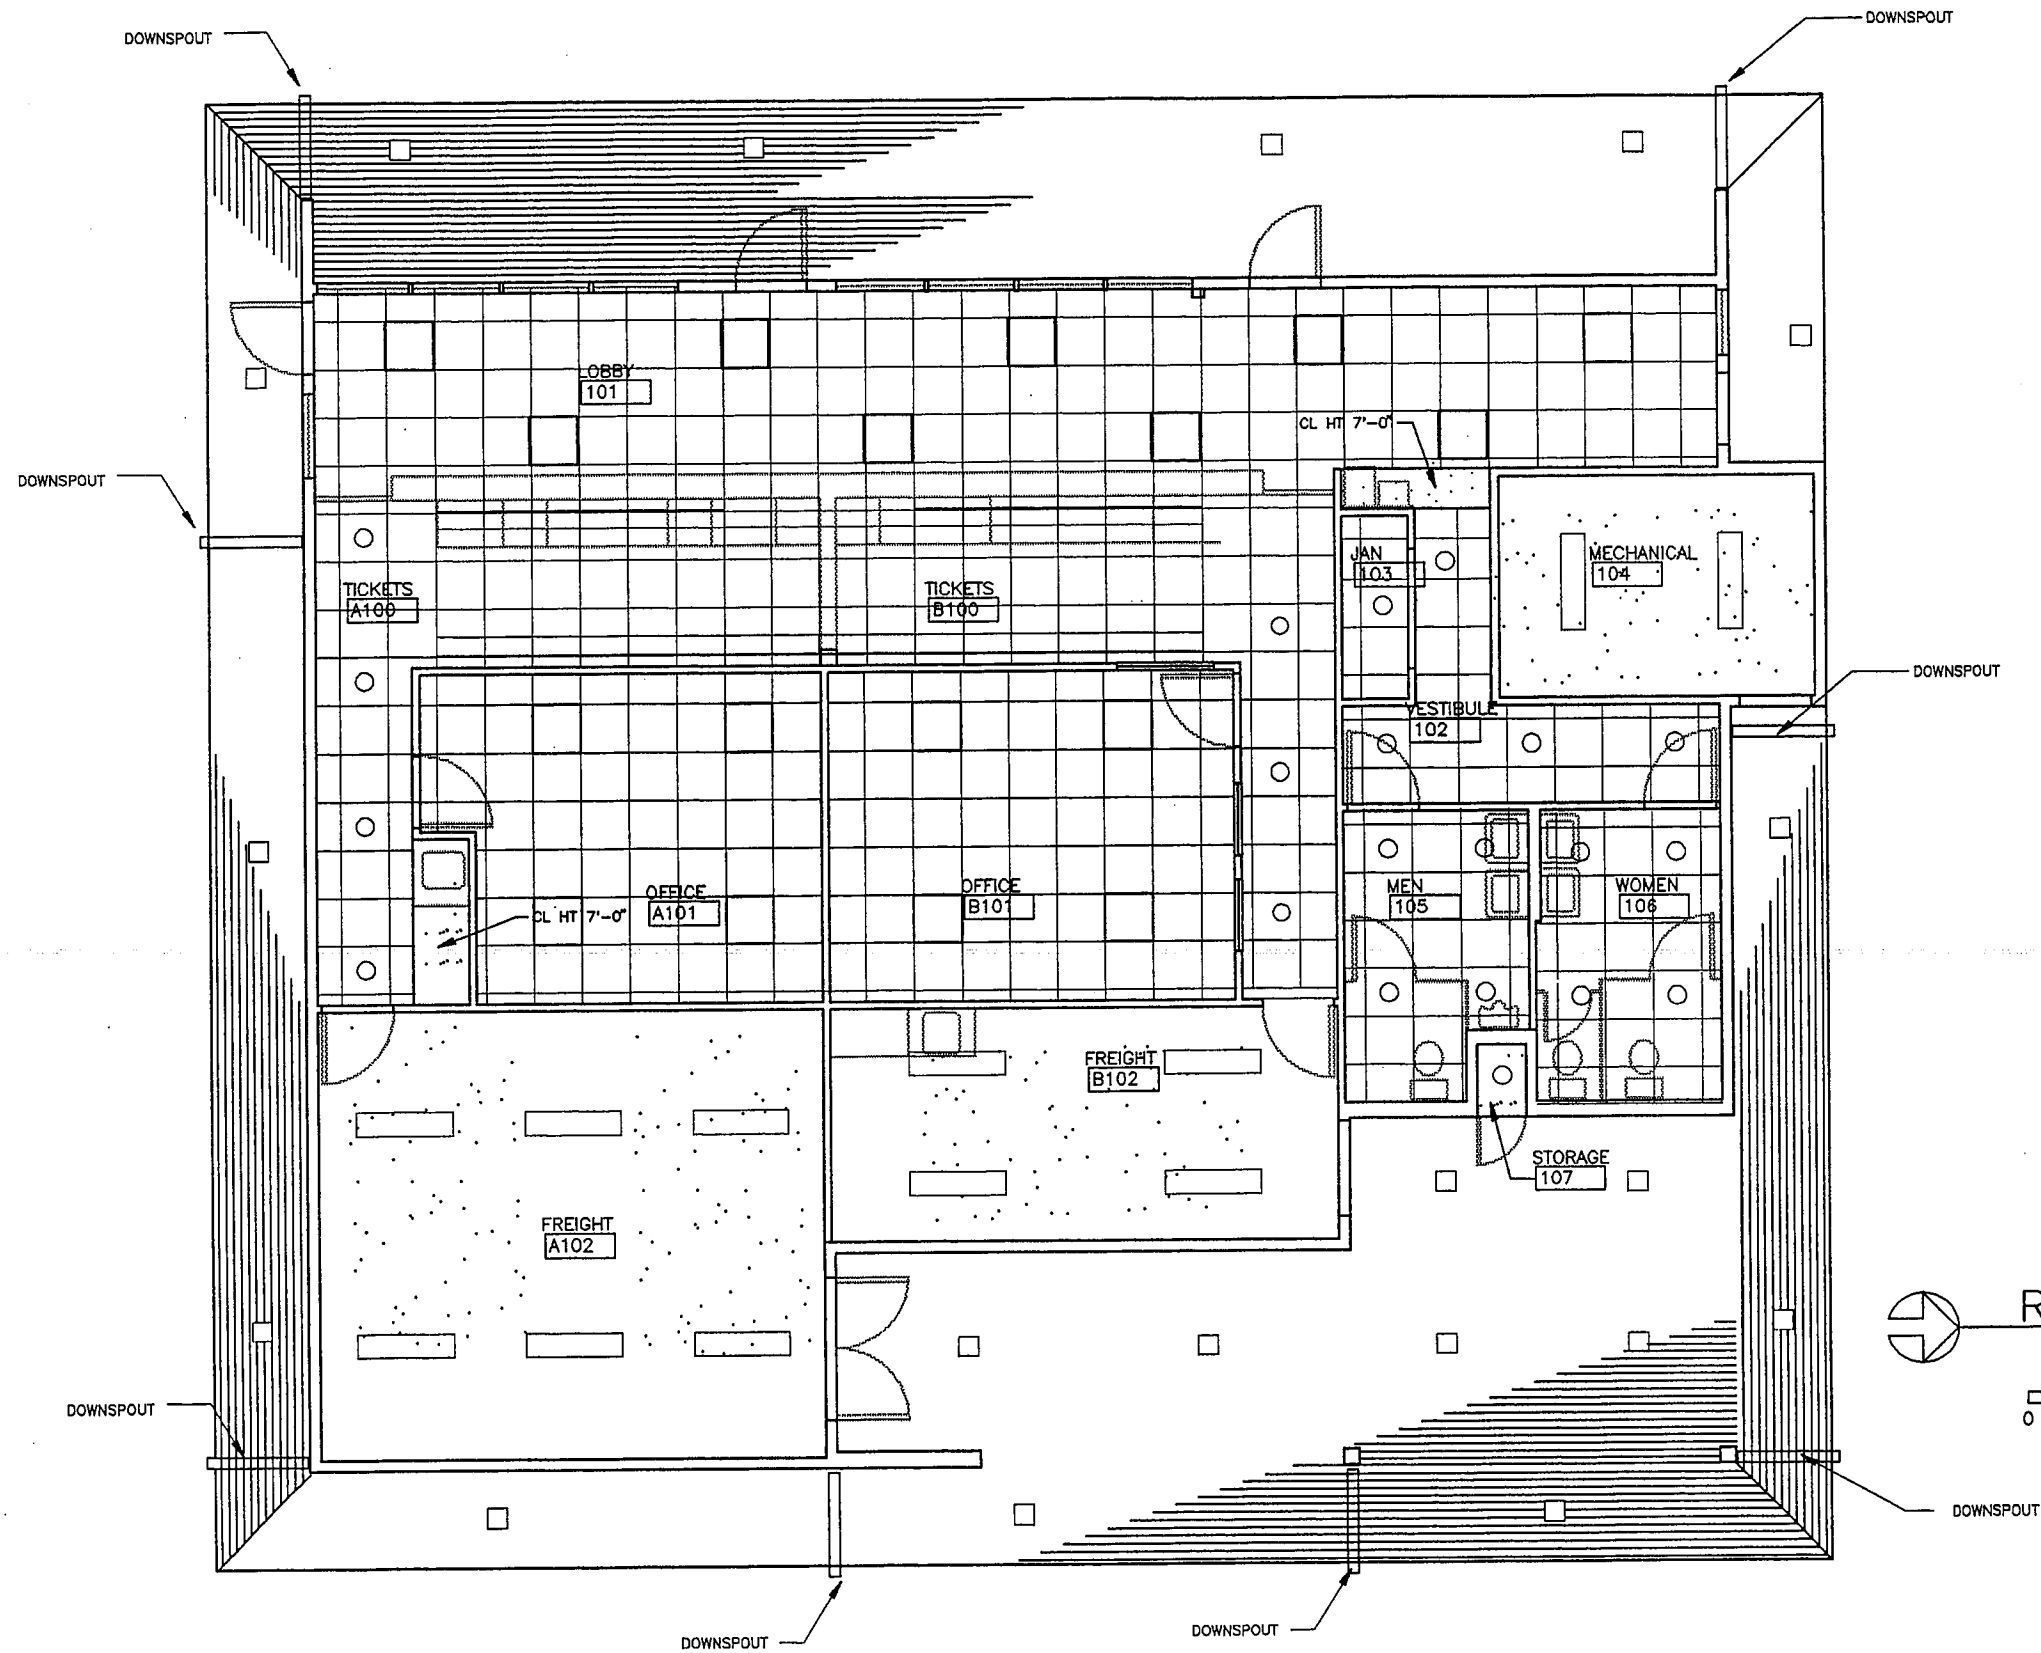

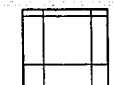


LEGEND

-  ACOUSTICAL PANEL
CEILING AT 8'-0" AFF
-  GYPSUM DRYWALL CEILING
ON BOTTOM OF TRUSSES
UNLESS OTHERWISE NOTED
-  WOOD SOFFIT
1X4 T&G CEDAR



REFLECTED CEILING PLAN

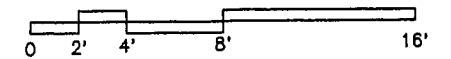

DRAWING A-3

NOTE:

DO NOT SCALE
FROM THESE PLANS-
USE DIMENSIONS

RECORD OF REVISIONS		
PATH:	DATE:	DESCRIPTION OF CHANGE:

STATE OF ALASKA
**DEPARTMENT OF TRANSPORTATION
 AND PUBLIC FACILITIES**
 SOUTHEAST REGION DESIGN & CONSTRUCTION


CRAIG


CRAIG SEAPLANE BASE EXPANSION
 AIP # 3-02-0071-01
REFLECTED CEILING PLAN

ALASKA

DESIGNED BY:
 DRAWN BY:
 CHECKED BY:

PROJECT NO.
 69956
 DATE:
 8-94
 SHEET 33 OF 60

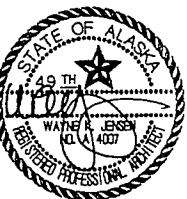


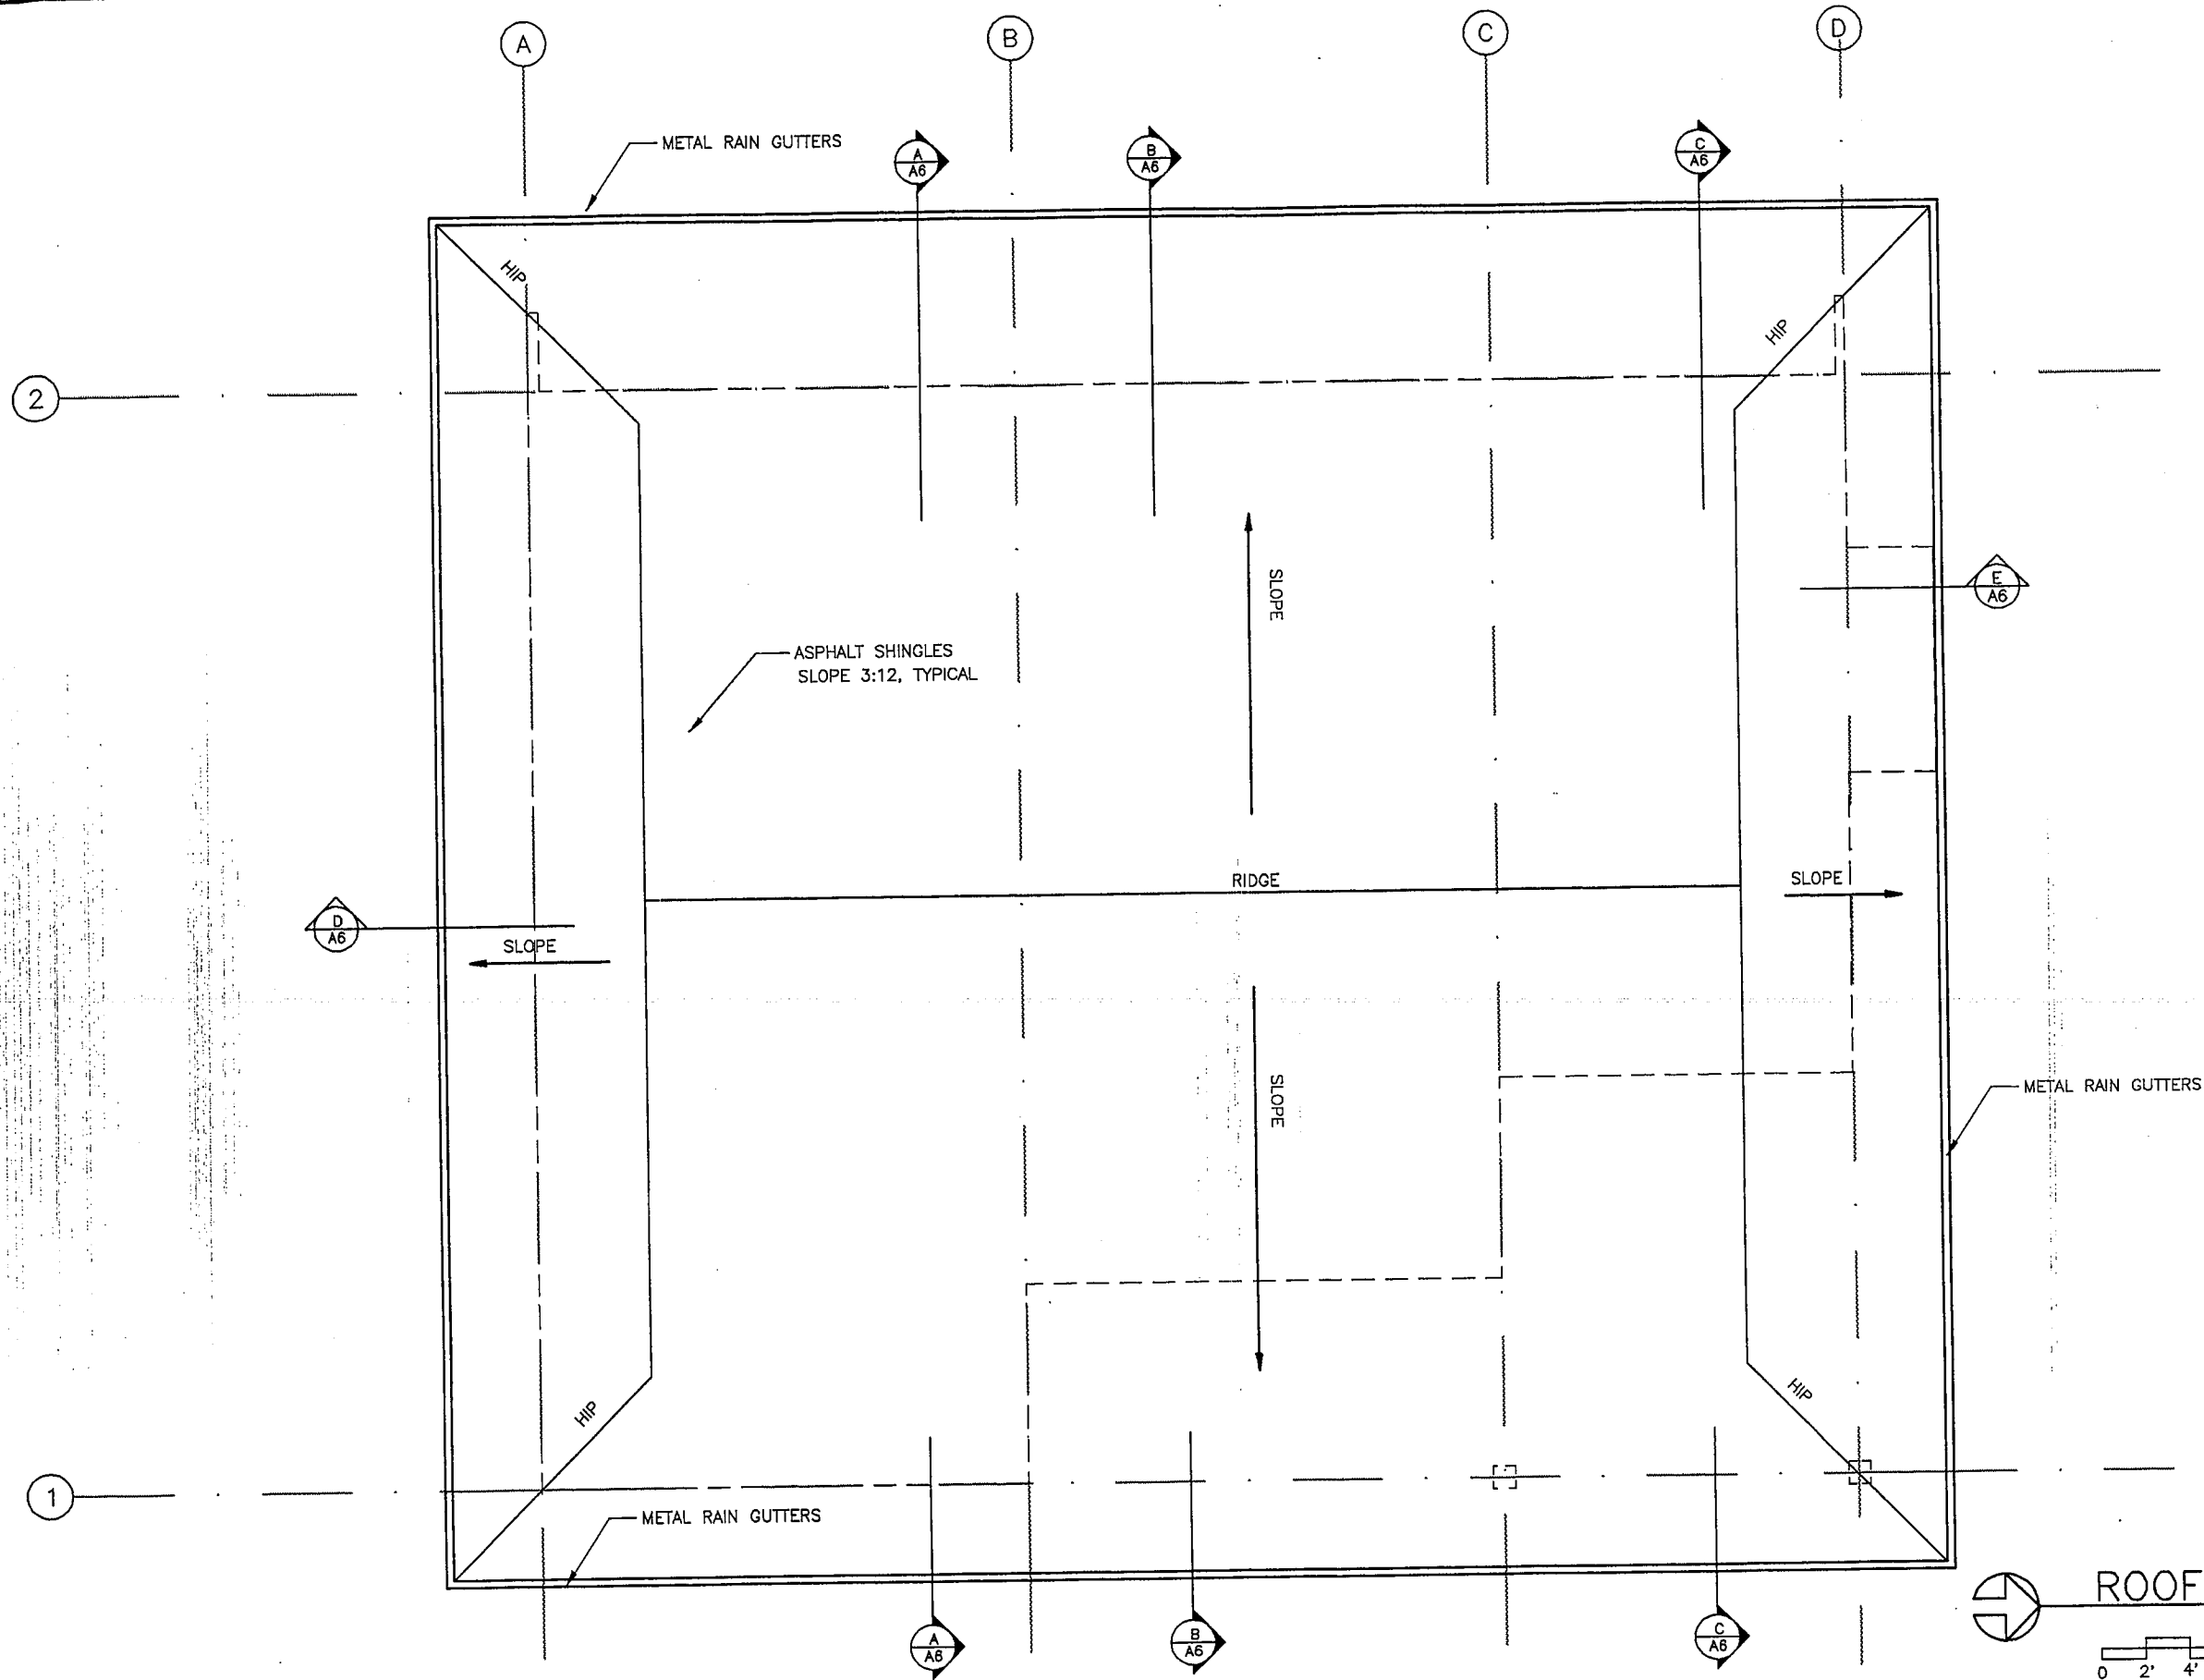


DRAWING A-4

NOTE:

DO NOT SCALE FROM THESE PLANS - USE DIMENSIONS

ROOF PLAN

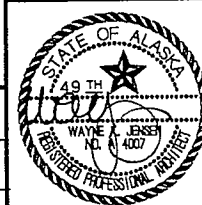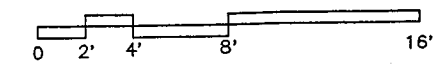

RECORD OF REVISIONS		
NO.	DATE	DESCRIPTION OF CHANGE

STATE OF ALASKA
 DEPARTMENT OF TRANSPORTATION
 AND PUBLIC FACILITIES
 SOUTHEAST REGION DESIGN & CONSTRUCTION

CRAIG

CRAIG SEAPLANE BASE EXPANSION

AIP # 3-02-0071-01

ROOF PLAN

ALASKA

DESIGNED BY:

DRAWN BY:

CHECKED BY:




PROJECT NO.

DATE:

SHEET 34 OF 60

69956

8-94

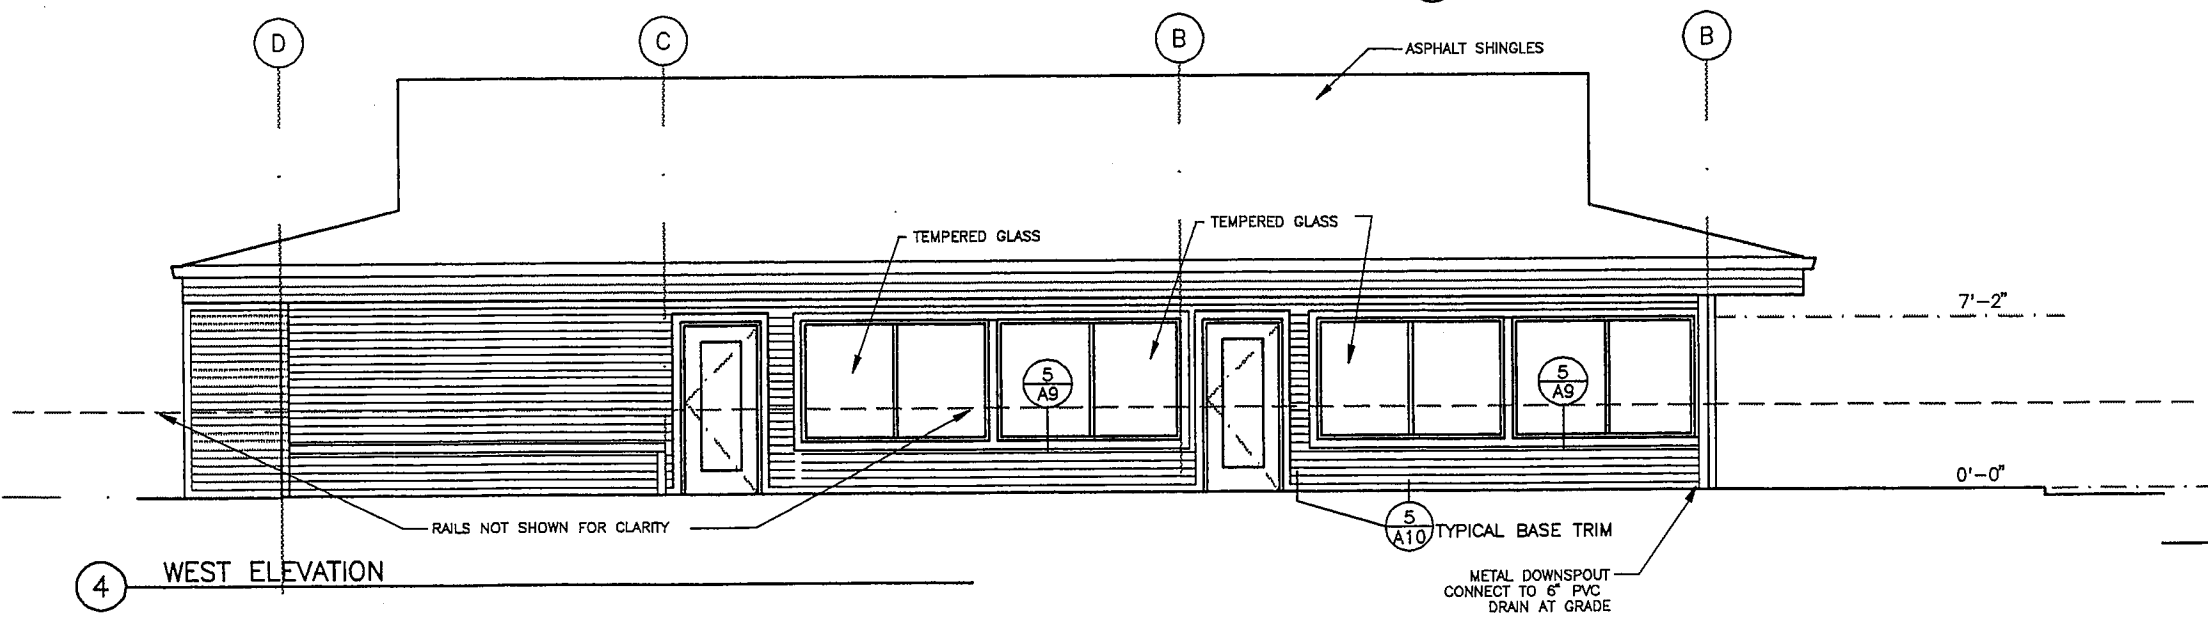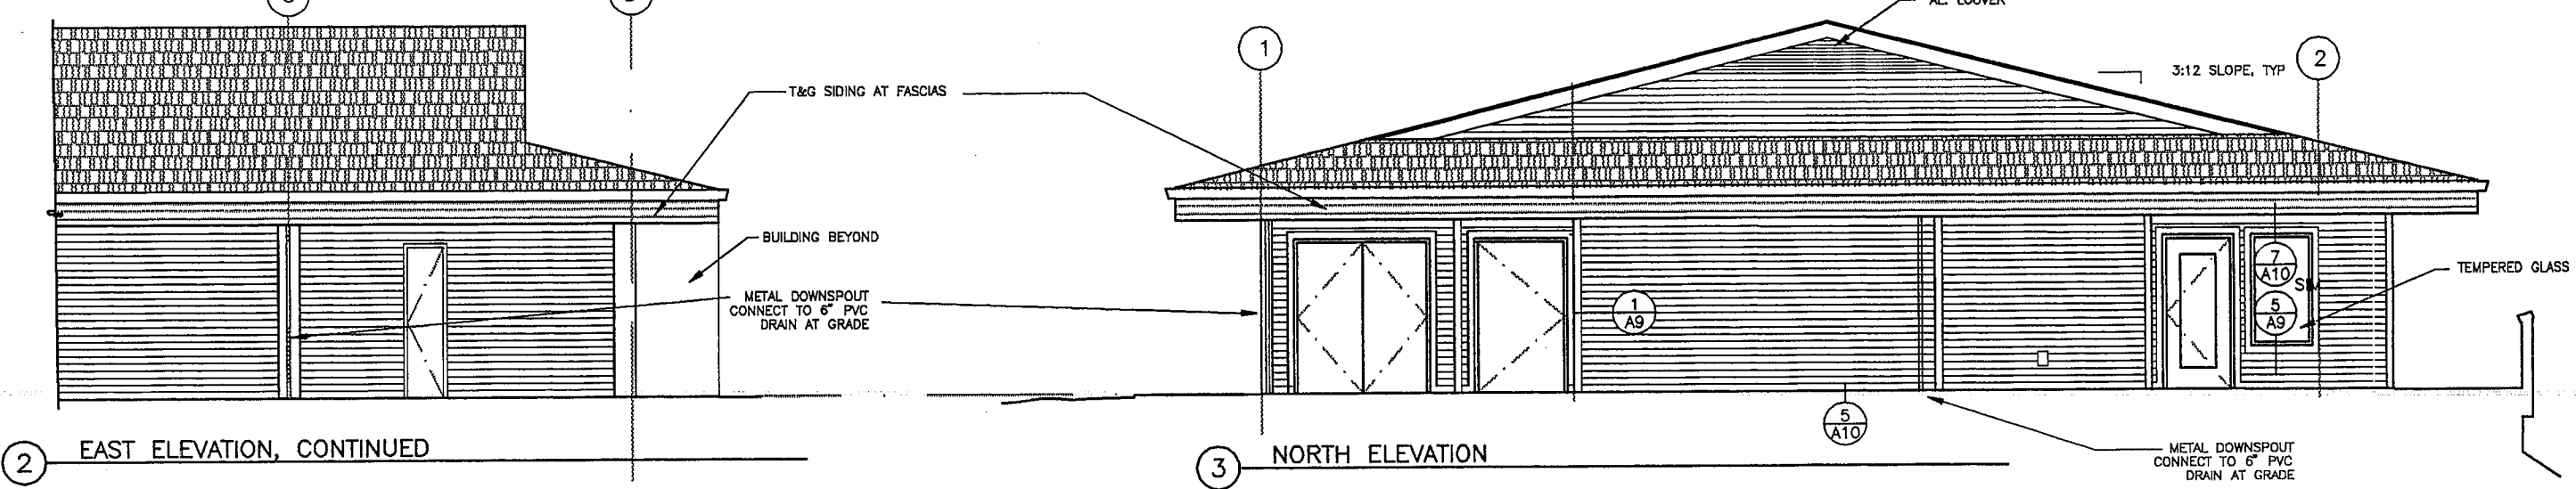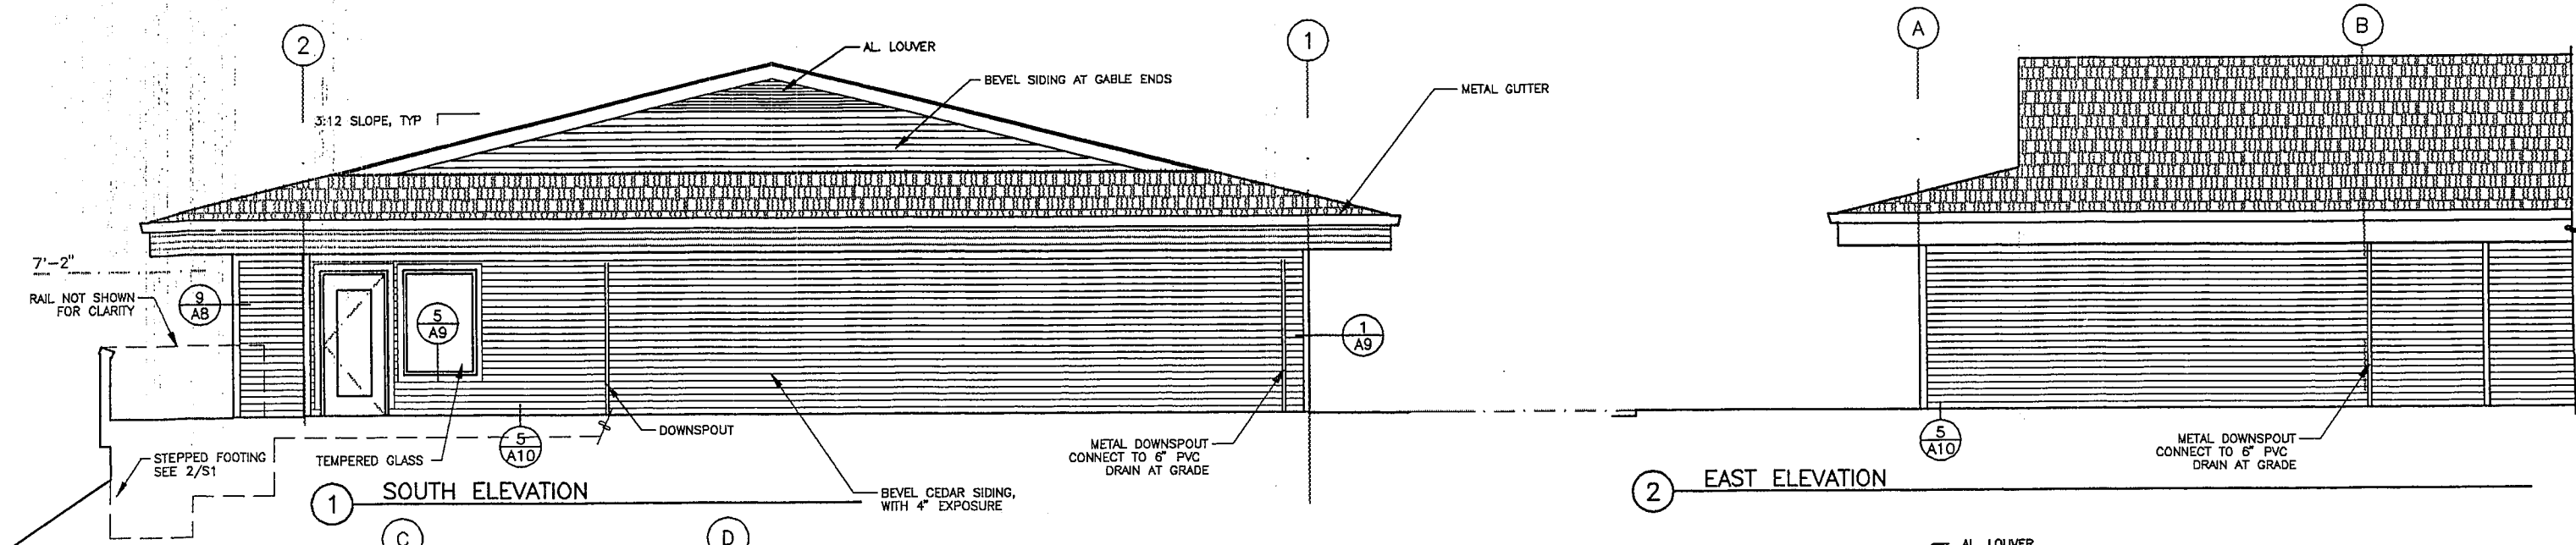

DRAWING A-5

NOTE:
DO NOT SCALE FROM THESE PLANS—USE DIMENSIONS

EXTERIOR ELEVATIONS

0' 2' 4' 8' 16'


PATH:		DESCRIPTION OF CHANGE:
BY:	DATE:	


RECORD OF REVISIONS

STATE OF ALASKA
DEPARTMENT OF TRANSPORTATION
AND PUBLIC FACILITIES
SOUTHEAST REGION DESIGN & CONSTRUCTION


CRAIG
CRAIG SEAPLANE BASE EXPANSION
AIP # 3-02-0071-01
EXTERIOR ELEVATIONS

DESIGNED BY:	PROJECT NO. 69956
DRAWN BY:	DATE: 8-94
CHECKED BY:	SHEET 35 OF 60

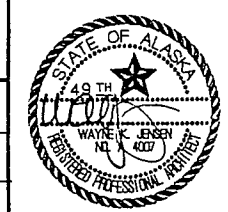


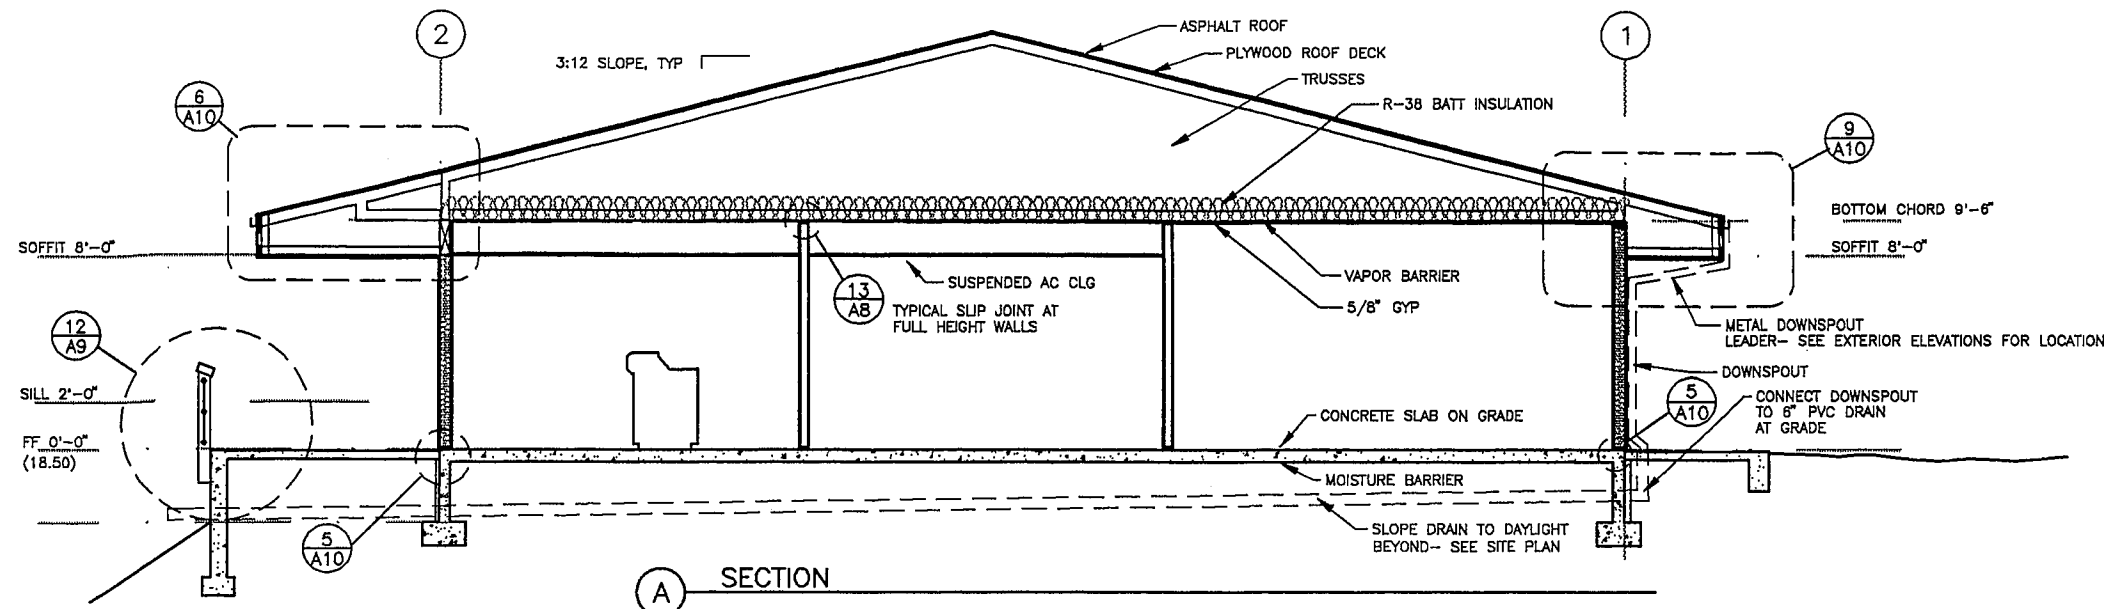


A SECTION

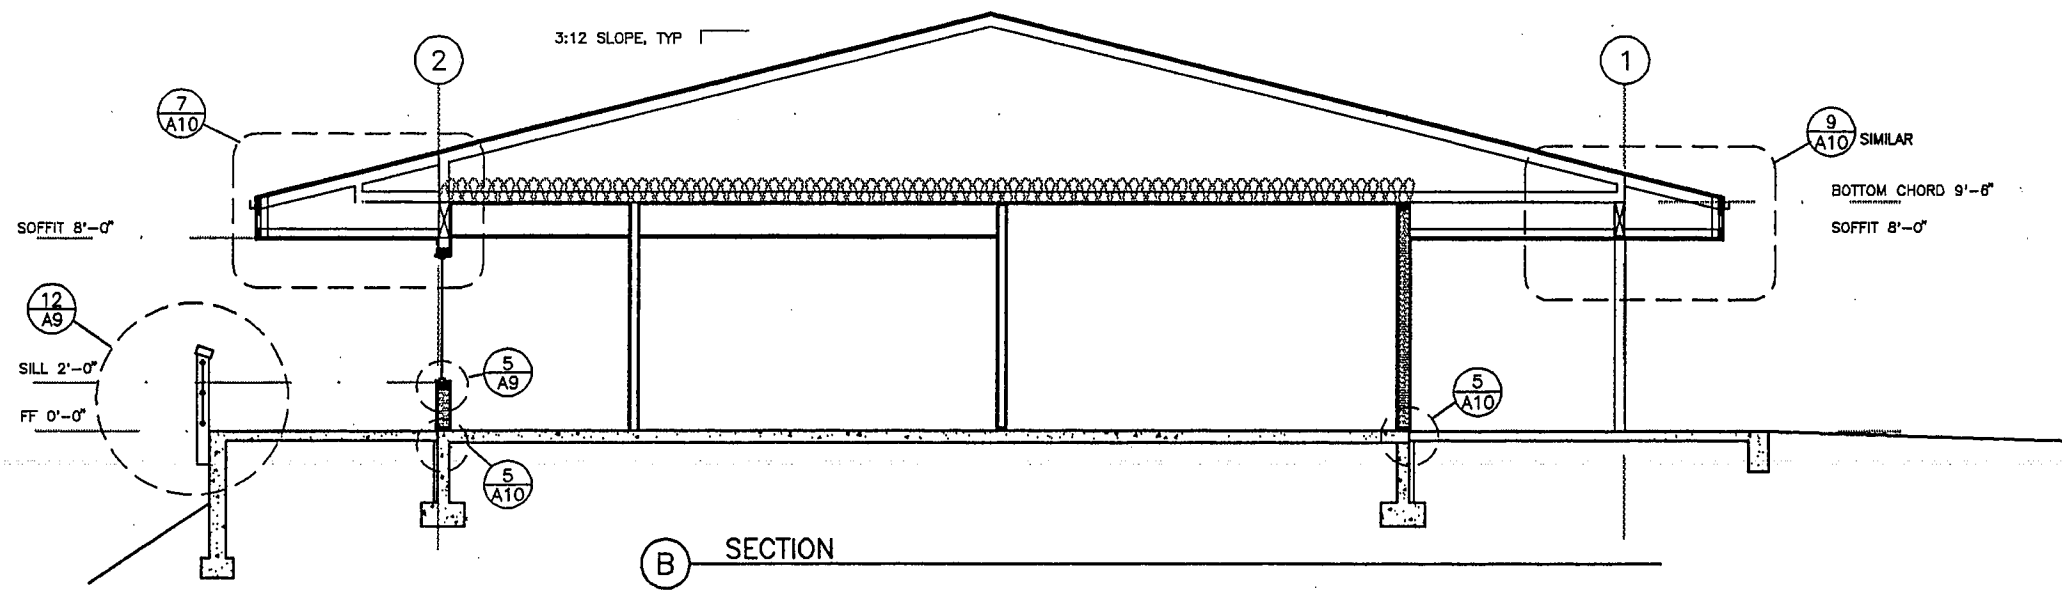


B SECTION

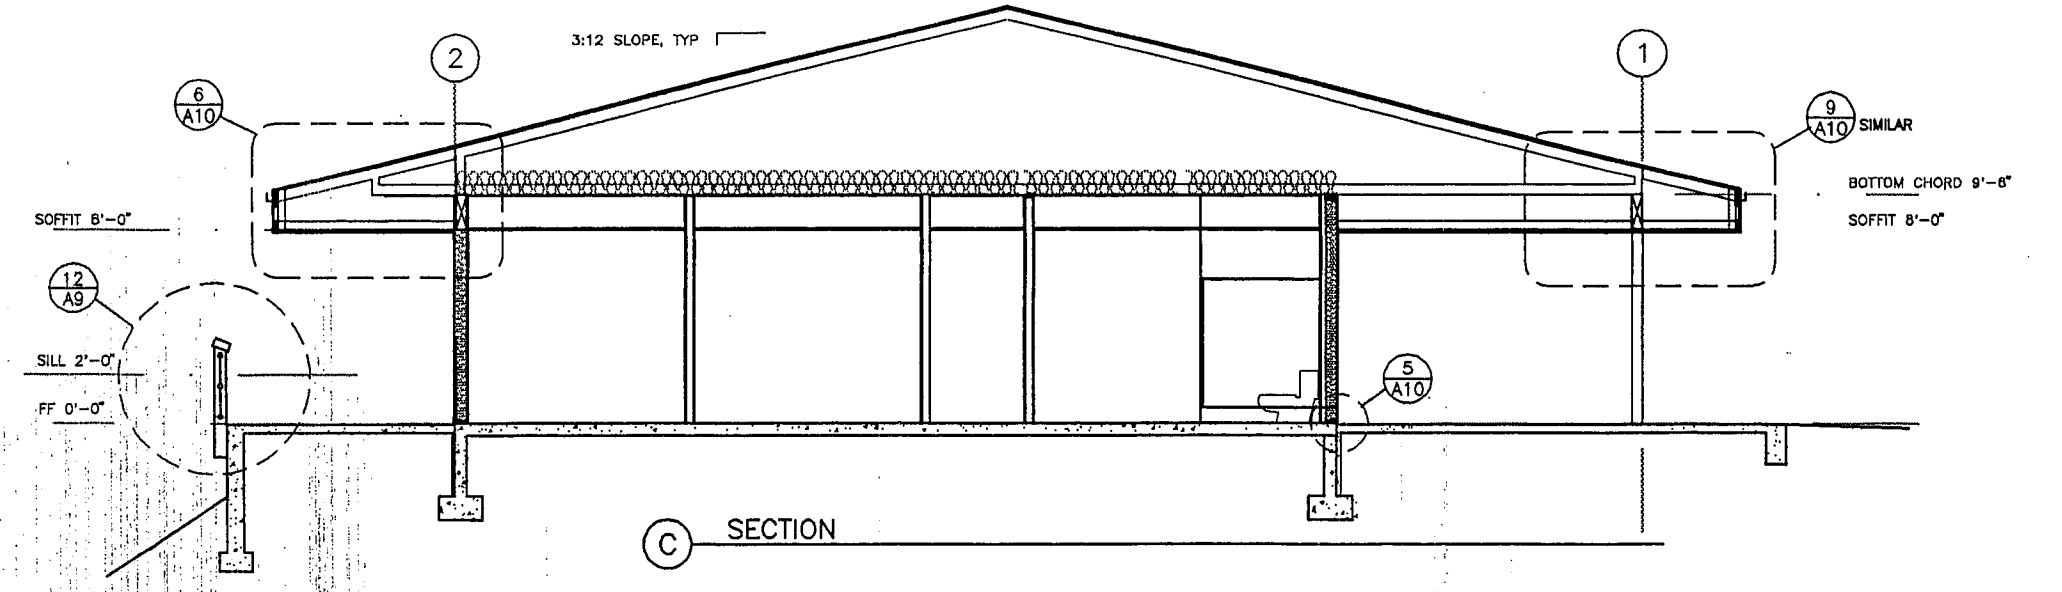

C SECTION

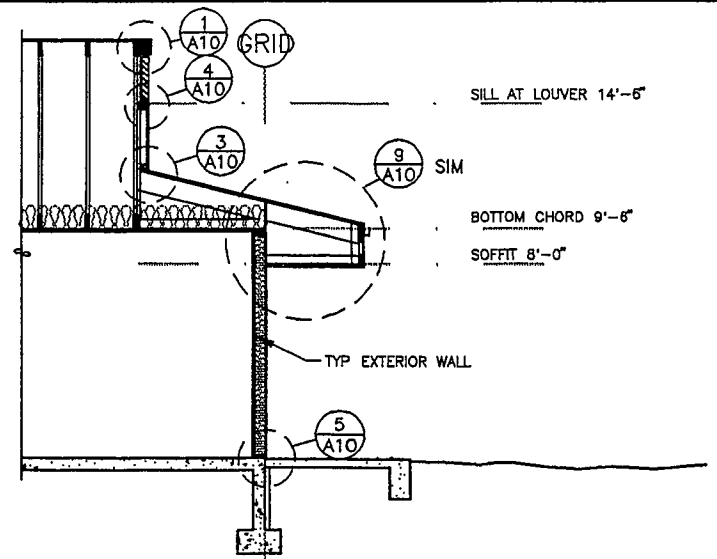


D GABLE END SECTION

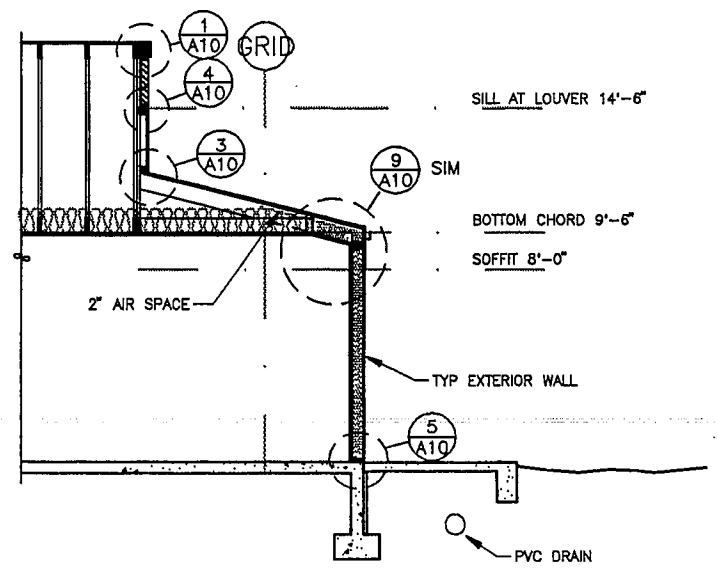


E GABLE END SECTION

BUILDING SECTIONS

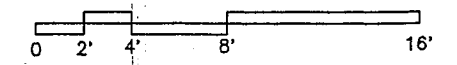

DRAWING A-6

NOTE:
DO NOT SCALE
FROM THESE PLANS-
USE DIMENSIONS

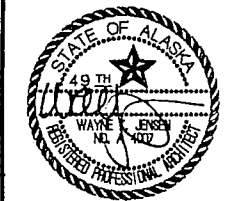

PATH:		DESCRIPTION OF CHANGE:
BY:	DATE:	
RECORD OF REVISIONS		


STATE OF ALASKA
DEPARTMENT OF TRANSPORTATION
AND PUBLIC FACILITIES
SOUTHEAST REGION DESIGN & CONSTRUCTION

CRAIG


CRAIG SEAPLANE BASE EXPANSION
AIP # 3-02-0071-01
BUILDING SECTIONS

ALASKA


DESIGNED BY:	PROJECT NO. 69956
DRAWN BY:	DATE: 8-94
CHECKED BY:	SHEET 36 OF 60

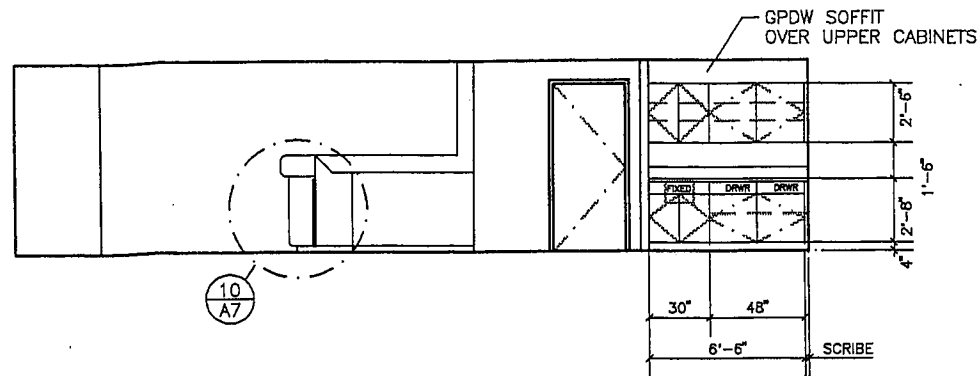


1 TICKET A100

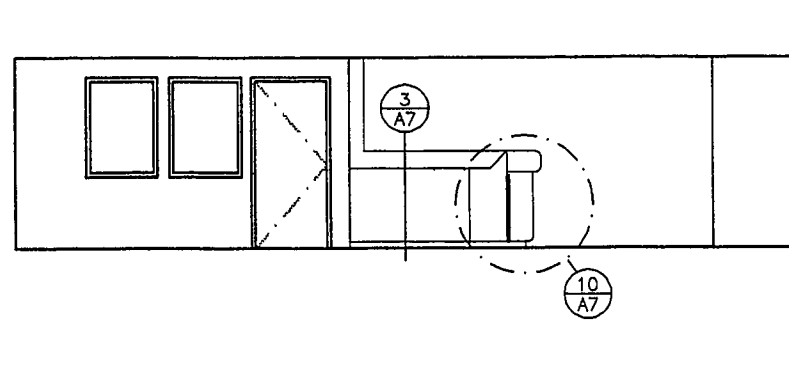


2 TICKET B100

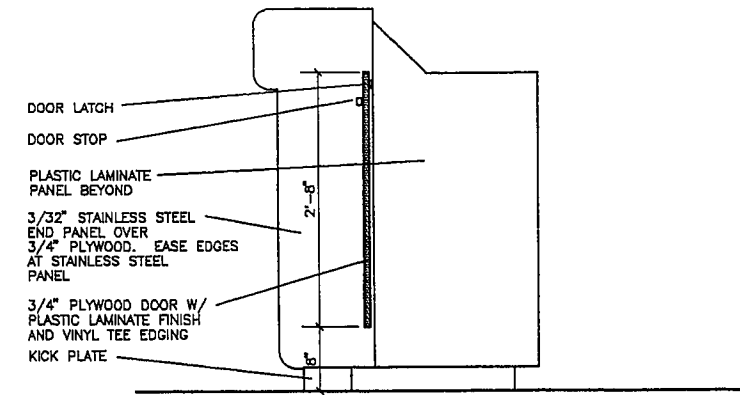


10 COUNTER DOOR
SCALE: 1"=1'-0"

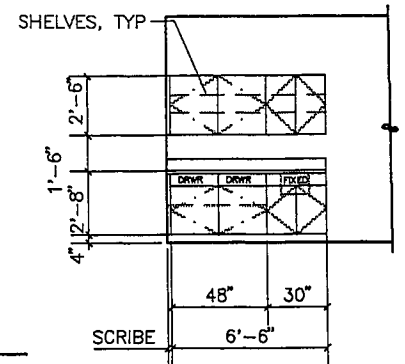


11 CABINETS AT B102

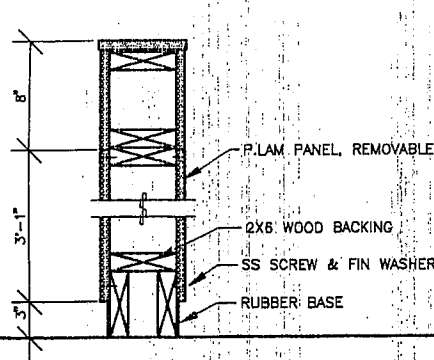


3 DIVIDER
SCALE: 1-1/2"=1'-0"

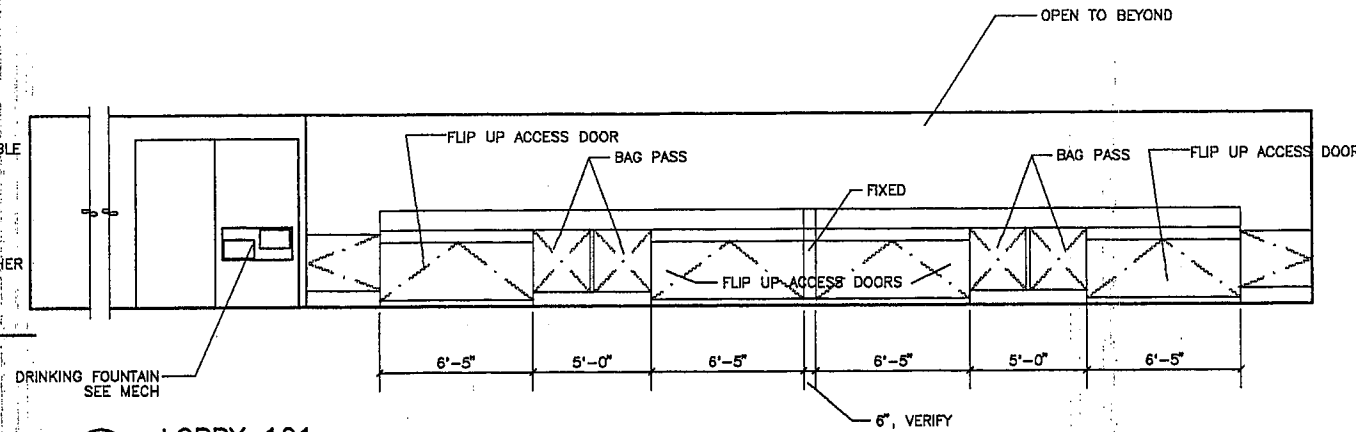


4 LOBBY 101

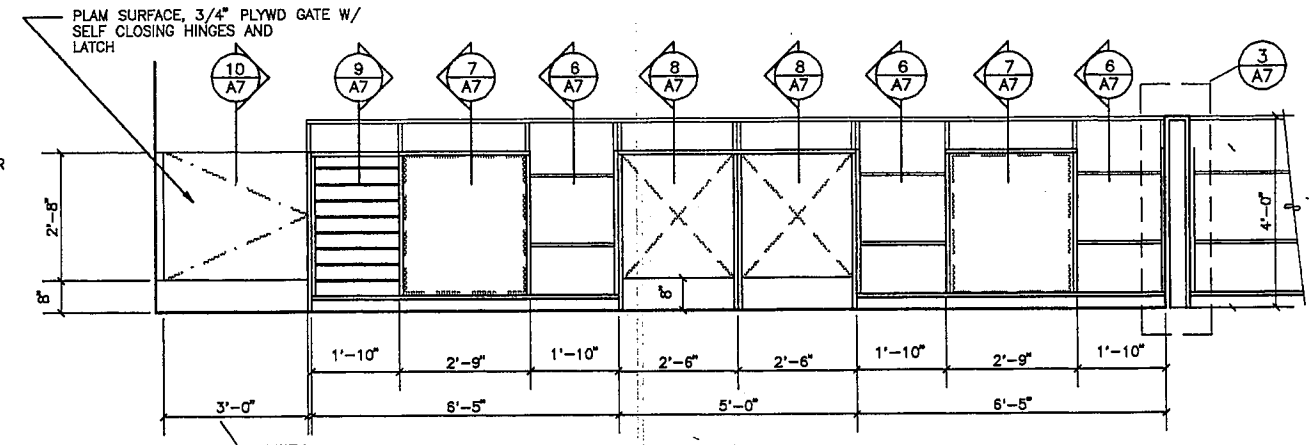


5 TICKET COUNTER AT A100, B100 SIMILAR, OPPOSITE
XREF: 4A7

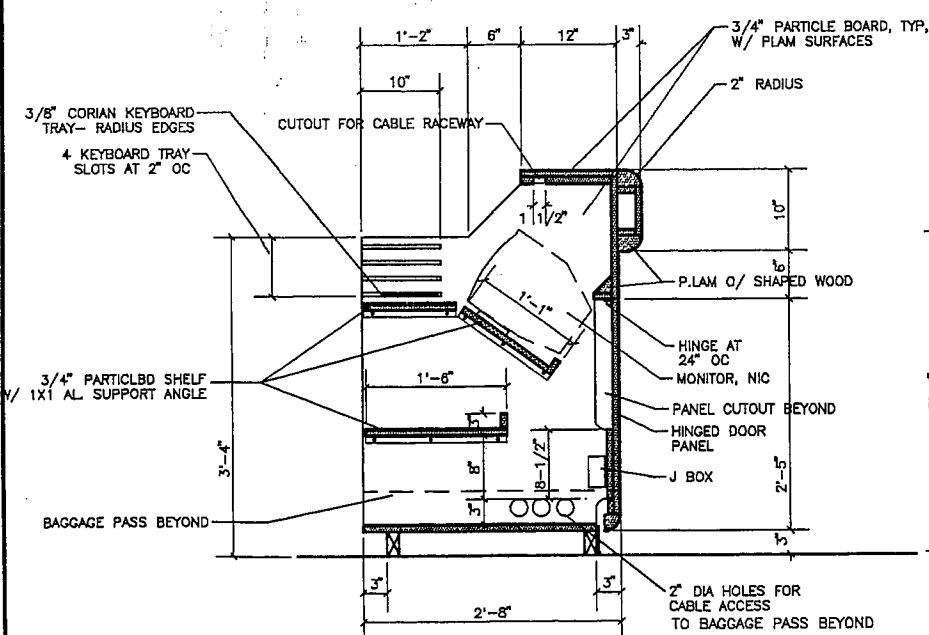


6 TICKET STATION SECTION
XREF: 6A7 SCALE: 1"=1'-0"

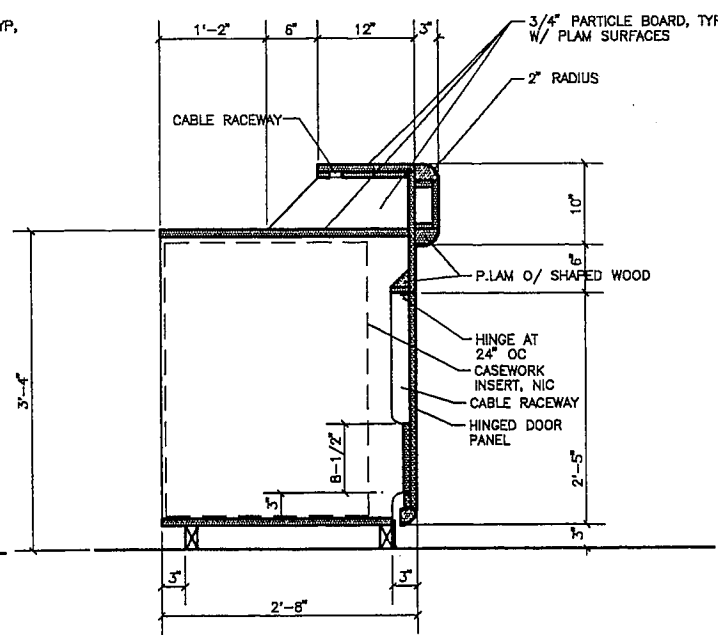

7 TICKET COUNTER SECTION
XREF: 7A7 SCALE: 1"=1'-0"

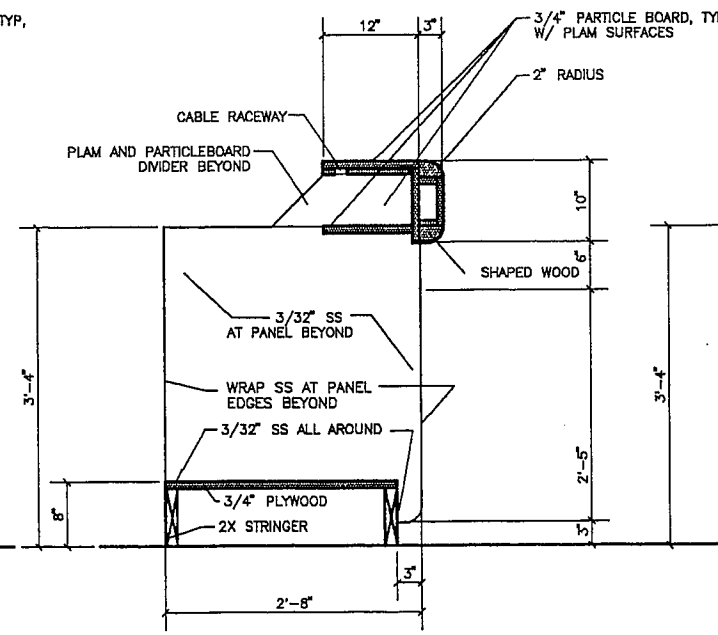

8 TICKET COUNTER SECTION
XREF: 8A7 SCALE: 1"=1'-0"

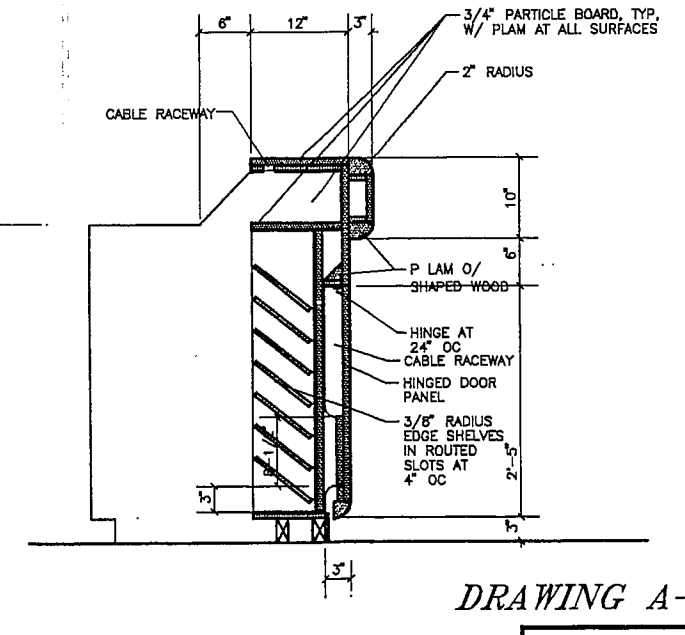

9 TICKET COUNTER SECTION
XREF: 9A7 SCALE: 1"=1'-0"

DRAWING A-7

RECORD OF REVISIONS		
NO.	DATE	DESCRIPTION OF CHANGE


STATE OF ALASKA
DEPARTMENT OF TRANSPORTATION
AND PUBLIC FACILITIES
SOUTHEAST REGION DESIGN & CONSTRUCTION


CRAIG

CRAIG SEAPLANE BASE EXPANSION
AIP # 3-02-0071-01
INTERIOR ELEVATIONS

ALASKA


DESIGNED BY:	PROJECT NO. 69956
DRAWN BY:	DATE: 8-94
CHECKED BY:	SHEET 37 OF 60

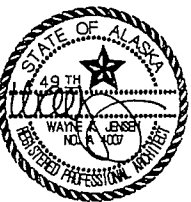

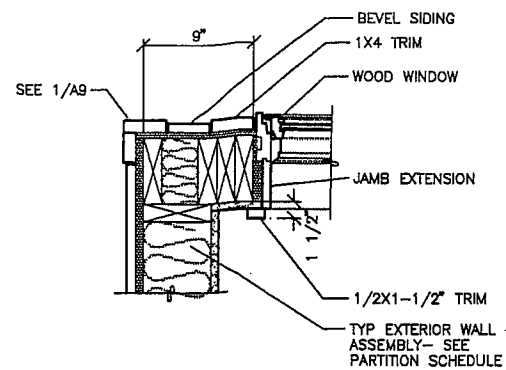


CAD\ 639\ 1AAB
WINDOW CORNER
 Scale: 1-1/2" = 1'-0"

1

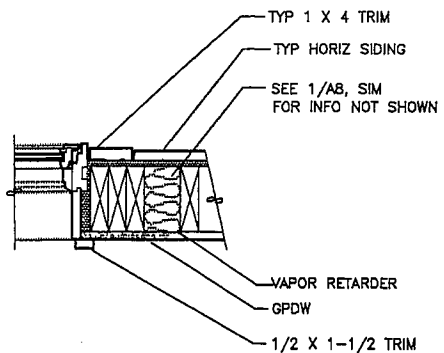


CAD\ 639\ 2AB
WINDOW JAMB, HD SIM
 Scale: 1-1/2" = 1'-0"

2

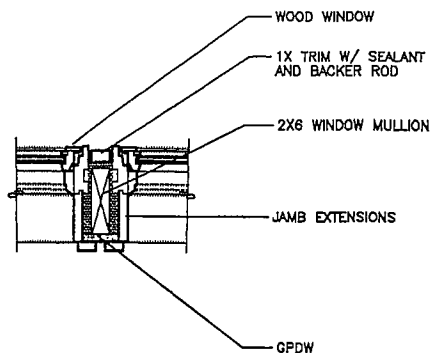


CAD\ 639\ 3AB
WINDOW MULLION
 Scale: 1-1/2" = 1'-0"

3

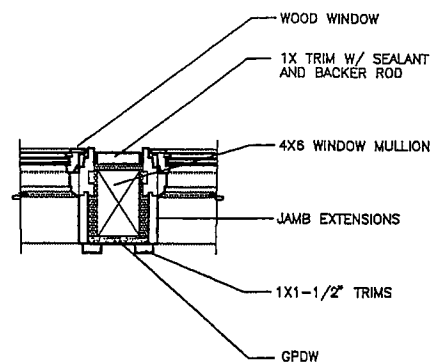


CAD\ 639\ 4AB
WINDOW MULLION
 Scale: 1-1/2" = 1'-0"

4

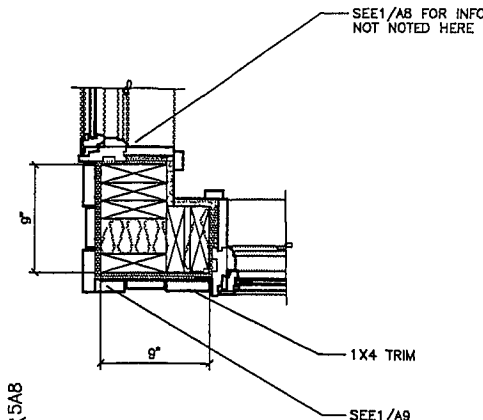


CAD\ 639\ 5AB
WINDOW CORNER
 Scale: 1-1/2" = 1'-0"

5

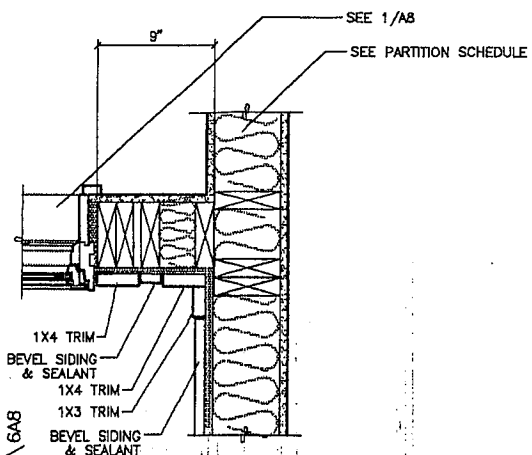


CAD\ 639\ 6AB
WINDOW AT WALL
 Scale: 1-1/2" = 1'-0"

6

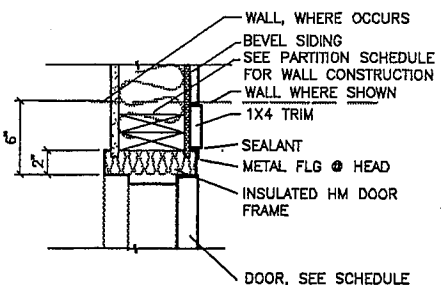


CAD\ 639\ 7AB
EXTERIOR DOOR JAMB
 Scale: 1-1/2" = 1'-0"

7

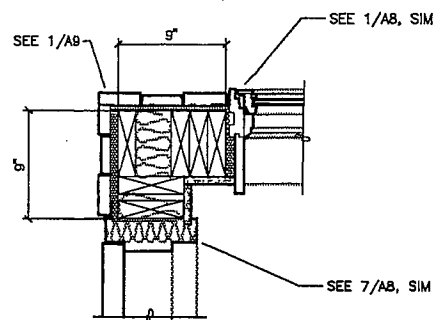


CAD\ 639\ 8AB
DOOR AT WINDOW
 Scale: 1-1/2" = 1'-0"

8

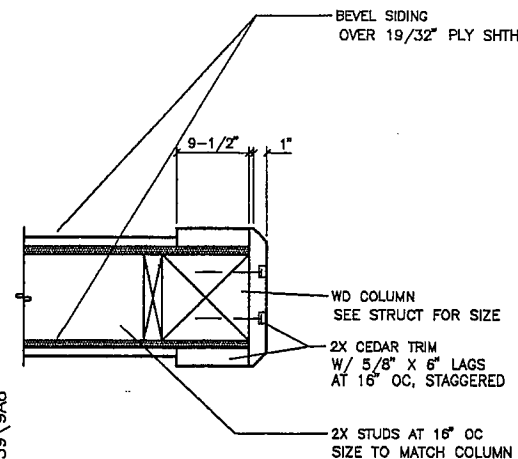


CAD\ 639\ 9AB
WALL AT POST
 Scale: 1-1/2" = 1'-0"

9

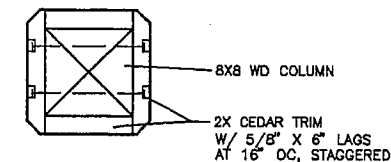


CAD\ 639\ 10AB
COLUMN WRAP
 Scale: 1-1/2" = 1'-0"

10

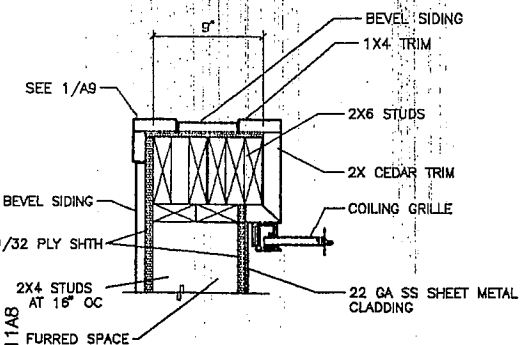


CAD\ 639\ 11AB
COILING GRILLE JAMB
 Scale: 1-1/2" = 1'-0"

11

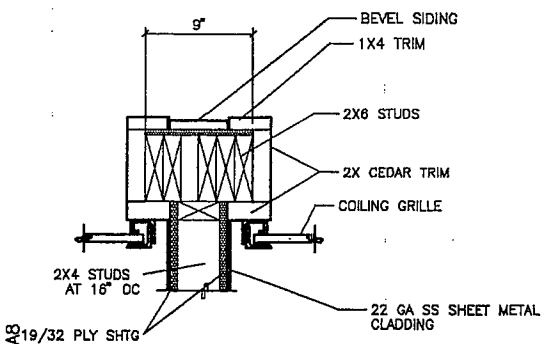


CAD\ 639\ 12AB
COILING GRILLE JAMB
 Scale: 1-1/2" = 1'-0"

12

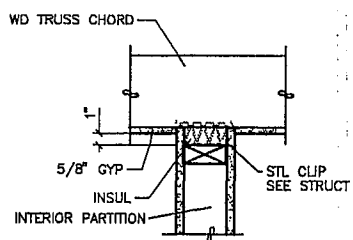

CAD\ 639\ 12AB
COILING GRILLE JAMB
 Scale: 1-1/2" = 1'-0"

13

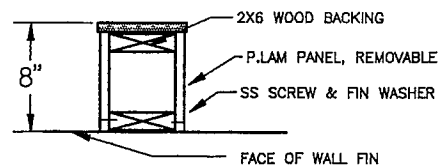

\ 639\ 14AB
CABLE ENCLOSURE
 Scale: 1-1/2" = 1'-0"

14

RECORD OF REVISIONS		
NO.	DATE	DESCRIPTION OF CHANGE

STATE OF ALASKA
 DEPARTMENT OF TRANSPORTATION
 AND PUBLIC FACILITIES
 SOUTHEAST REGION DESIGN & CONSTRUCTION

CRAIG

CRAIG SEAPLANE BASE EXPANSION
 AIP # 3-02-0071-01

DETAILS

ALASKA

DESIGNED BY:

DRAWN BY:


CHECKED BY:


PROJECT NO.

DATE:

SHEET 38 OF 60


DRAWING A-8

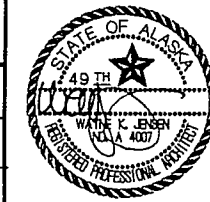

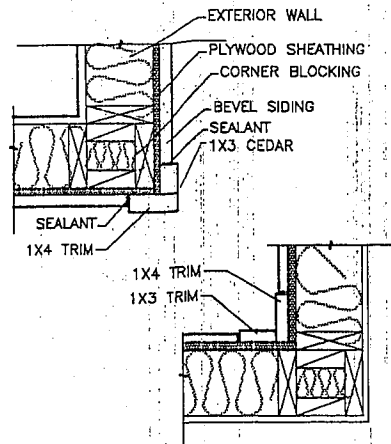


CAD\639\1A99
CORNER DETAILS
Scale: 1-1/2" = 1'-0"

1

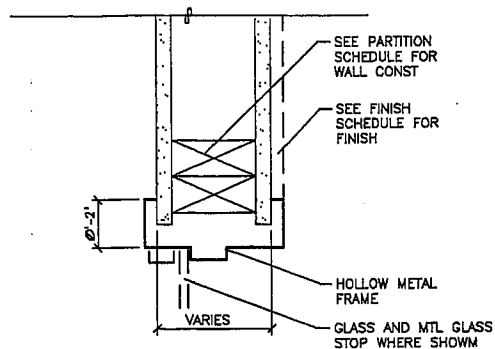


CAD\639\2A9
INTERIOR DOOR HEAD/JAMB SIM
Scale: 3" = 1'-0"

2

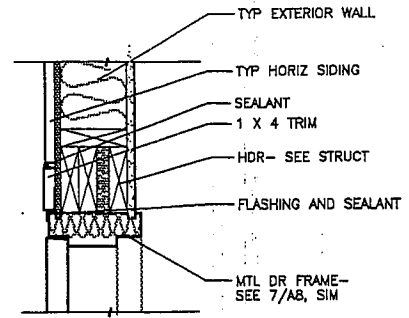


CAD\639\3A9
DOOR HEAD
Scale: 1-1/2" = 1'-0"

3

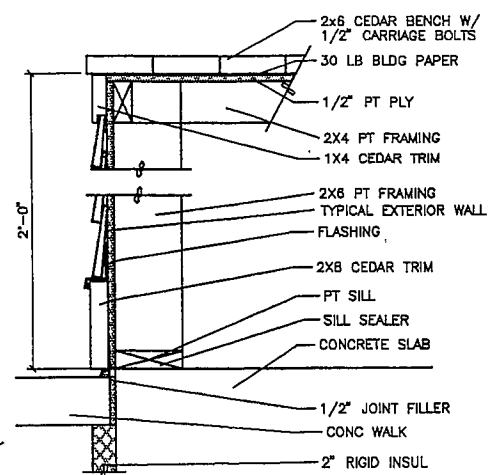


CAD\639\4A9
BENCH
Scale: 1-1/2" = 1'-0"

4

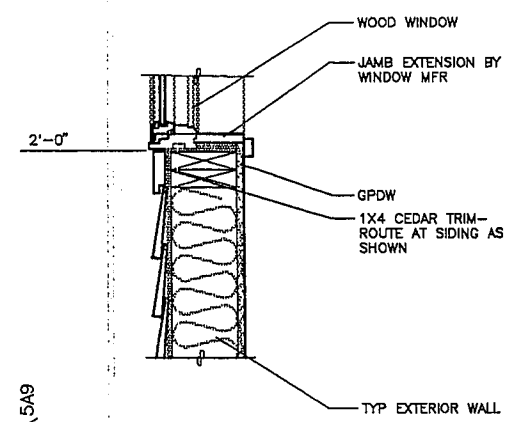


CAD\639\5A9
WINDOW SILL
Scale: 1-1/2" = 1'-0"

5

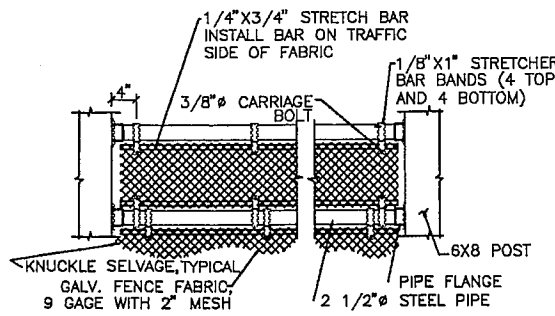


CAD\639\10A9
RAIL MESH
Scale: 1-1/2" = 1'-0"

8

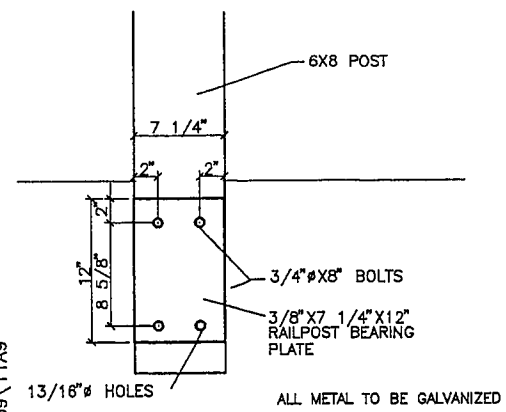


CAD\639\11A9
POST BEARING PLATE
Scale: 1-1/2" = 1'-0"

9

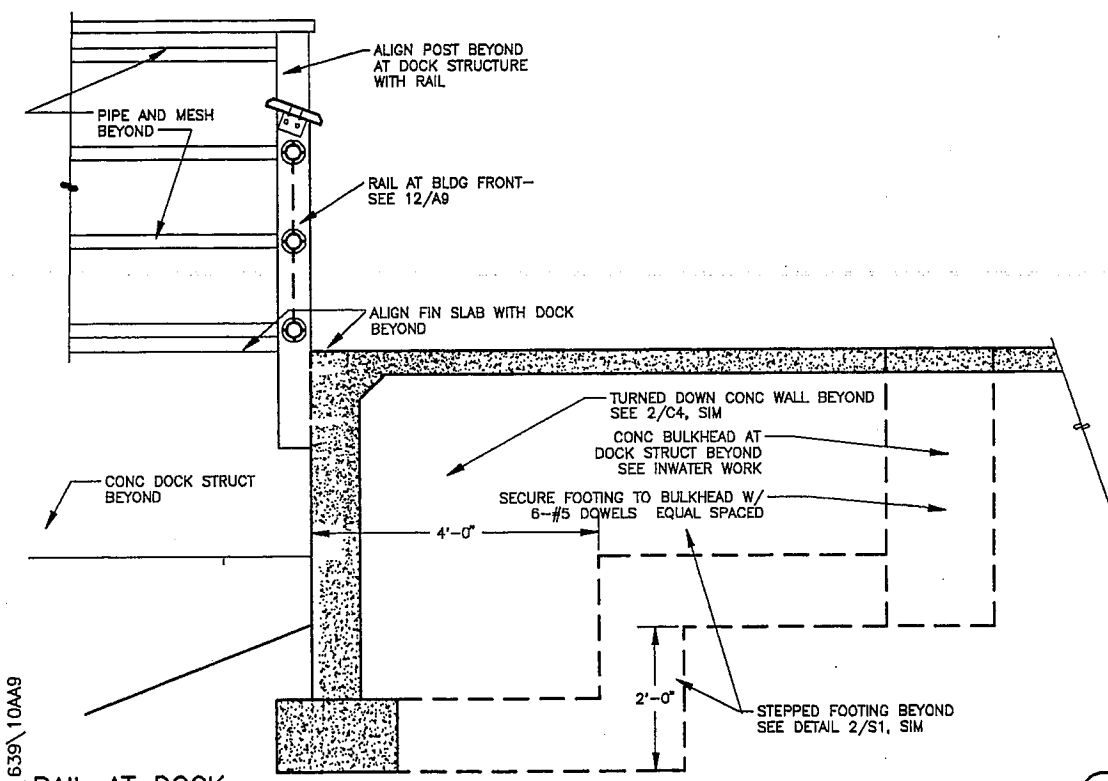

CAD\639\10A9
RAIL AT DOCK
Scale: 3/4" = 1'-0"

10

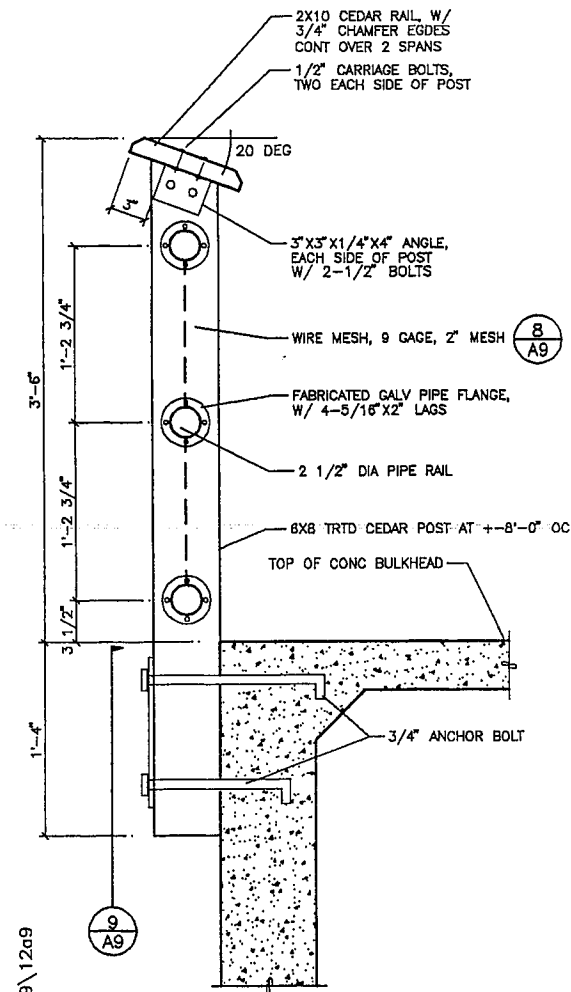

CAD\639\12A9
RAIL
Scale: 1-1/2" = 1'-0"

12





RECORD OF REVISIONS		
NO.	DATE	DESCRIPTION OF CHANGE

STATE OF ALASKA
DEPARTMENT OF TRANSPORTATION
AND PUBLIC FACILITIES
SOUTHEAST REGION DESIGN & CONSTRUCTION

CRAIG
CRAIG SEAPLANE BASE EXPANSION
AIP # 3-02-0071-01
DETAILS

ALASKA
DESIGNED BY:
DRAWN BY:
CHECKED BY:
PROJECT NO. 69956
DATE: 8-94
SHEET 39 OF 60



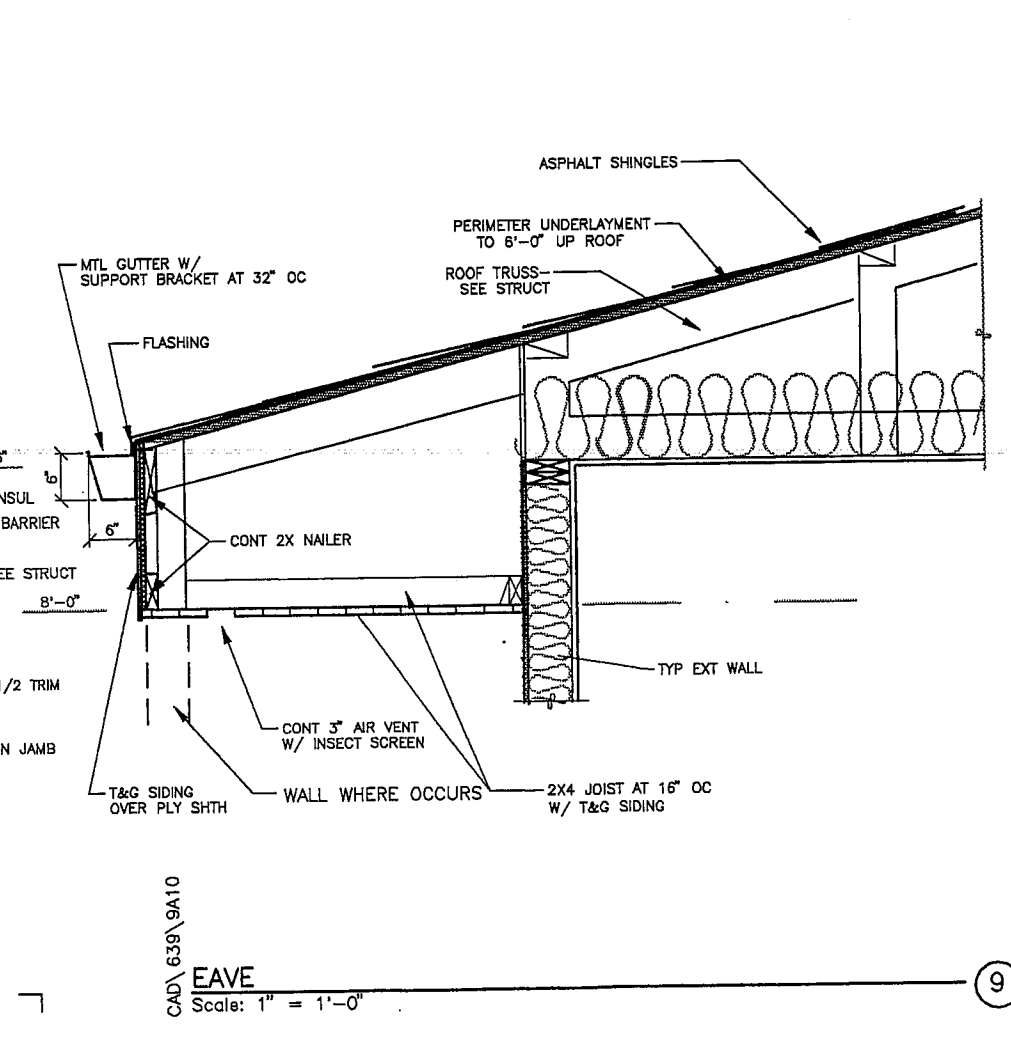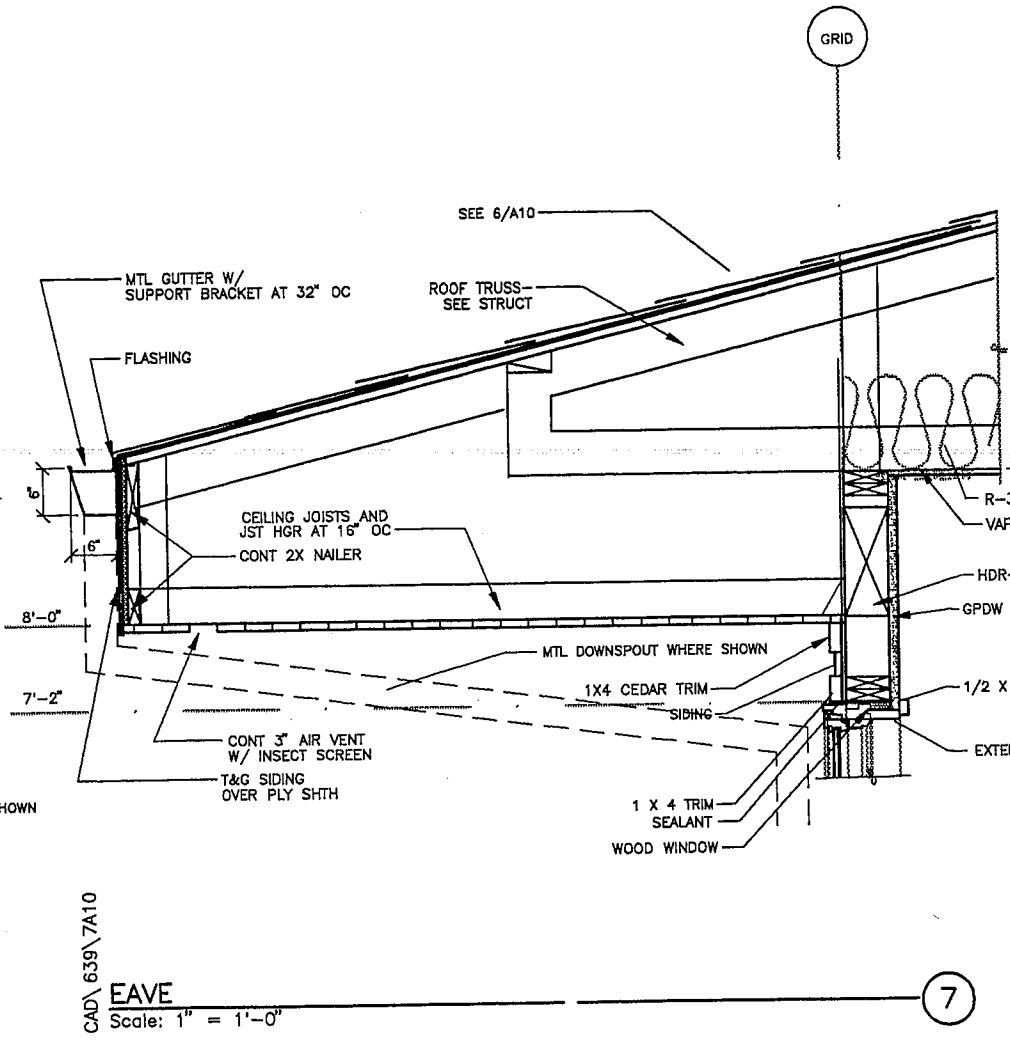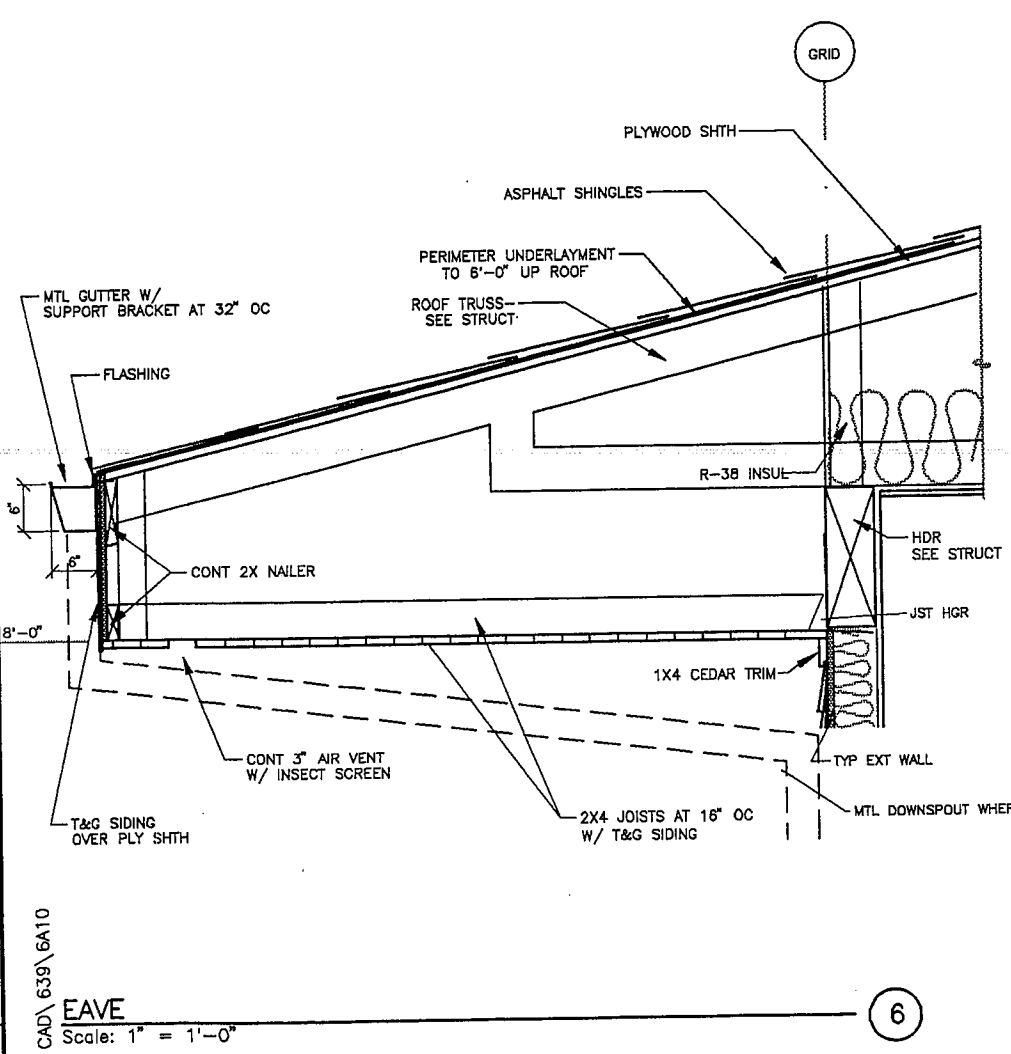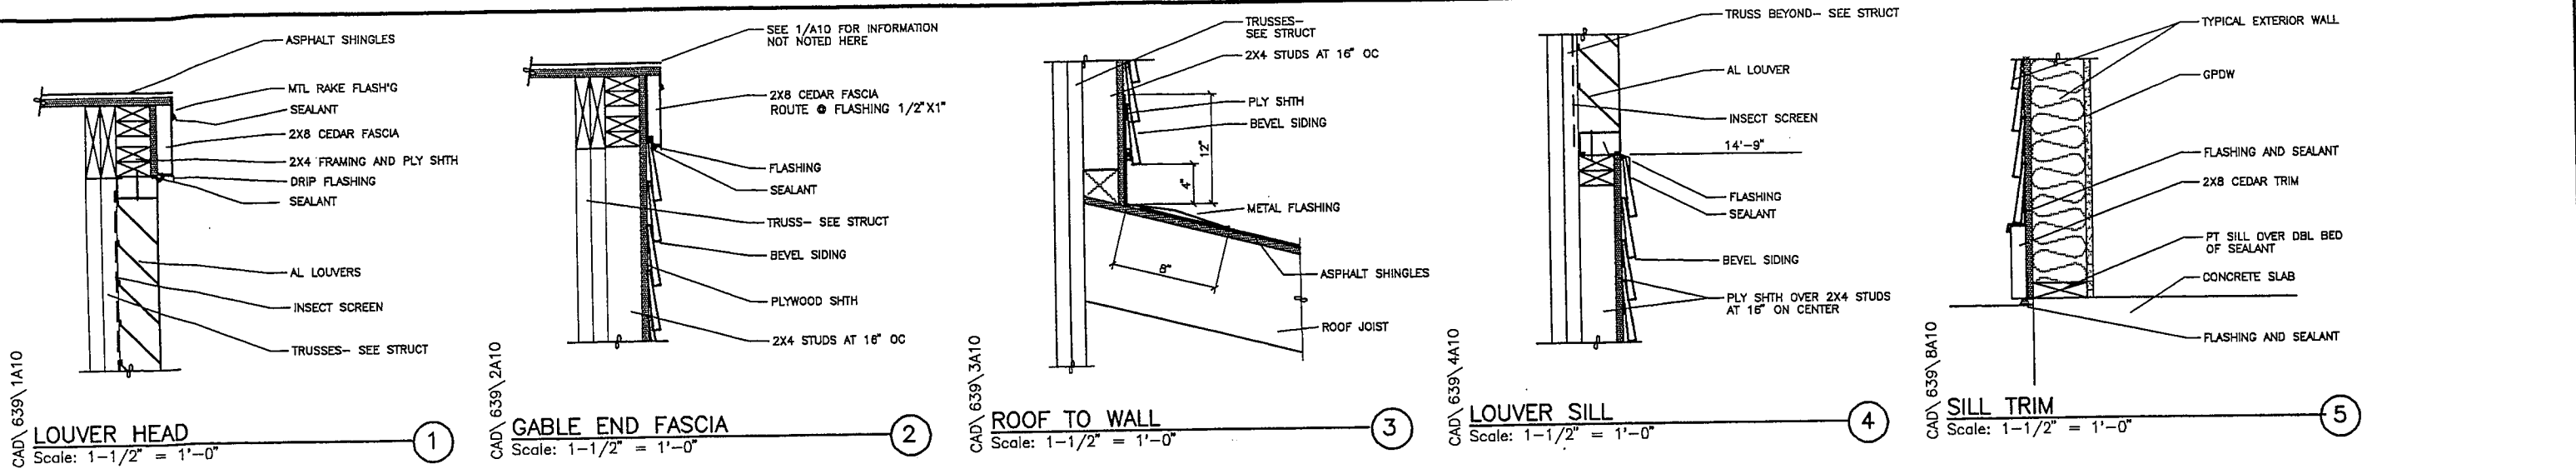


RECORD OF REVISIONS		
NO.	DATE	DESCRIPTION OF CHANGE

STATE OF ALASKA
DEPARTMENT OF TRANSPORTATION
AND PUBLIC FACILITIES
SOUTHEAST REGION DESIGN & CONSTRUCTION


CRAIG
ALASKA
CRAIG SEAPLANE BASE EXPANSION
AIP # 3-02-0071-01
DETAILS

DESIGNED BY:	PROJECT NO. 69956
DRAWN BY:	DATE: 8-94
CHECKED BY:	SHEET 40 OF 60

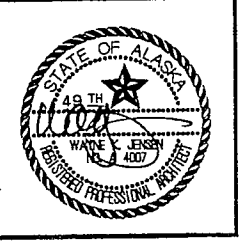



STA. "0" 11+99.58
CS-5
RE-BAR w/ PLASTIC
CAP-D.O.T.
N.21,287.930
E.39,518.459
TOP OF CAP
EL. = +14.84'

STA. "0" 10+06.00
CS-6
RE-BAR w/ PLASTIC
CAP-D.O.T.
N.21,463.839
E.39,599.264
TOP OF CAP
EL. = +14.06'

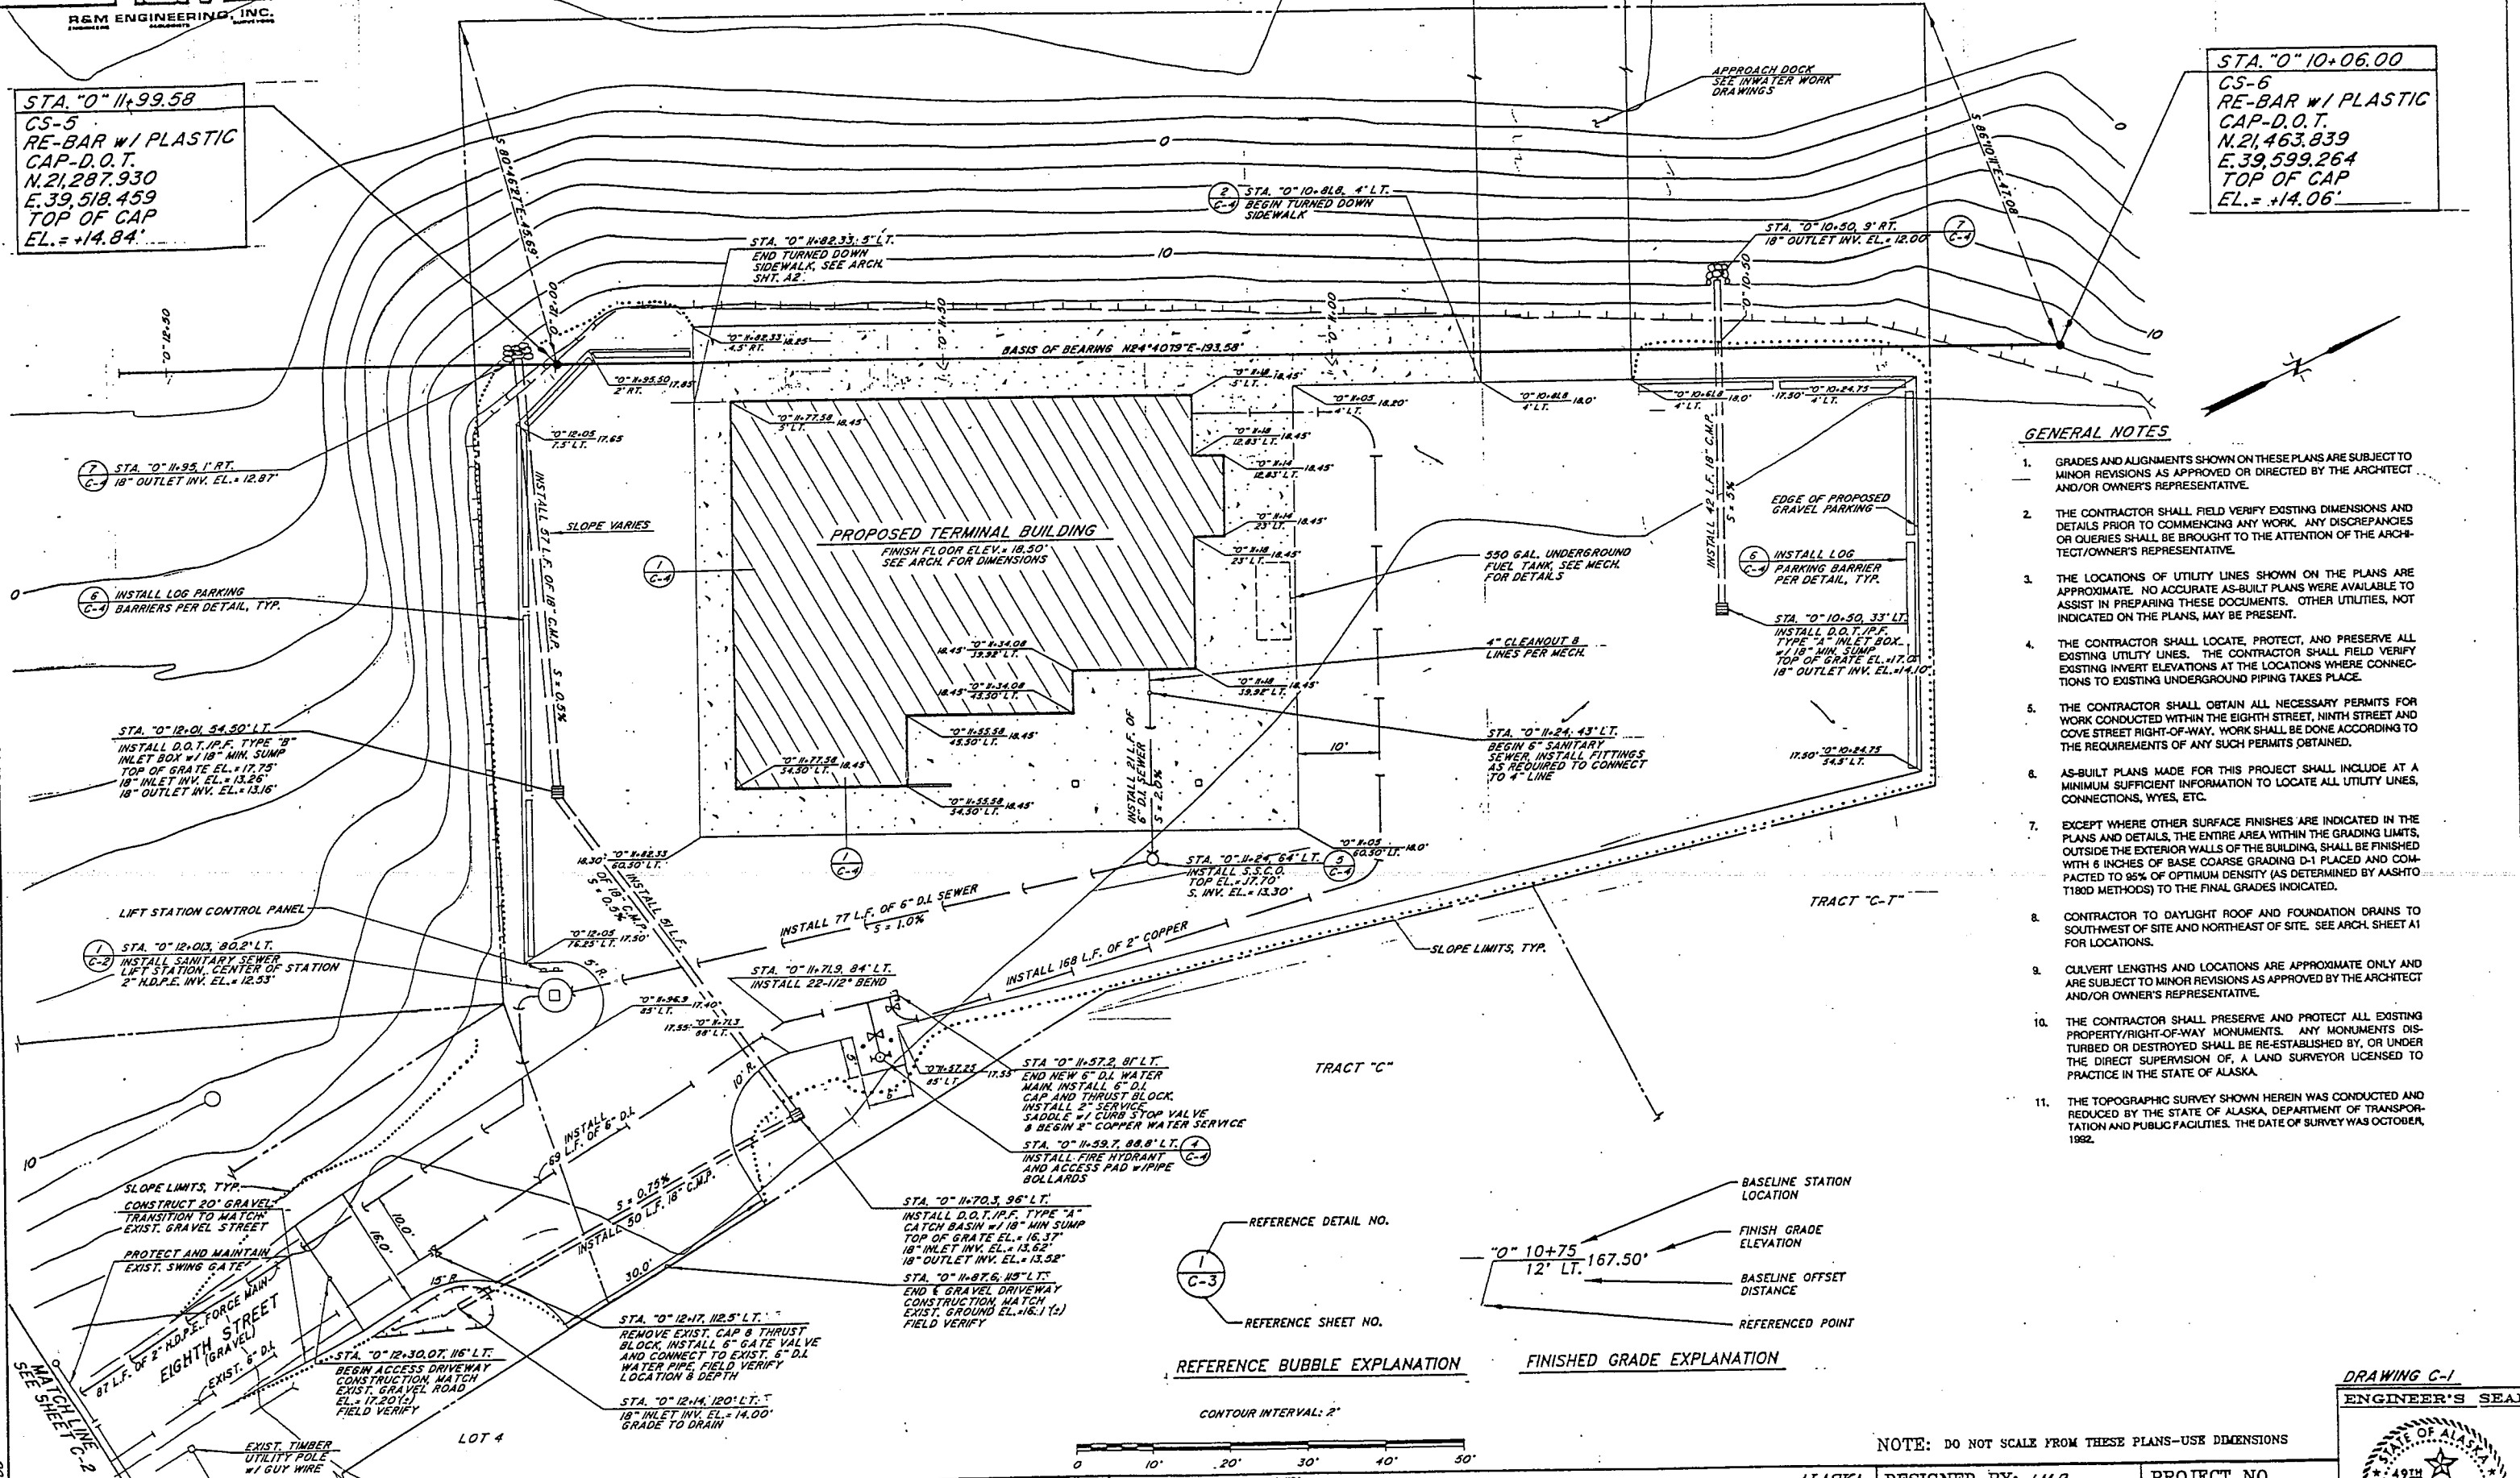

GENERAL NOTES


- GRADES AND ALIGNMENTS SHOWN ON THESE PLANS ARE SUBJECT TO MINOR REVISIONS AS APPROVED OR DIRECTED BY THE ARCHITECT AND/OR OWNER'S REPRESENTATIVE.
- THE CONTRACTOR SHALL FIELD VERIFY EXISTING DIMENSIONS AND DETAILS PRIOR TO COMMENCING ANY WORK. ANY DISCREPANCIES OR QUERIES SHALL BE BROUGHT TO THE ATTENTION OF THE ARCHITECT/OWNER'S REPRESENTATIVE.
- THE LOCATIONS OF UTILITY LINES SHOWN ON THE PLANS ARE APPROXIMATE. NO ACCURATE AS-BUILT PLANS WERE AVAILABLE TO ASSIST IN PREPARING THESE DOCUMENTS. OTHER UTILITIES, NOT INDICATED ON THE PLANS, MAY BE PRESENT.
- THE CONTRACTOR SHALL LOCATE, PROTECT, AND PRESERVE ALL EXISTING UTILITY LINES. THE CONTRACTOR SHALL FIELD VERIFY EXISTING INVERT ELEVATIONS AT THE LOCATIONS WHERE CONNECTIONS TO EXISTING UNDERGROUND PIPING TAKES PLACE.
- THE CONTRACTOR SHALL OBTAIN ALL NECESSARY PERMITS FOR WORK CONDUCTED WITHIN THE EIGHTH STREET, NINTH STREET AND COVE STREET RIGHT-OF-WAY. WORK SHALL BE DONE ACCORDING TO THE REQUIREMENTS OF ANY SUCH PERMITS OBTAINED.
- AS-BUILT PLANS MADE FOR THIS PROJECT SHALL INCLUDE AT A MINIMUM SUFFICIENT INFORMATION TO LOCATE ALL UTILITY LINES, CONNECTIONS, WYES, ETC.
- EXCEPT WHERE OTHER SURFACE FINISHES ARE INDICATED IN THE PLANS AND DETAILS, THE ENTIRE AREA WITHIN THE GRADING LIMITS, OUTSIDE THE EXTERIOR WALLS OF THE BUILDING, SHALL BE FINISHED WITH 6 INCHES OF BASE COARSE GRADING D-1 PLACED AND COMPACTED TO 95% OF OPTIMUM DENSITY (AS DETERMINED BY AASHTO T180D METHODS) TO THE FINAL GRADES INDICATED.
- CONTRACTOR TO DAYLIGHT ROOF AND FOUNDATION DRAINS TO SOUTHWEST OF SITE AND NORTHEAST OF SITE. SEE ARCH. SHEET A1 FOR LOCATIONS.
- CULVERT LENGTHS AND LOCATIONS ARE APPROXIMATE ONLY AND ARE SUBJECT TO MINOR REVISIONS AS APPROVED BY THE ARCHITECT AND/OR OWNER'S REPRESENTATIVE.
- THE CONTRACTOR SHALL PRESERVE AND PROTECT ALL EXISTING PROPERTY/RIGHT-OF-WAY MONUMENTS. ANY MONUMENTS DISTURBED OR DESTROYED SHALL BE RE-ESTABLISHED BY, OR UNDER THE DIRECT SUPERVISION OF, A LAND SURVEYOR LICENSED TO PRACTICE IN THE STATE OF ALASKA.
- THE TOPOGRAPHIC SURVEY SHOWN HEREIN WAS CONDUCTED AND REDUCED BY THE STATE OF ALASKA, DEPARTMENT OF TRANSPORTATION AND PUBLIC FACILITIES. THE DATE OF SURVEY WAS OCTOBER, 1992.

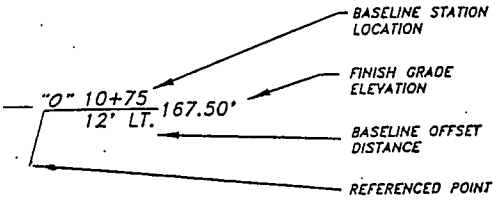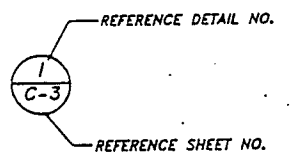

REFERENCE BUBBLE EXPLANATION

FINISHED GRADE EXPLANATION

CONTOUR INTERVAL: 2'

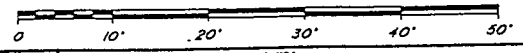

NOTE: DO NOT SCALE FROM THESE PLANS—USE DIMENSIONS

RECORD OF REVISIONS		
NO.	DATE	DESCRIPTION OF CHANGE

STATE OF ALASKA
DEPARTMENT OF TRANSPORTATION
AND PUBLIC FACILITIES
SOUTHEAST REGION DESIGN & CONSTRUCTION

CRAIG

CRAIG SEAPLANE BASE EXPANSION
AIP # 3-02-0071-01
SITE PLAN

ALASKA




DESIGNED BY: J.M.P.
DRAWN BY: F.M.
CHECKED BY: M.A.M.

PROJECT NO. 69956
DATE: AUGUST, 1994
SHEET 41 OF 60

DRAWING C-1
ENGINEER'S SEAL



R & M PROJECT # 83100

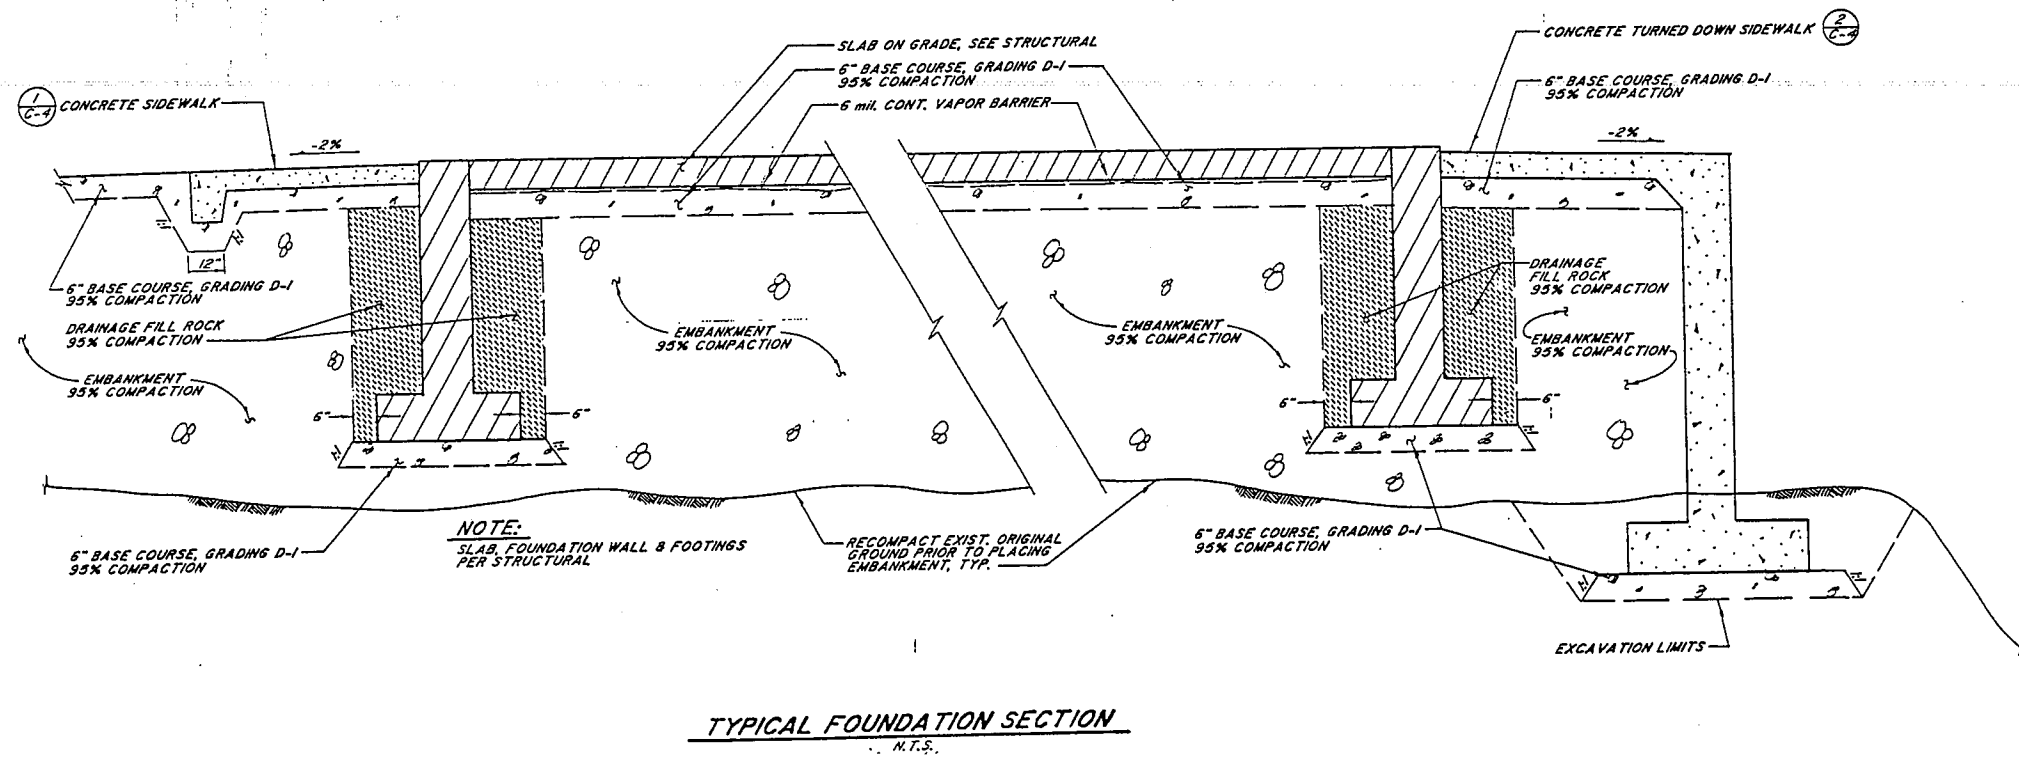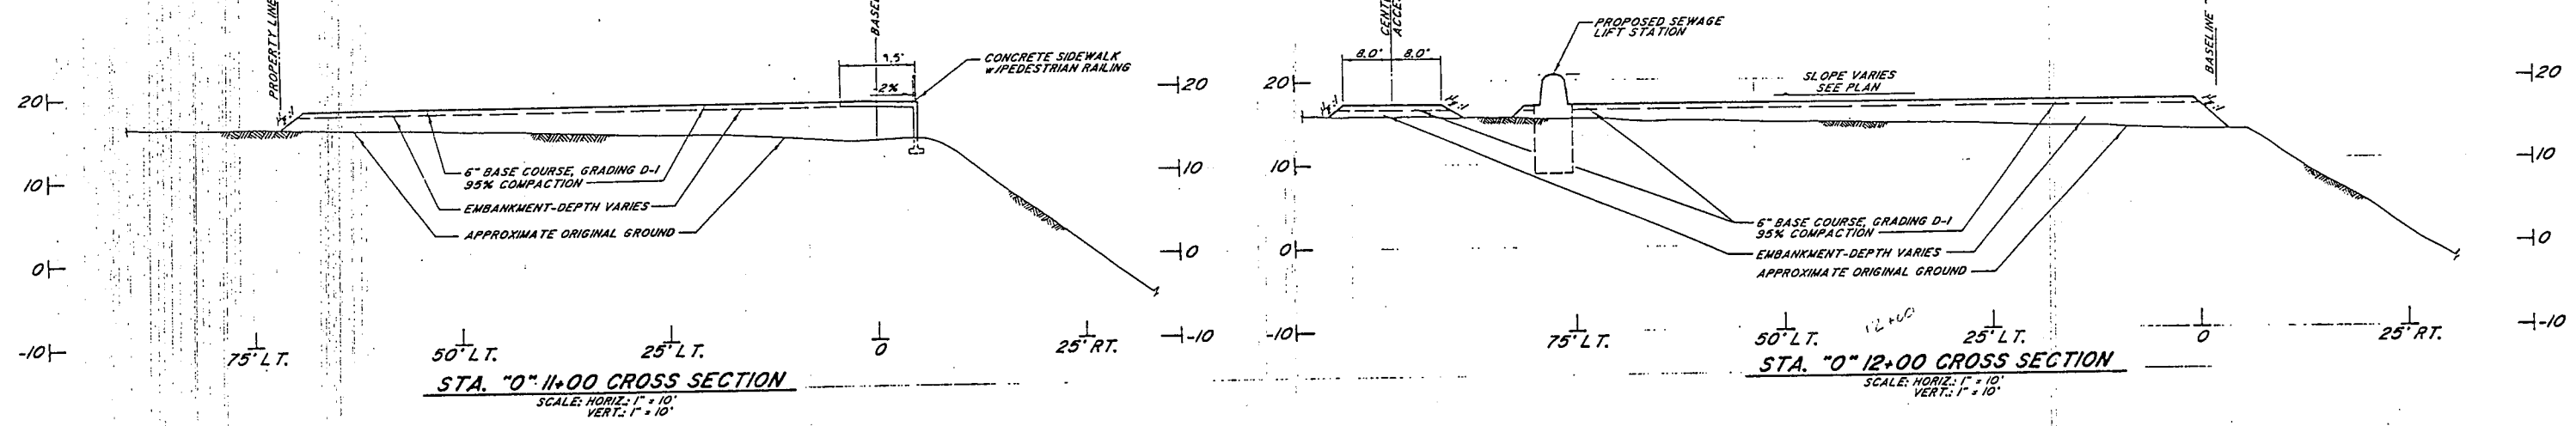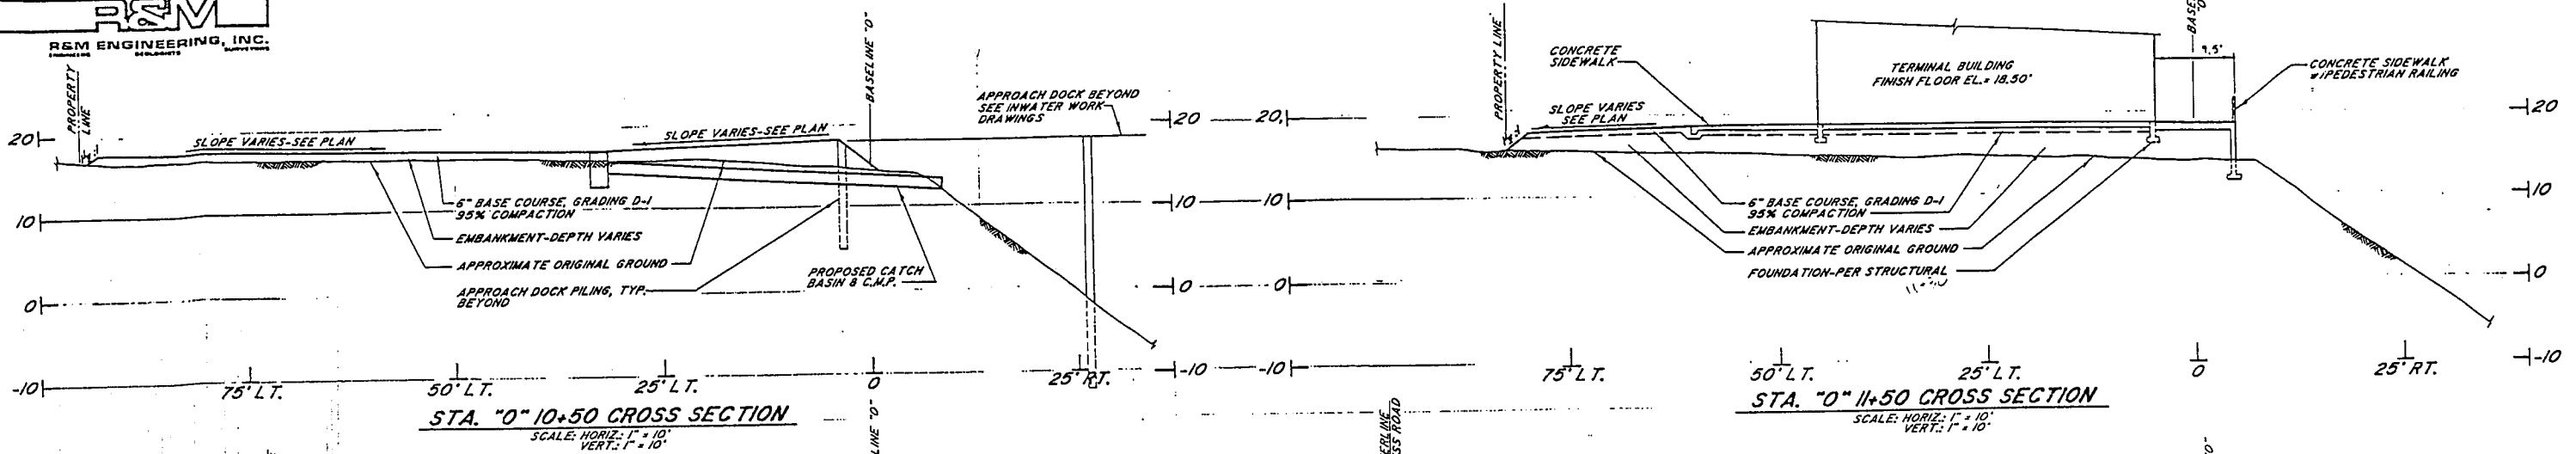


- FOUNDATION NOTES:**
- WHERE VERTICAL LINES ARE INDICATED FOR EXCAVATION AND/OR FILL LIMITS WITHIN THE TYPICAL SECTIONS, THESE ARE TO BE INTERPRETED AS THEORETICAL POSITIONS OF THE CUT AND FILL ONLY. THE CONTRACTOR SHALL EXCAVATE MATERIALS AT A SAFE SLOPE SUITABLE FOR THE MATERIALS BEING EXCAVATED. FILL MATERIAL SHALL BE PLACED AT LEAST TO THE MINIMUM DIMENSIONS INDICATED.
 - REFER TO THE RELEVANT SECTIONS OF THE SPECIFICATIONS FOR INFORMATION REGARDING EXCAVATION, BACKFILL MATERIALS, METHODS AND TESTING REQUIREMENTS.
 - FINISH GRADE ELEVATIONS FOR FILL OUTSIDE THE BUILDING ARE AS INDICATED ON THE SITE PLAN (SHEET C-1).
 - SELECT BORROW SHALL BE 12" MINUS NPS MATERIAL COMPACTED TO 95% COMPACTION WITHIN THE BUILDING FOOTPRINT AND COMPACTED TO 90% COMPACTION OUTSIDE THE BUILDING FOOTPRINT.
 - BASE COURSE GRADING D-1 SHALL MEET THE GRADATION REQUIREMENTS SPECIFIED IN THE PROJECT TECHNICAL SPECIFICATIONS. COMPACTION SHALL BE BASED ON THE MAXIMUM DRY DENSITY AS OBTAINED FROM USING AASHTO T1800 TEST METHODS.
 - CONSTRUCTION SLABS, FOUNDATIONS, AND WALLS SHALL BE PER STRUCTURAL DRAWINGS. BEFORE BACKFILLING OR PLACING BUILDING LOADS, ALLOW 14 DAYS OF CURING TIME FOR CONCRETE WALLS AND FOUNDATIONS, OR UNTIL THE CONCRETE OBTAINS 75% OF THE DESIGN STRENGTH.
 - PLACE 3" MINUS SHOTROCK (DRAINAGE FILL ROCK) ON BOTH SIDES OF THE FOUNDATION WALLS SHOWN ON THE TYPICAL SECTION. ALTERNATIVE LIFTS OF 3" MINUS ON EITHER SIDE OF THE WALL TO PREVENT UNEVEN LATERAL LOADING. COMPACT TO 95% USING AASHTO T1800 TEST METHODS.
 - NO SUBSURFACE INVESTIGATION WAS PERFORMED ON THIS SITE PER DOT/PF DIRECTION. THE EXISTING SITE HAS BEEN PREVIOUSLY FILLED BY OTHERS WITH SHOT ROCK. THE CONTRACTOR IS ENCOURAGED TO INVESTIGATE THE EXISTING SITE CONDITIONS.

RECORD OF REVISIONS	
DATE:	DESCRIPTION OF CHANGE:


STATE OF ALASKA
DEPARTMENT OF TRANSPORTATION
AND PUBLIC FACILITIES
SOUTHEAST REGION DESIGN & CONSTRUCTION

CRAIG
CRAIG SEAPLANE BASE EXPANSION
AIP # 3-02-0071-01
SITE CROSS SECTIONS &
CONSTRUCTION DETAILS


ALASKA	DESIGNED BY: J.M.P.	PROJECT NO. 69956
	DRAWN BY: D.S.	DATE: AUGUST, 1994
	CHECKED BY: M.A.M.	SHEET 43 OF 60

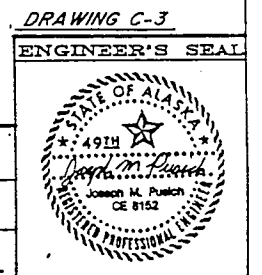


NOTE: DO NOT SCALE FROM THESE PLANS-USE DIMENSIONS

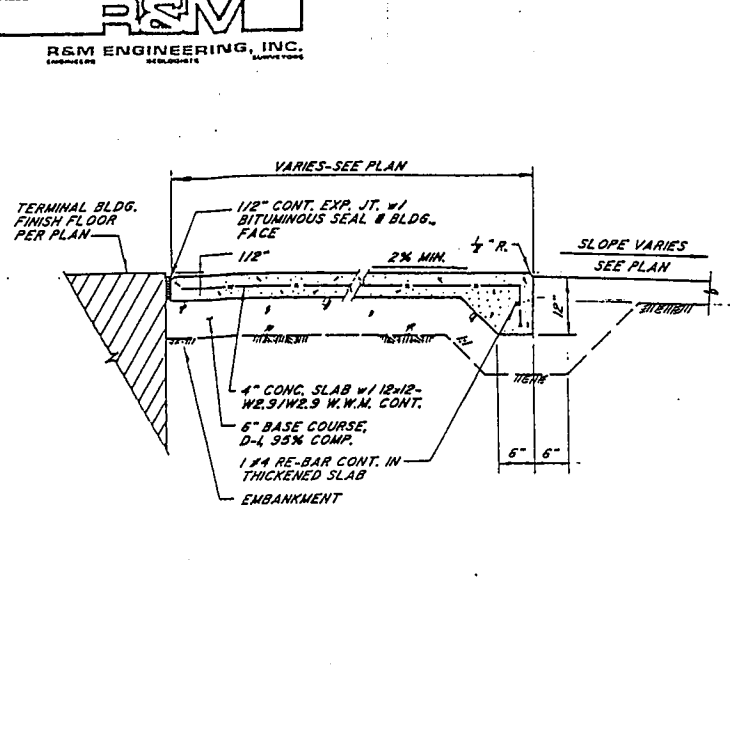


1 CONCRETE SIDEWALK
N.T.S.

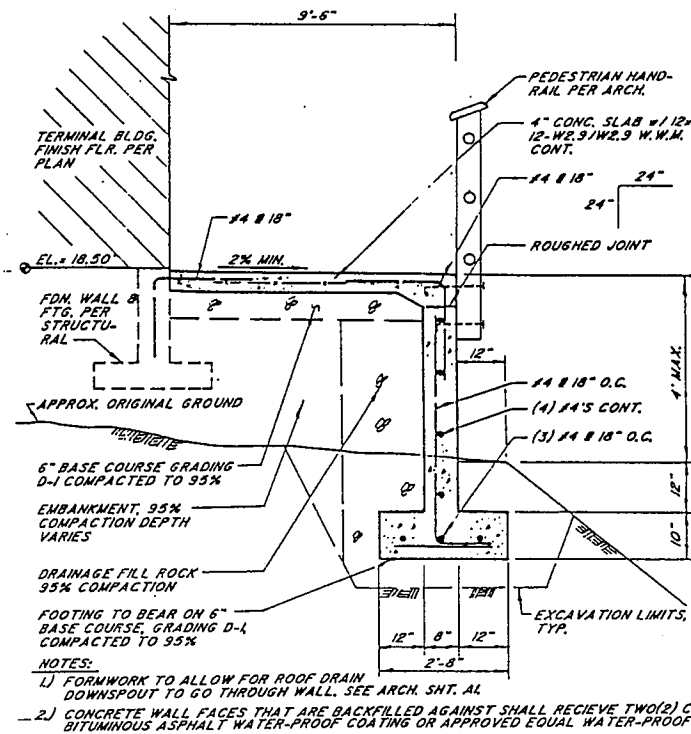


2 TYPICAL TURNED DOWN SIDEWALK
N.T.S.

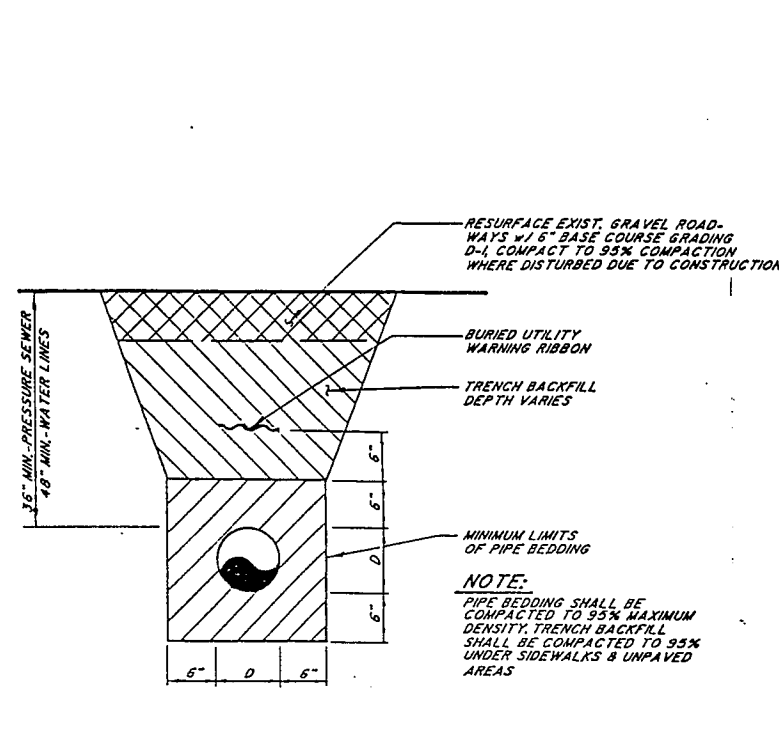


3 PIPE BEDDING & TRENCH BACKFILL
N.T.S.

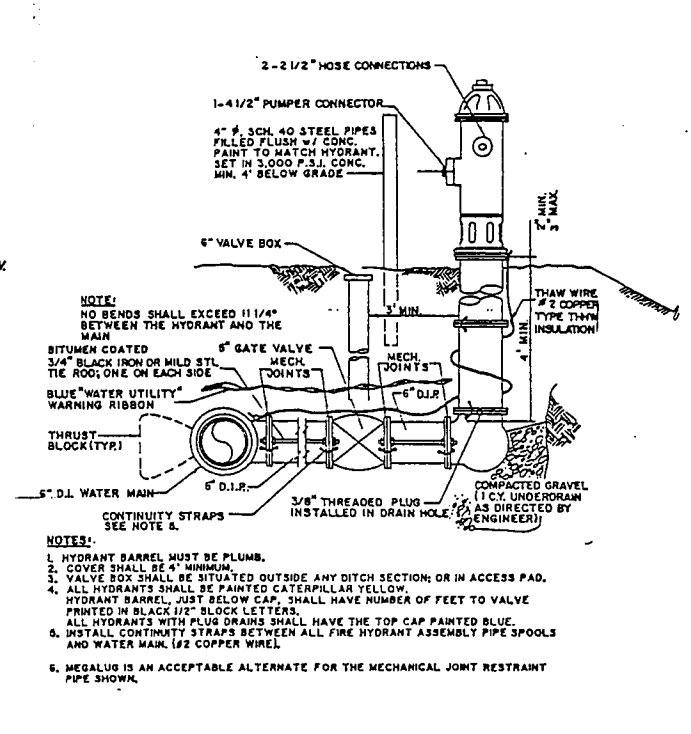


4 FIRE HYDRANT
N.T.S.

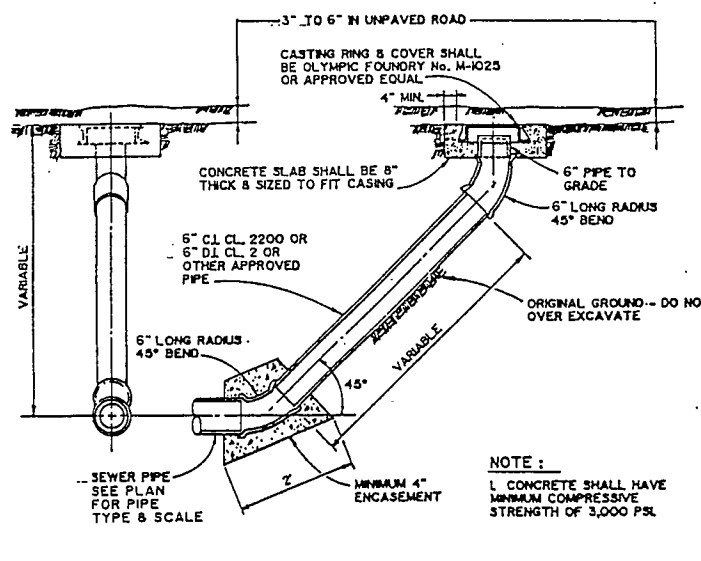


5 SANITARY SEWER CLEANOUT
N.T.S.

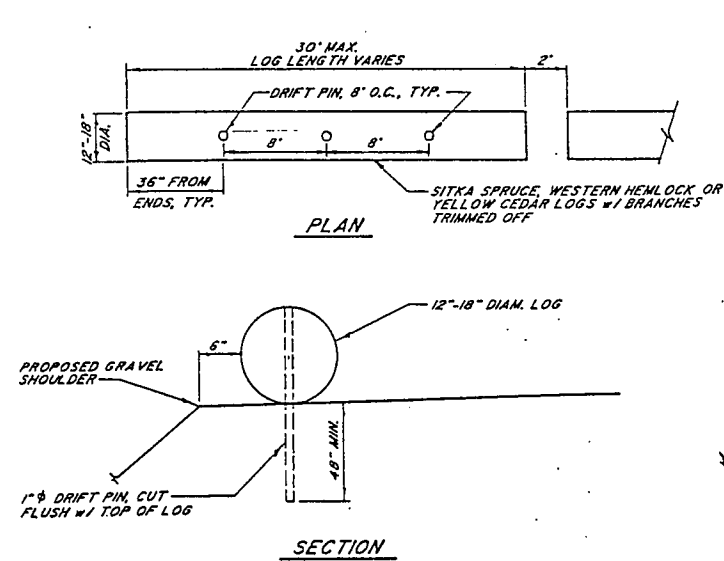

6 LOG PARKING BARRIER
N.T.S.

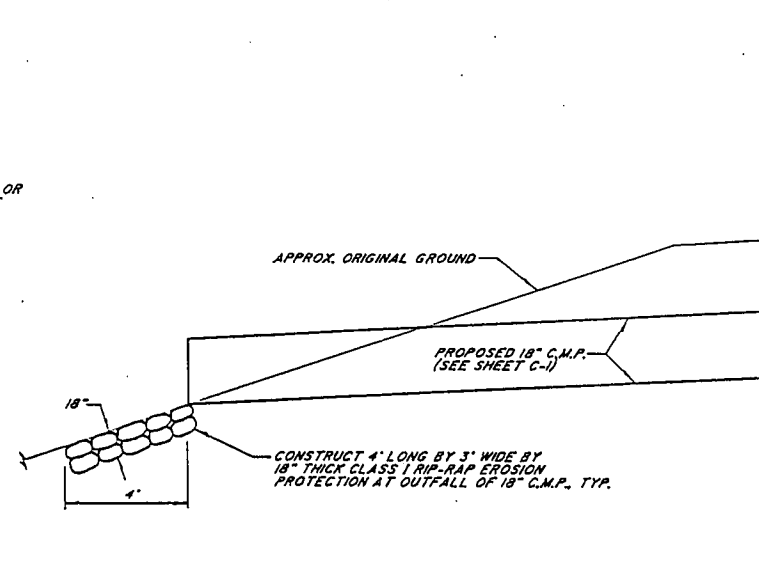

7 C.M.P. OUTFALL DETAIL
N.T.S.

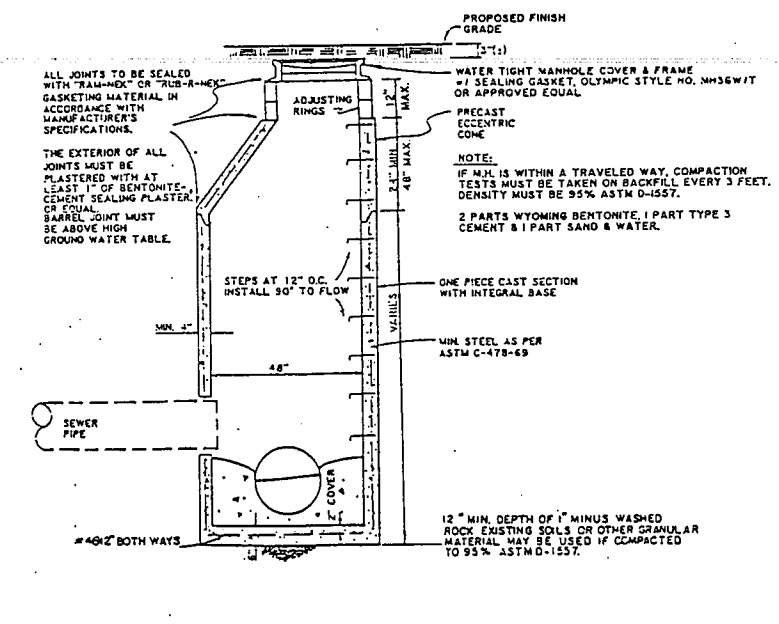

8 SANITARY SEWER MANHOLE
N.T.S.

R & M PROJECT # 30300

PATH:	DATE:	DESCRIPTION OF CHANGE:

RECORD OF REVISIONS


STATE OF ALASKA
DEPARTMENT OF TRANSPORTATION
AND PUBLIC FACILITIES
SOUTHEAST REGION DESIGN & CONSTRUCTION

CRAIG
CRAIG SEAPLANE BASE EXPANSION
AIP # 3-02-0071-01
CONSTRUCTION DETAILS

ALASKA


NOTE: DO NOT SCALE FROM THESE PLANS--USE DIMENSIONS

DESIGNED BY: J.M.P.	PROJECT NO. 69956
DRAWN BY: F.M.	DATE: AUGUST, 1994
CHECKED BY: M.A.M.	SHEET 44 OF 60

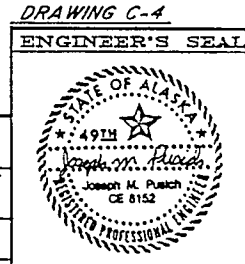


NOTE: WHERE PIPE INVERTS ARE MORE THAN 1'-9" BELOW BOTTOM OF FOOTING, STEP FOOTING DOWN PER DET.


2
5-1

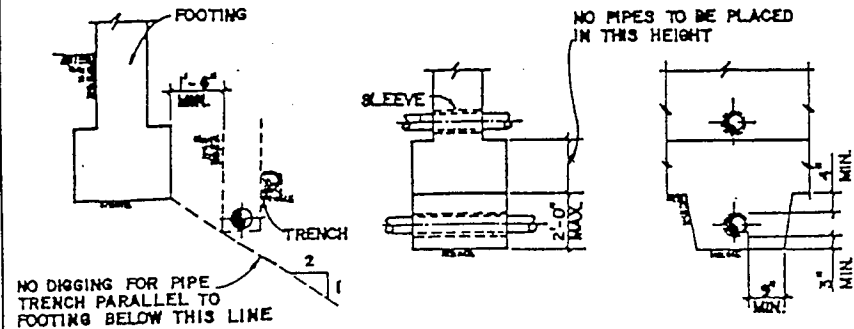

1 UTILITY PIPE LOCATION

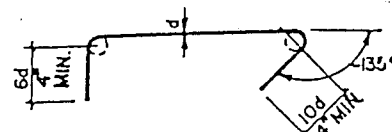


CAP FOR BM, STIRRUP

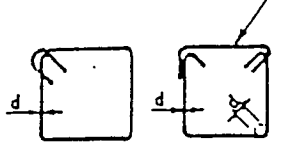


D = 6d FOR #3 TO #8
8d FOR #9 TO #11
10d FOR #14 AND #18

3 STIRRUP

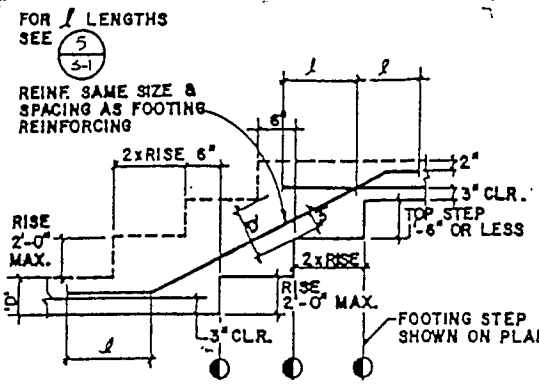

2 STEPPED FOOTING

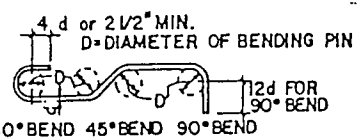


BAR SIZE	MIN. PIN DIA.
#3 THRU #8	6 BAR DIA.
#9 THRU #11	8 BAR DIA.
#14 AND #18	10 BAR DIA.

LEGEND (FOR REINF. BENDS NOT SHOWN TO SCALE)

- DENOTES 90° BEND IN THE PLANE OF THE DWG.
- DENOTES 90° BEND PERPENDICULAR TO THE PLANE OF THE DWG.
- DENOTES BEND PERPENDICULAR TO THE PLANE OF THE DWG.
- DENOTES BEND IN THE PLANE OF THE DWG.
- DENOTES OFFSET IN THE PLANE OF THE DWG.

4 BAR BENDS

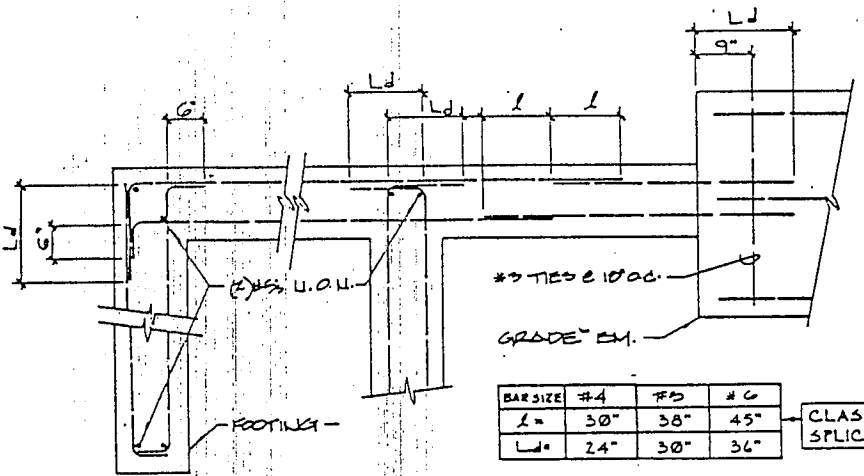

BAR SIZE	#4	#5	#6
L =	30"	38"	45"
Ld =	24"	30"	36"

CLASS "B" SPLICE

5 BAR SPLICE & EMBEDMENT

GENERAL NOTES

- THE CONTRACTOR SHALL VERIFY ALL DIMENSIONS, ELEVATIONS AND SITE CONDITIONS BEFORE STARTING WORK. THE ARCHITECT/ENGINEER SHALL IMMEDIATELY BE NOTIFIED IN WRITING OF ANY DISCREPANCIES.
- ALL DISCREPANCIES AND/OR CONFLICTS BETWEEN THE VARIOUS ELEMENTS OF THE WORKING DRAWINGS AND SPECIFICATIONS SHALL BE BROUGHT TO THE ATTENTION OF AND A SOLUTION GIVEN BY, THE ARCHITECT/ENGINEER BEFORE PROCEEDING WITH ANY WORK SO INVOLVED.
- IN CASE OF CONFLICT, NOTES AND DETAILS OF THESE STRUCTURAL DRAWINGS SHALL TAKE PRECEDENCE OVER THE "GENERAL NOTES" AND/OR "STANDARD DETAILS".
- IF A SPECIFIC DETAIL IS NOT SHOWN FOR ANY PART OF THE WORK, THE CONSTRUCTION SHALL BE THE SAME AS FOR SIMILAR WORK.
- WORKING DIMENSIONS SHALL NOT BE SCALED FROM PLANS, SECTIONS, OR DETAILS ON THESE STRUCTURAL DRAWINGS.
- ALL CONSTRUCTION SHALL BE DONE WITH MATERIALS, METHODS, AND WORKMANSHIP ACCEPTED AS GOOD PRACTICE BY THE CONSTRUCTION INDUSTRY IN CONFORMANCE WITH THE PROVISIONS OF THE 1981 EDITION OF THE "UNIFORM BUILDING CODE" (UBC), AND STANDARDS REFERENCED THEREIN.
- PIPES, DUCTS, SLEEVES, OPENINGS, POCKETS, CHASES, BLOOD-CUTS, ETC., SHALL NOT BE PLACED IN SLABS, FOUNDATIONS, ETC., NOR SHALL ANY STRUCTURAL MEMBER BE CUT FOR SUCH ITEMS, UNLESS SPECIFICALLY DETAILED ON THESE STRUCTURAL DRAWINGS.
- IN AREAS TO BE EXCAVATED, THE CONTRACTOR SHALL DETERMINE THE LOCATIONS OF EXISTING UTILITY SERVICES PRIOR TO EXCAVATION.
- CONTRACTOR AGREES THAT HE SHALL ASSUME SOLE AND COMPLETE RESPONSIBILITY FOR JOB SITE CONDITIONS DURING THE COURSE OF CONSTRUCTION OF THIS PROJECT, INCLUDING SAFETY OF ALL PERSONS AND PROPERTY THAT THIS REQUIREMENT SHALL APPLY CONTINUOUSLY AND NOT BE LIMITED TO NORMAL WORKING HOURS; AND THAT THE CONTRACTOR SHALL DEFEND, INDEMNIFY, AND HOLD THE OWNER AND THE ENGINEER HARMLESS FROM ANY AND ALL LIABILITY, REAL OR ALLEGED, IN CONNECTION WITH THE PERFORMANCE OF WORK ON THIS PROJECT, INCLUDING LIABILITY ARISING FROM THE SOLE NEGLIGENCE OF THE OWNER OR THE ENGINEER.
- SPECIAL INSPECTION
 - SPECIAL INSPECTION IS REQUIRED FOR THE FOLLOWING TYPES OF WORK IN CONFORMANCE WITH SECTION 308 OF THE 1981 EDITION OF THE UBC:
 - HORIZONTAL PLYWOOD DIAPHRAGMS
 - THE FOLLOWING REQUIREMENTS SHALL BE MET FOR SPECIAL INSPECTION:
 - THE SPECIAL INSPECTOR SHALL BE UNDER THE SUPERVISION OF A PROFESSIONAL CIVIL ENGINEER REGISTERED IN ALASKA.
 - THE SPECIAL INSPECTOR SHALL FURNISH INSPECTION REPORTS TO THE BUILDING OFFICIAL, THE DESIGN ENGINEER, THE ARCHITECT, AND OTHER DESIGNATED PERSONS. ALL DISCREPANCIES SHALL BE BROUGHT TO THE IMMEDIATE ATTENTION OF THE CONTRACTOR FOR CORRECTION THEN, IF UNCORRECTED, TO THE PROPER DESIGN AUTHORITY AND THE BUILDING OFFICIAL.
 - THE SPECIAL INSPECTOR SHALL SUBMIT A FINAL REPORT SIGNED BY THE ENGINEER SUPERVISING THE WORK, STATING WHETHER THE WORK INCLUDING SPECIAL INSPECTION WAS IN CONFORMANCE WITH THE APPROVED PLANS AND SPECIFICATIONS AND THE APPLICABLE WORKMANSHIP PROVISIONS OF THE UBC.

- SHOP DRAWINGS
 - SHOP DRAWINGS SHALL BE SUBMITTED TO AND APPROVED BY THE ENGINEER PRIOR TO FABRICATION.
 - SHOP DRAWINGS SHALL BE COMPLETE, CHECKED, AND APPROVED BY THE GENERAL CONTRACTOR BEFORE SUBMITTED TO THE ENGINEER FOR REVIEW. THE GENERAL CONTRACTOR SHALL BE RESPONSIBLE FOR THE CORRECTION AND COORDINATION OF DIMENSIONS AND DETAILS FOR SUB-CONTRACTORS. THE ENGINEER SHALL BE NOTIFIED IMMEDIATELY IF THERE ARE ANY DISCREPANCIES IN THE DIMENSIONS OR DETAILS.
 - SHOP DRAWINGS ARE REQUIRED FOR THE FOLLOWING ITEMS:
 - PRE-FABRICATED WOOD TRUSSES

FOUNDATION

- SOIL DESIGN INFORMATION
 - SOIL DESIGN PRESSURE (ASSUMED):
 - CONTINUOUS FOOTINGS: 1,500 PSF WITH INCREASES PER UBC TABLE 25-8
 - PIED FOOTINGS: 1,500 PSF WITH INCREASES PER UBC TABLE 25-8
 - BOTTOM OF FOOTINGS SHALL BE AT LEAST 3" BELOW LOWEST ADJACENT EXTERIOR FINISH GRADE, AND 12" BELOW LOWEST ADJACENT FINISH GRADE.
- PRIOR TO EXCAVATING FOR FOUNDATIONS, THE SOILS ENGINEER SHALL VERIFY, IN WRITING TO THE ENGINEER, THAT SITE PREPARATION COMPLIES WITH ALL OF THE RECOMMENDATIONS AND CONCLUSIONS OF NOTE 1 ABOVE.
- ALL SOIL COMPACT AND SITE PREPARATION WORK SHALL BE DONE UNDER THE DIRECT OBSERVATION OF A REGISTERED ALASKAN CIVIL ENGINEER OR ENGINEERING GEOLOGIST PRACTICING IN THE STATE OF ALASKA.
- THE FINISH EXCAVATION FOR FOUNDATIONS SHALL BE NEAT AND TRUE TO LINE WITH ALL LOOSE MATERIAL AND STANDING WATER REMOVED BEFORE CONCRETE IS PLACED. PRIOR TO THE PLACEMENT OF ANY CONCRETE, THE EXCAVATIONS SHALL BE INSPECTED AND APPROVED, IN WRITING, BY A REGISTERED ALASKAN CIVIL ENGINEER OR ENGINEERING GEOLOGIST PRACTICING IN THE STATE OF ALASKA.
- A TESTING LAB SHALL SUBMIT COMPACTION REPORTS FOR ALL FILL TO THE ENGINEER PRIOR TO REQUESTING THE FOUNDATION INSPECTION NOTED IN NO. 4 ABOVE.
- ALL LOOSE SOIL AND FILL DIRT, INCLUDING BACKFILL BEHIND RETAINING WALLS, SHALL BE COMPACTED TO AT LEAST 90% OF MAXIMUM DENSITY.
- BACKFILL FOR ALL RETAINING WALLS SHALL BE PERVIOUS MATERIAL AND SHALL NOT BE PLACED UNTIL MASONRY OR CONCRETE RETAINING WALLS HAVE BEEN IN PLACE A MINIMUM OF 14 DAYS OR HAVE OBTAINED 75% OF THE DESIGN STRENGTH.
- PRIOR TO BACKFILLING, PROVIDE TEMPORARY SHORING FOR ALL WALLS RETAINING EARTH, UNLESS OTHERWISE NOTED.
- TEMPORARY SHORING FOR ALL RETAINING WALLS REQUIRING PERMANENT STRUCTURAL SUPPORT AT THE TOP OF THE WALL SHALL REMAIN IN PLACE UNTIL SUCH SUPPORTS ARE INSTALLED.

REINFORCING STEEL

- BAR REINFORCEMENT SHALL CONFORM TO THE FOLLOWING GRADES OF ASTM A618, INCLUDING SUPPLEMENT S1:
 - #3 GRADE 40
 - #4 AND LARGER GRADE 60
- DETAILS OF REINFORCEMENT SHALL BE IN ACCORDANCE WITH CHAPTER 7 OF THE AMERICAN CONCRETE INSTITUTE (ACI 318-83) REVISED 1989, UNLESS OTHERWISE NOTED.
- LAPS AT BAR SPLICES IN CONCRETE CONSTRUCTION SHALL BE CLASS A, B, OR C IN ACCORDANCE WITH CHAPTER 12 OF ACI 318-83 REVISED 1989, UNLESS OTHERWISE NOTED.
- VERTICAL BARS IN CONCRETE WALLS SHALL BE ACCURATELY POSITIONED AT THE CENTER OF THE WALL, UNLESS OTHERWISE NOTED ON THE DETAILS.
- ALL REINFORCING STEEL SHALL BE SECURELY TIED IN POSITION PRIOR TO PLACING CONCRETE OR GROUT.
- WELDED WIRE FABRIC SHALL CONFORM TO ASTM A116.
- LAPS OF WELDED WIRE FABRIC AT SPLICES SHALL BE IN CONFORMANCE WITH ACI 318-83 REVISED 1989, BUT NOT BE LESS THAN 8 INCHES.
- CHAINS BETWEEN SUPPORTING FOOTINGS AND WALLS, PLASTERS, OR COLLARS SHALL BE THE SAME SIZE, GRADE, AND AT THE SAME SPACING AS THE VERTICAL REINFORCEMENT, UNLESS OTHERWISE NOTED ON THE DETAILS.
- BAR SUPPORTS SHALL BE PROVIDED IN ACCORDANCE WITH THE PROVISIONS OF "BAR SUPPORT SPECIFICATIONS" AS CONTAINED IN THE LATEST EDITION OF THE "MANUAL OF STANDARD PRACTICE" BY THE CONCRETE REINFORCING STEEL INSTITUTE (CRSI).
- SEE THE "REINFORCED CONCRETE" NOTES FOR THE REQUIRED CONCRETE COVER FOR CAST-IN-PLACE CONCRETE.
- REINFORCING STEEL DETAILING, BENDING, AND PLACING SHALL BE IN ACCORDANCE WITH THE LATEST EDITION OF THE "MANUAL OF STANDARD PRACTICE" BY CRSI.
- WELDING OF CROSSING BARS AND TACK WELDING OF REINFORCEMENT SHALL NOT BE PERMITTED.

PRE-FABRICATED WOOD TRUSSES

- REINFORCED CONCRETE SHALL CONFORM TO THE FOLLOWING:
 - MINIMUM 28 DAY COMPRESSIVE STRENGTH SHALL BE AS FOLLOWS:
 - FOUNDATION SLABS ON GRADE: 2500 PSI
 - SLABS ON GRADE: 2500 PSI
 - THE MINIMUM SUMP SHALL BE 4 INCHES.
 - THE MINIMUM COVER CONTENT SHALL BE SIX BAGS PER CUMULATIVE YARD OF CONCRETE.
 - SLABS & OTHER PLATFORMS SHALL BE AN EXTENDED, HAVE A MINIMUM SUMP OF 3 INCHES AND A MAXIMUM WATER/CEMENT RATIO OF 0.50.
- PORTLAND CEMENT SHALL CONFORM TO ASTM C150, TYPE I OR II.
- AGGREGATES FOR NORMAL WEIGHT CONCRETE SHALL CONFORM TO ASTM C68.
- CONCRETE WORK SHALL CONFORM TO ALL REQUIREMENTS OF ACI 301, "SPECIFICATIONS FOR STRUCTURAL CONCRETE FOR BUILDINGS," EXCEPT AS MODIFIED BY THESE NOTES.
- ADJUSTURES MAY BE USED WITH PRIOR APPROVAL OF THE ENGINEER. ADJUSTURES SHALL COMPLY WITH ASTM A955. ADJUSTURES USED TO INCREASE THE WORKABILITY OF THE CONCRETE SHALL NOT BE CONSIDERED TO REDUCE THE SPECIFIED MINIMUM COVER CONTENT. ADJUSTURES CONTAINING CHLORIDES SHALL NOT BE USED.
- READY-MIX CONCRETE SHALL BE MIXED AND DELIVERED IN ACCORDANCE WITH ASTM C94.
- MINIMUM CONCRETE COVER (IN INCHES) FOR REINFORCING STEEL SHALL BE AS FOLLOWS, UNLESS OTHERWISE NOTED:

LOCATION (TYPE OF CONCRETE)	MINIMUM COVER, INCHES
CAST-IN-PLACE CONCRETE NON-PRESTRESSED	
1. CAST AGAINST AND PERMANENTLY EXPOSED TO EARTH	3
2. FORMED SURFACES EXPOSED TO EARTH OR WEATHER	2
#5 AND LARGER BARS	2
#3 BARS, #4 8 INCH WIDE, AND SMALLER	1-1/2
3. CONCRETE SURFACES NOT EXPOSED TO EARTH OR WEATHER	
SLABS, WALLS, JOISTS	
#14 AND #18 BARS	1-1/2
#11 AND SMALLER	3/4
BEAMS, COLUMNS	
PRIMARY REINFORCEMENT TIES, STIRRUPS, SPIRALS	1-1/2
- SLEEVES, PIPES, OR CONDUITS SHALL NOT BE PLACED THROUGH CONTINUOUS OR SPREAD FOOTINGS, GRADE BEAMS, OR THE BEAMS.
- CONDUIT SHALL NOT BE PLACED IN ANY CONCRETE SLAB LESS THAN 3-1/2 INCHES THICK. IF CONDUIT IS PLACED IN A CONCRETE SLAB, ITS OUTSIDE DIAMETER SHALL NOT BE GREATER THAN ONE-THIRD OF THE SLAB THICKNESS. THE MINIMUM CLEAR DISTANCE BETWEEN CONDUITS SHALL BE 4 INCHES.
- ALL EXPOSED CORNERS SHALL BE CHAMFERED 3/4 INCH, UNLESS OTHERWISE NOTED.
- REFER TO ARCHITECTURAL DRAWINGS FOR MOLDS, GROOVES, ORNAMENTS, CLIPS, OR GROUNDS REQUIRED TO BE CAST IN THE CONCRETE AND FOR EXTENT OF DEPRESSIONS, CURBS, AND PAMPS.
- ALL VERTICAL SURFACES OF CONCRETE ABOVE FINISHED GRADE SHALL BE FORMED.
- CONSTRUCTION JOINTS SHALL BE ADEQUATELY KEVED. THEIR LOCATIONS AND DETAILS, WHEN NOT SHOWN ON THE PLANS, SHALL BE SUBJECT TO THE APPROVAL OF THE STRUCTURAL ENGINEER.
- CONCRETE PLACEMENTS SHALL BE CONTINUOUS BETWEEN CONSTRUCTION JOINTS.
- UNLESS SHOWN OTHERWISE ON THE DRAWINGS, SLABS-ON-GRADE SHALL BE CAST IN SQUARE OR RECTANGULAR PATTERNS NOT EXCEEDING 400 SQUARE FEET, WITH A MAXIMUM DISTANCE OF 30 FEET BETWEEN CONSTRUCTION, WEAKENED PLANE, OR EXPANSION JOINTS.

STRUCTURAL WOOD

- SAWN WOOD MEMBERS SHALL BE DOUGLAS FIR OR LARCH NO. 2 OR BETTER, UNLESS OTHERWISE NOTED, S4S, CONFORMING TO THE "UNIFORM BUILDING CODE" (UBC) STANDARDS 25-1, 25-2, 25-3, AND 25-4 AND SHALL BE GRADE MARKED BY A REGISTERED GRADING AGENCY APPROVED BY THE INTERNATIONAL CONFERENCE OF BUILDING OFFICIALS (ICBO).
- SHEATHING SHALL BE PLYWOOD OR ORIENTED STRAND BOARD AND SHALL BE APA RATED SHEATHING AND SHALL CONFORM TO THE REQUIREMENTS OF UBC STANDARD 25-8 AND SHALL BE OF THICKNESS AND GRADE AS NOTED ON THE STRUCTURAL DRAWINGS, AND SHALL BE STAMPED WITH THE TRADEMARK OF THE AMERICAN PLYWOOD ASSOCIATION.
- FRAMING ANCHORS, STRAPS, JOIST HANDERS, ETC., SHALL BE AS MANUFACTURED BY "TAMPOSON COMPANY" OR AN APPROVED EQUAL.
- BOLTS SHALL CONFORM TO ASTM A307. NUTS SHALL CONFORM TO THE REQUIREMENTS OF ASTM A302, HEX GRADE A.
- ALL BOLT HEADS, NUTS, AND LAG SCREWS BEARING ON WOOD SHALL HAVE CUT WASHERS, UNLESS OTHERWISE NOTED.
- BOLT HOLES IN WOOD SHALL BE DRILLED 1/32" LARGER THAN THE NOMINAL BOLT DIAMETER.
- HALFS OF SAWN WOOD MEMBERS SHALL BE WITH CORNER HALFS, UNLESS OTHERWISE NOTED, WHERE NOT SHOWN ON THE DRAWINGS, HALFS SHALL CONFORM TO TABLE 25-10 OF THE UBC.
- DIAPHRAGM NAILING SHALL CONFORM TO TABLE 25-J AND 25-K OF UBC (COMMON NAILS) WITH NAIL SCHEDULE DEFINED AS FOLLOWS:
 - 3N = NAILING AT DIAPHRAGM BOUNDARIES, CONTINUOUS PANEL EDGES, AND AT EDGES OF OPENINGS.
 - 1N = EDGE NAILING.
 - IN = INTERMEDIATE NAILING.
- IN HORIZONTAL DIAPHRAGMS OR VERTICAL SHEAR WALLS, NO PANEL LESS THAN 24" WIDE SHALL BE USED, UNLESS ALL EDGES ARE SUPPORTED ON FRAMING OR BLOCKED.
- WOOD MEMBERS SHALL BE ERECTED WITH THE NATURAL CAMBER UP.
- ALL NAILS LARGER THAN 16D AND ALL NAILING TENDING TO CAUSE SPLITTING OF WOOD MEMBERS, SHALL BE INSTALLED IN PRE-DRILLED HOLES.
- CUTTING, NOTCHING, OR DRILLING OF BEAMS/JOISTS/POSTS TO BE PERMITTED ONLY AS DETAILED OR APPROVED BY THE ENGINEER.
- ALL SILLS OR PLATES RESTING ON CONCRETE OR MASONRY WHICH IS IN CONTACT WITH EARTH, SHALL BE PRESURE TREATED IN CONFORMANCE WITH UBC STANDARD 25-12. SURFACES THAT ARE DAMAGED OR EXPOSED BY CUTTING, DRILLING, OR NOTCHING SHALL BE TREATED WITH A PRESERVATIVE PER UBC STANDARD 25-12.
- ALL ABOVE GROUND MEMBERS NOTED ON PLANS AS "TREATED" SHALL BE PRESURE TREATED WITH ANTIMONIAL COPPER ZINC ARSENATE (MCAZ) - CHENOTEX TO A MINIMUM OF .25 LBS/CUBIC FOOT RETENTION PER THE WESTERN WOOD PRESERVERS' INSTITUTE RECOMMENDED SPECIFICATIONS.
- PROVIDE BLOCKING ON BRIDGING PER SECTION 2509-9 AND 2517-10 OF THE UBC.
- UNLESS OTHERWISE NOTED, TOP PLATES OF ALL WOOD STUD WALLS SHALL BE 2X2 (SAME DEPTH AS STUDS) LAPPED 48" MINIMUM WITH NOT LESS THAN 8-16D NAILS AT EACH SIDE OF THE LAP.
- MOISTURE CONTENT OF WOOD AT TIME OF PLACING SHALL NOT EXCEED 19 PERCENT.

GLUE-LAMINATED TIMBERS

- MANUFACTURE OF GLUE-LAMINATED TIMBERS SHALL BE IN CONFORMANCE WITH A190.1-1983, PUBLISHED BY AMERICAN NATIONAL STANDARDS INSTITUTE/AMERICAN INSTITUTE OF WOODEN CONSTRUCTION (ANSI/ICC).
- GLUE-LAMINATED TIMBERS SHALL BE INDUSTRIAL APPEARANCE GRADE, USING EXTERIOR GLUE, COMBINATION STUDS, 3/4"-W FOR SIMPLE SPANS AND 2"-W FOR CONTINUOUS SPAN OR CHAIR-LEVELLED MEMBERS.
- GLUE-LAMINATED TIMBERS SHALL BE FABRICATED IN A PLANT WITH AN APPROVED QUALITY CONTROL SYSTEM, LICENSED BY ATC.
- MANUFACTURER OF GLUE-LAMINATED TIMBERS SHALL STAMP MEMBERS WITH A QUALITY MARK OF THE ATC INSPECTION ORGANIZATION AND SHALL SUBMIT AN ATC INSPECTION CERTIFICATE TO THE BUILDING INSPECTION DEPARTMENT AND THE ENGINEER PRIOR TO INSTALLATION.

PRE-FABRICATED WOOD TRUSSES AND TRUSS GIRDERS SHALL BE TRUSS/SLAB TRUSSES AS MANUFACTURED BY JANEAU TRUSS. CONTRACTOR SHALL SUBMIT TRUSS LAYOUT, DIMENSIONS, DETAILS, AND CALCULATIONS TO THE ENGINEER AND BUILDING DEPARTMENT FOR APPROVAL PRIOR TO FABRICATION.

- THESE PLANS HAVE BEEN CALCULATED AND DETAILED FOR THE SPECIFIC TRUSS MANUFACTURED BY JANEAU TRUSS CO. IF ANY SUBSTITUTION IS PROPOSED BY THE CONTRACTOR, NEW CALCULATIONS WILL HAVE TO BE PREPARED. THE DETAILS MAY NOT BE ALTERED, AND NEW PLANS MAY HAVE TO BE SUBMITTED TO THE BUILDING DEPARTMENT. THE CONTRACTOR SHALL PROVIDE AN ALLOWANCE TO COVER THE ENGINEER'S FEES TO ALTER THE APPROVED PLANS AND TO PROCESS THROUGH THE BUILDING DEPARTMENT.
- CONTRACTOR SHALL SUBMIT BRACING LAYOUT AND DETAILS, INCLUDING BRIDGES, HANDERS, STIFFENERS, CLIPS, AND OTHER HARDWARE PROVIDED FOR INSTALLATION, TO THE ENGINEER AND BUILDING DEPARTMENT FOR APPROVAL PRIOR TO FABRICATION.
- ALL TRUSSES SUPPORTING MECHANICAL EQUIPMENT SHALL BE DESIGNED BY TRUSS MANUFACTURER AND SUBMITTED TO ENGINEER FOR APPROVAL.
- THE TRUSS SYSTEM SHALL BE DESIGNED FOR THE FOLLOWING CRITERIA:
 - ROOF SHOW LOAD: 45 PSF PER UBC APPENDIX CHAPTER 21, DIVISION 1
 - 23 PSF
 - UNIFORM
 - UNIFORM
- FIFTEEN PERCENT INCREASE OF THE LAMBER STRESSES SHALL BE ALLOWED FOR SNOW LOAD.

DESIGN CRITERIA
 ROOF SHOW LOAD: 45 PSF PER UBC CHAPTER 21, DIVISION 1
 SLAB ON GRADE: 100 PSF
 WIND: 100 MPH EXPOSURE C
 SEISMIC ZONE 2B, Z = 2.1 = 1.0 C = 3.75, P_s = 4
 UNIFORM BUILDING CODE: 1981 EDITION

NOTE: THESE STRUCTURAL NOTES PERTAIN TO CRAIG SEAPLANE BASE BUILDING ONLY.

NOTE: DO NOT SCALE FROM THESE PLANS—USE DIMENSIONS

STATE OF ALASKA
 DEPARTMENT OF TRANSPORTATION
 AND PUBLIC FACILITIES
 SOUTHEAST REGION DESIGN & CONSTRUCTION

CRAIG
 ALASKA
 CRAIG SEAPLANE BASE EXPANSION
 AIP # 3-02-0071-01
 GENERAL NOTES & TYPICAL DETAILS

DESIGNED BY: K.J.W.
 PROJECT NO. 69956
 DRAWN BY: D.S.
 DATE: AUGUST, 1994
 CHECKED BY: M.C.S./M.A.M.
 SHEET 45 OF 60



ENGINEER'S SEAL
 STATE OF ALASKA
 49th
 Michael C. Story
 CE-0667
 REGISTERED PROFESSIONAL ENGINEER

PATH:	DATE:	DESCRIPTION OF CHANGE:


RECORD OF REVISIONS

* SEE GENERAL NOTES, STRUCT. WOOD, NOTE 3.


HOLDOWN	BOULTS	ANCH. BOLT	DIM.		
			A	B	C
HD-10A	(4) 7/8"	7/8"	10"	7"	2 1/2"
HD-8A	(3) 7/8"	7/8"	15"	6 1/2"	2 1/2"
HD-5A	(2) 7/4"	3/4"	11"	5 1/4"	2 1/2"

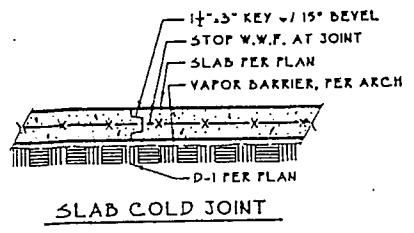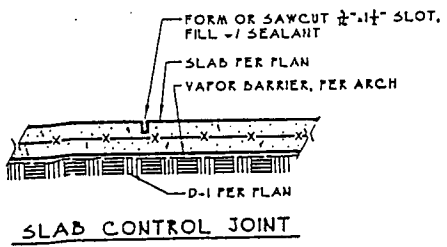


A SLAB JOINTS

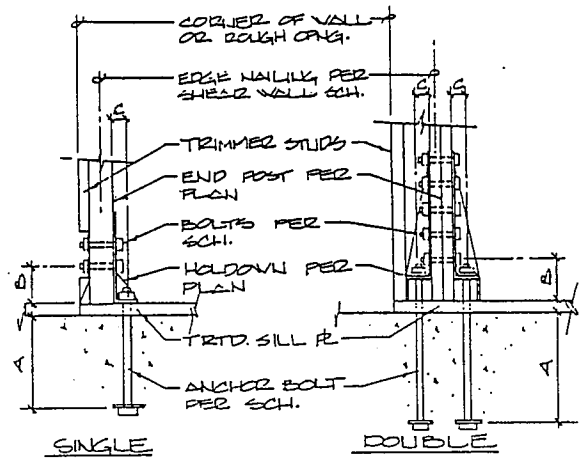


B HOLDOWN @ SLAB

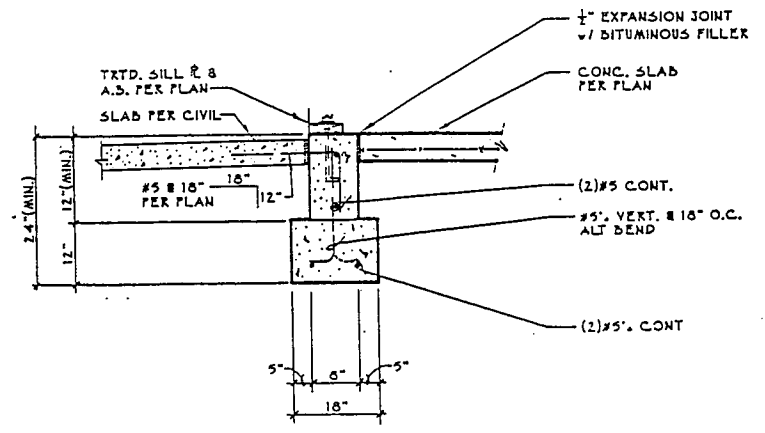

C TYPICAL SECTION

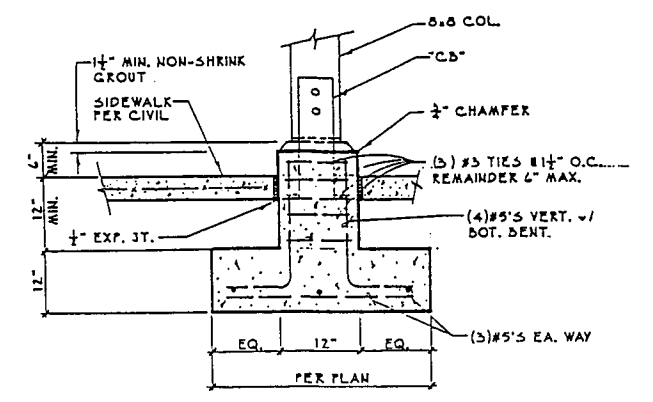

D 12\"/>

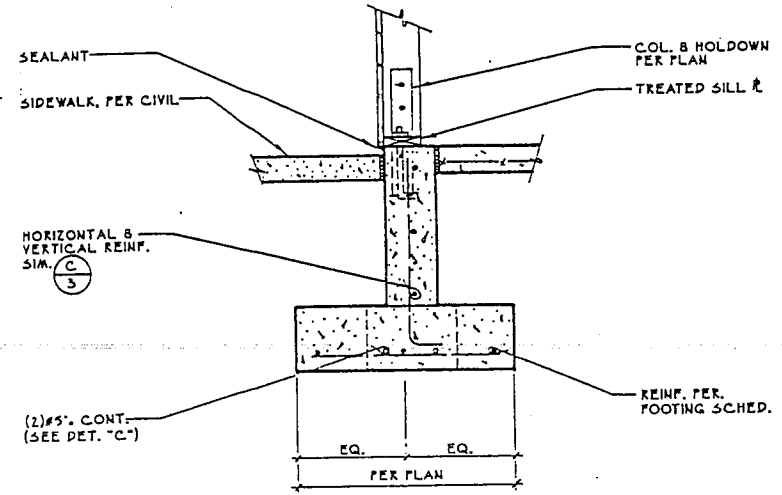

E COL. @ EXTERIOR WALL

RECORD OF REVISIONS

NO.	DATE	DESCRIPTION OF CHANGE

STATE OF ALASKA
 DEPARTMENT OF TRANSPORTATION
 AND PUBLIC FACILITIES
 SOUTHEAST REGION DESIGN & CONSTRUCTION

CRAIG

CRAIG SEAPLANE BASE EXPANSION
 AIP # 3-02-0071-01
 FOUNDATION DETAILS


ALASKA

NOTE: DO NOT SCALE FROM THESE PLANS-USE DIMENSIONS

DESIGNED BY: K.J.W.	PROJECT NO. 69956
DRAWN BY: F.M.	DATE: AUGUST, 1994
CHECKED BY: M.C.S./M.A.M.	SHEET 47 OF 40


DRAWING 53
 ENGINEER'S SEAL

R & M PROJECT # 131300

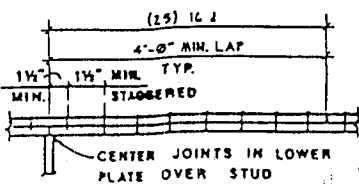


- NOTES:**
1. NUMBER OF NAILS OR BOLTS LISTED SHALL BE USED EACH SIDE OF UPPER AND LOWER PLATE JOINTS.
 2. ALL PLATES D.F. 12, U.O.N.
 3. MIN. SPLICE SHALL BE 6-16D, U.O.N.
 4. PLATES SHALL BE 6" WIDE (NOMINAL) OR D.F. 11.


(A) WALL SPLICE DBL. TOP PLATES

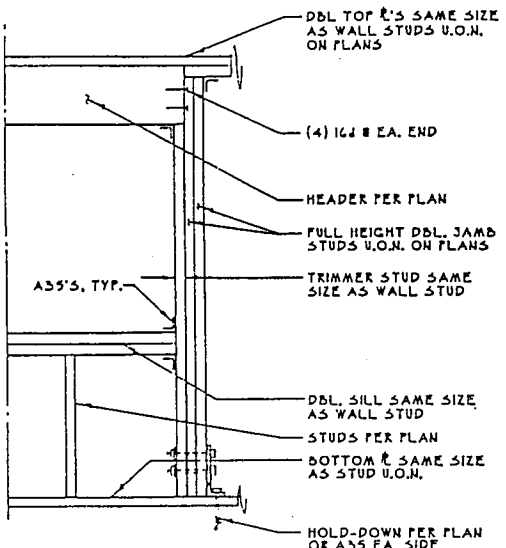


(B) TYP. HEADER
SPLICE TOP R'S SIM. TO DET. "A"

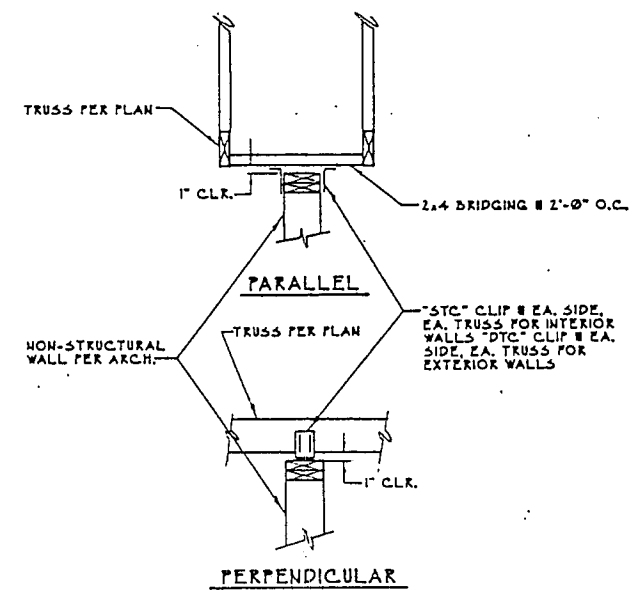


(C) NON-BEARING WALL TO TRUSS

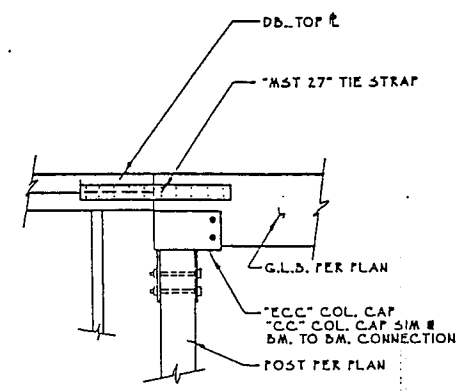


(D) TYP. WOOD POST CAP

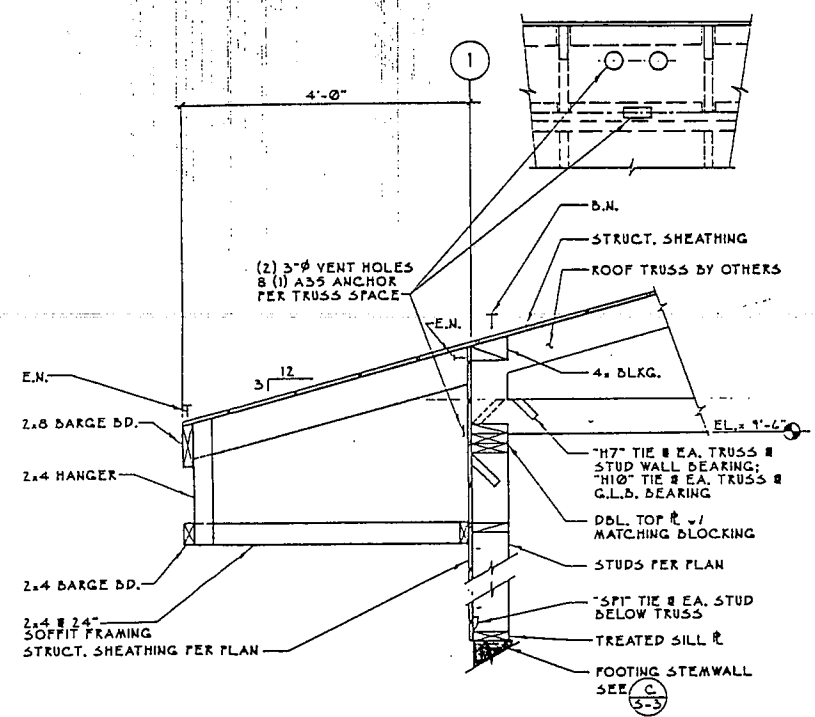

(F) TRUSS TO WALL

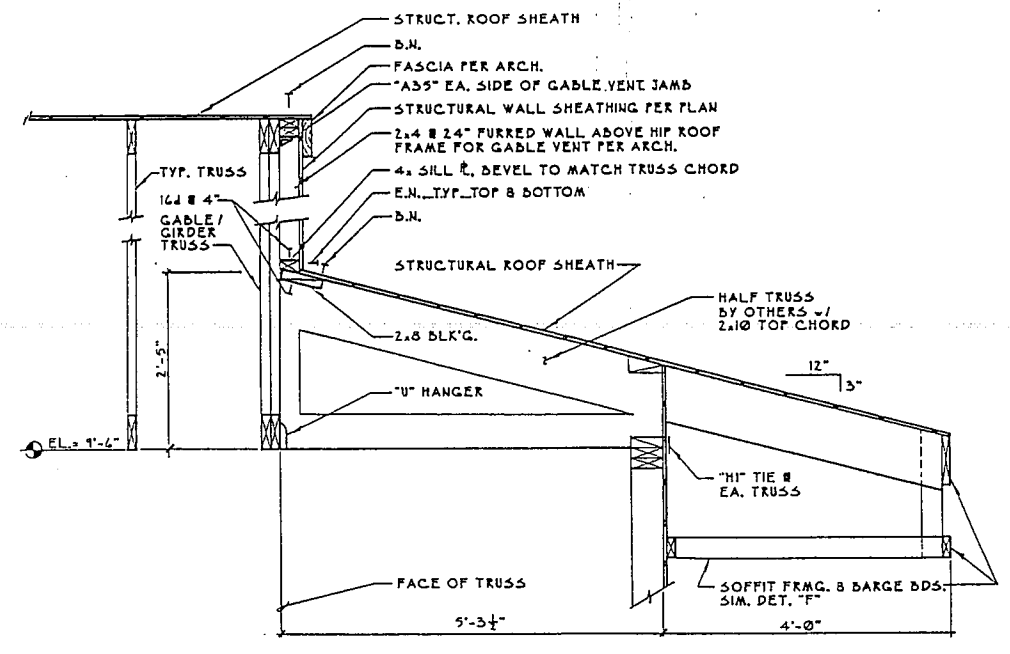

(G) HALF TRUSS
(HIP TRUSS SIM.)

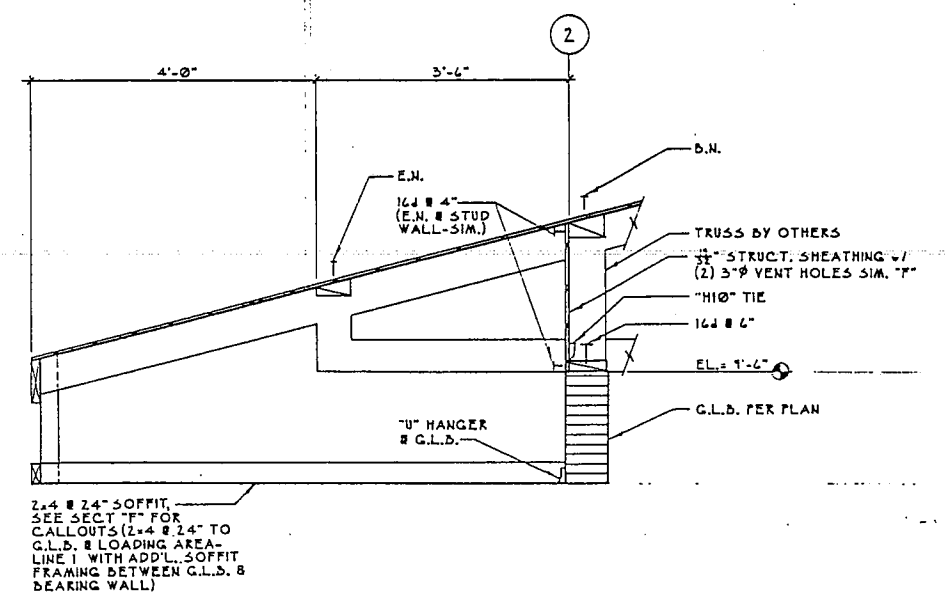

(H) TRUSS TO BEAM

R&M PROJECT # 131500

DATE	DESCRIPTION OF CHANGE

RECORD OF REVISIONS

STATE OF ALASKA
DEPARTMENT OF TRANSPORTATION
AND PUBLIC FACILITIES
SOUTHEAST REGION DESIGN & CONSTRUCTION

CRAIG


CRAIG SEAPLANE BASE EXPANSION
AIP # 3-02-0071-01
ROOF & WALL DETAILS


ALASKA

NOTE: DO NOT SCALE FROM THESE PLANS-USE DIMENSIONS

DESIGNED BY: K.J.W.	PROJECT NO. 69956
DRAWN BY: D.S.	DATE: AUGUST, 1994
CHECKED BY: M.C.S./M.A.M.	SHEET 49 OF 60

DRAWING 55
ENGINEER'S SEAL

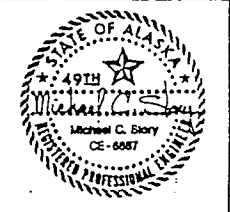

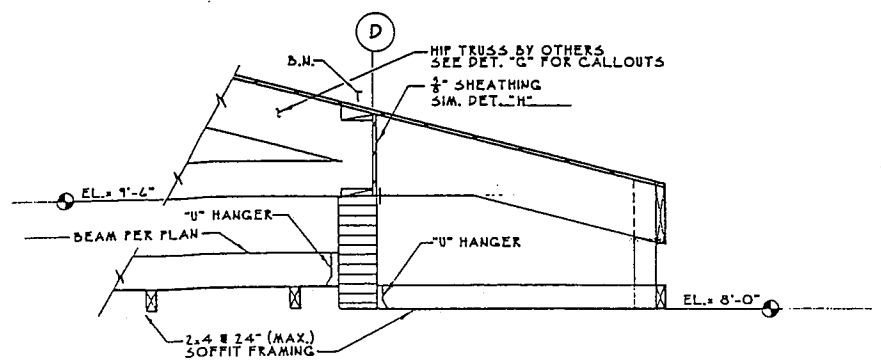

③ HALF TRUSS TO BEAM

DRAWING 56

ENGINEER'S SEAL

NOTE: DO NOT SCALE FROM THESE PLANS—USE DIMENSIONS

RECORD OF REVISIONS		
NO.	DATE	DESCRIPTION OF CHANGE

STATE OF ALASKA
DEPARTMENT OF TRANSPORTATION
AND PUBLIC FACILITIES
SOUTHEAST REGION DESIGN & CONSTRUCTION


CRAIG

CRAIG SEAPLANE BASE EXPANSION
AIP # 3-02-0071-01
ROOF & WALL DETAILS

ALASKA

DESIGNED BY: K.J.W.
DRAWN BY: D.S.
CHECKED BY: M.C.S./M.A.M.

PROJECT NO.
69956
DATE: AUGUST, 1974
SHEET 50 OF 60

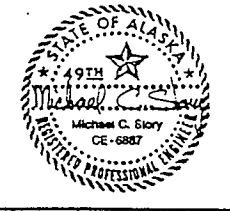


K&W PROJECT # 131000

SYMBOLS

- HS HEATING SUPPLY
- HR HEATING RETURN
- CW COLD WATER
- HW HOT WATER
- HWR HOT WATER RECIRCULATING
- OS OIL SUPPLY
- OR OIL RETURN
- V VENT
- DRAINAGE
- U UNION
- [] CAPPED OR PLUGGED
- PITCHED DOWN
- DV DRAIN VALVE
- GLOBE VALVE
- GATE VALVE
- RISING STEM GATE VALVE
- CHECK VALVE
- IMMERSION THERMOSTAT
- ROOM THERMOSTAT
- PRESSURE GAGE
- VACUUM GAGE
- THERMOMETER
- FLOWSETTER WITH NUMBER DESIGNATION
- AUTOMATIC VALVE
- SUPPLY DUCT - UP, DOWN
- RETURN DUCT - UP, DOWN
- 000 AIR VOLUME
- 12x12 DIFFUSER/GRILLE SIZE
- RC-40 DIFFUSER PATTERN
- AAV AUTOMATIC AIR VENT
- AV AUTOMATIC VALVE
- B MANUAL DAMPER - BUTTERFLY
- BBD BACKBLADE DAMPER
- CUH CABINET UNIT HEATER
- CV CONNECTOR
- DF DRINKING FOUNTAIN
- FCO FLOOR CLEANOUT
- HRV HEAT RECOVERY VENTILATOR UNIT
- FD FLOOR DRAIN
- L LAVATORY
- LA LAVATORY-DISABLED TYPE
- OSA OUTSIDE AIR
- P PUMP
- SA SUPPLY AIR
- U URINAL
- UJ URINAL-DISABLED TYPE
- VTR VENT THROUGH ROOF
- UH UNIT HEATER
- WC WATER CLOSET
- WC WATER CLOSET-DISABLED TYPE

MECHANICAL ROOM PIPING SHOWN ON MECHANICAL ROOM PIPING PLAN THIS SHEET. DUCTWORK TO BE INSTALLED HIGH, WITH PIPING BELOW.

3"x4" MOUNTING BOARD, INCLUDED HEREUNDER, STARTERS MOUNTED UNDER ELECTRICAL DIVISION.

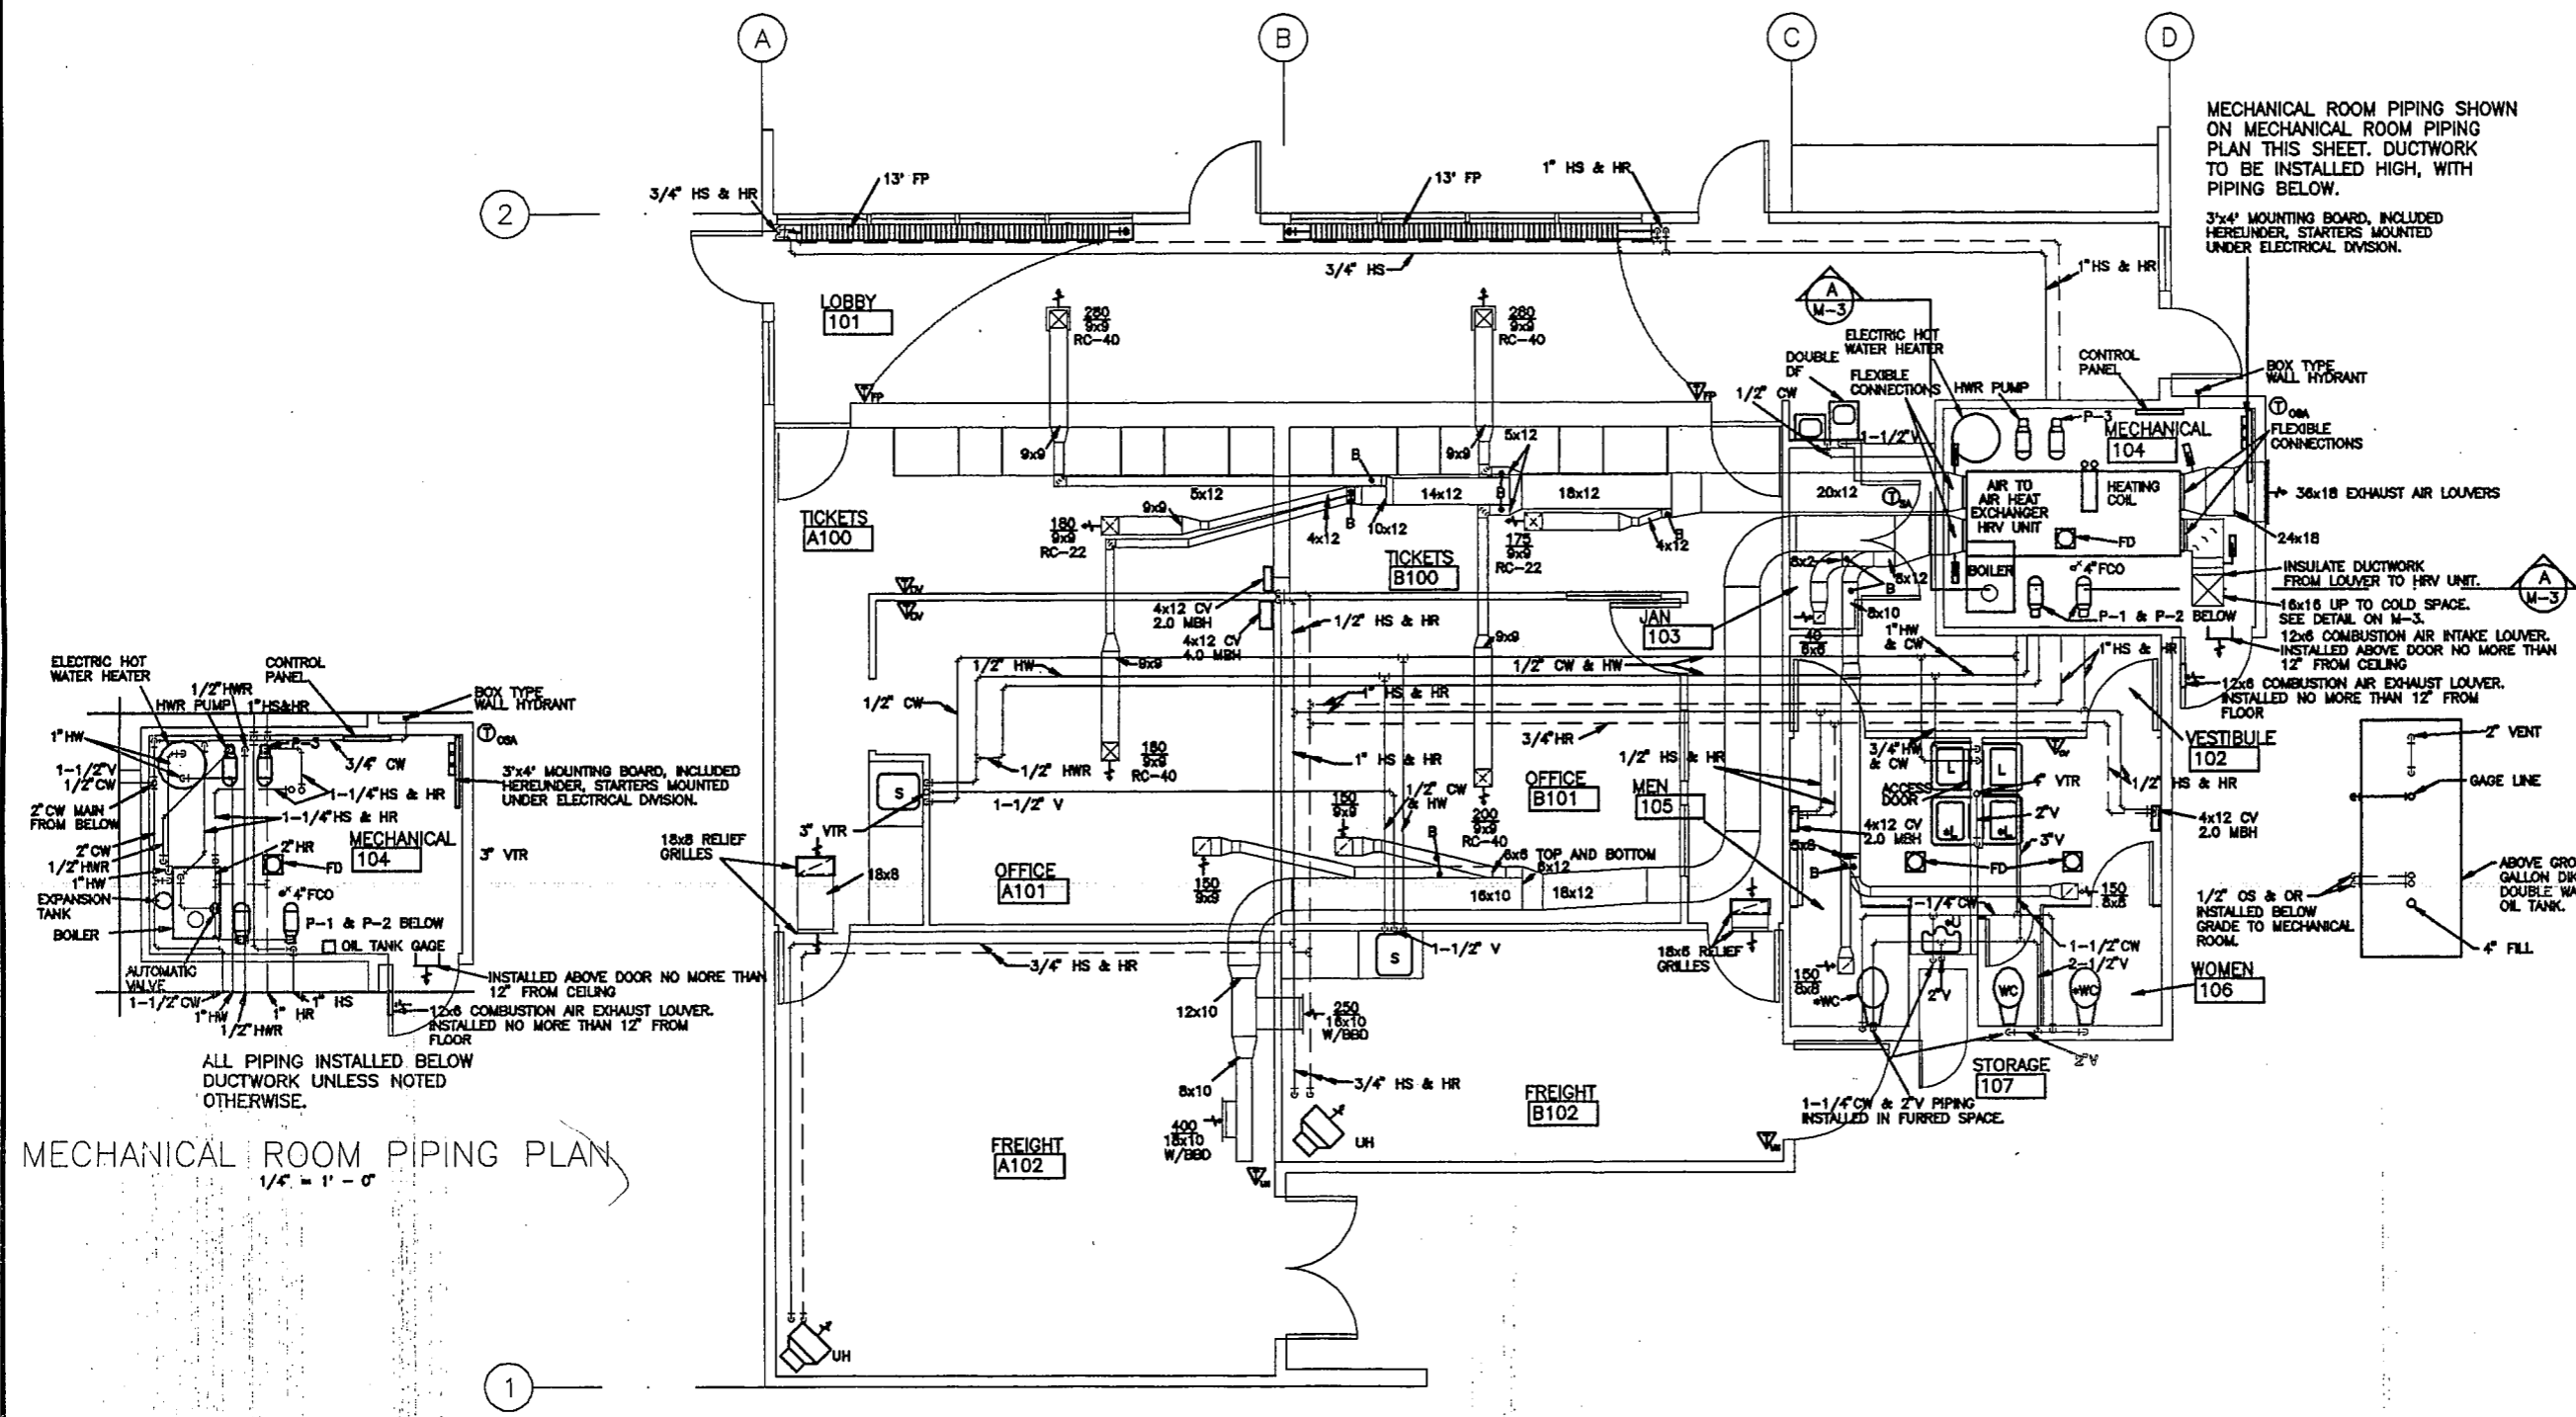

MECHANICAL ROOM PIPING PLAN
1/4" = 1'-0"

FLOOR PLAN
1/4" = 1'-0"

NOTE:

DRAWING M1

AKIN-MURRAY AND ASSOCIATES
CONSULTING ENGINEERS

DO NOT SCALE FROM THESE PLANS - USE DIMENSIONS

ENGINEER'S SEAL

P. O. BOX 21081 JUNEAU, ALASKA 99822 TEL: 907 586-8522 FAX: 907 586-8066



RECORD OF REVISIONS		
NO.	DATE	DESCRIPTION OF CHANGE


STATE OF ALASKA
DEPARTMENT OF TRANSPORTATION AND PUBLIC FACILITIES
SOUTHEAST REGION DESIGN & CONSTRUCTION

CRAIG
CRAIG SEAPLANE BASE EXPANSION
AIP # 3-02-0071-01
FLOOR PLAN


ALASKA

DESIGNED BY: SH
DRAWN BY: SH
CHECKED BY: DM

PROJECT NO. 10-76
DATE: 8/94
SHEET 51 OF 60

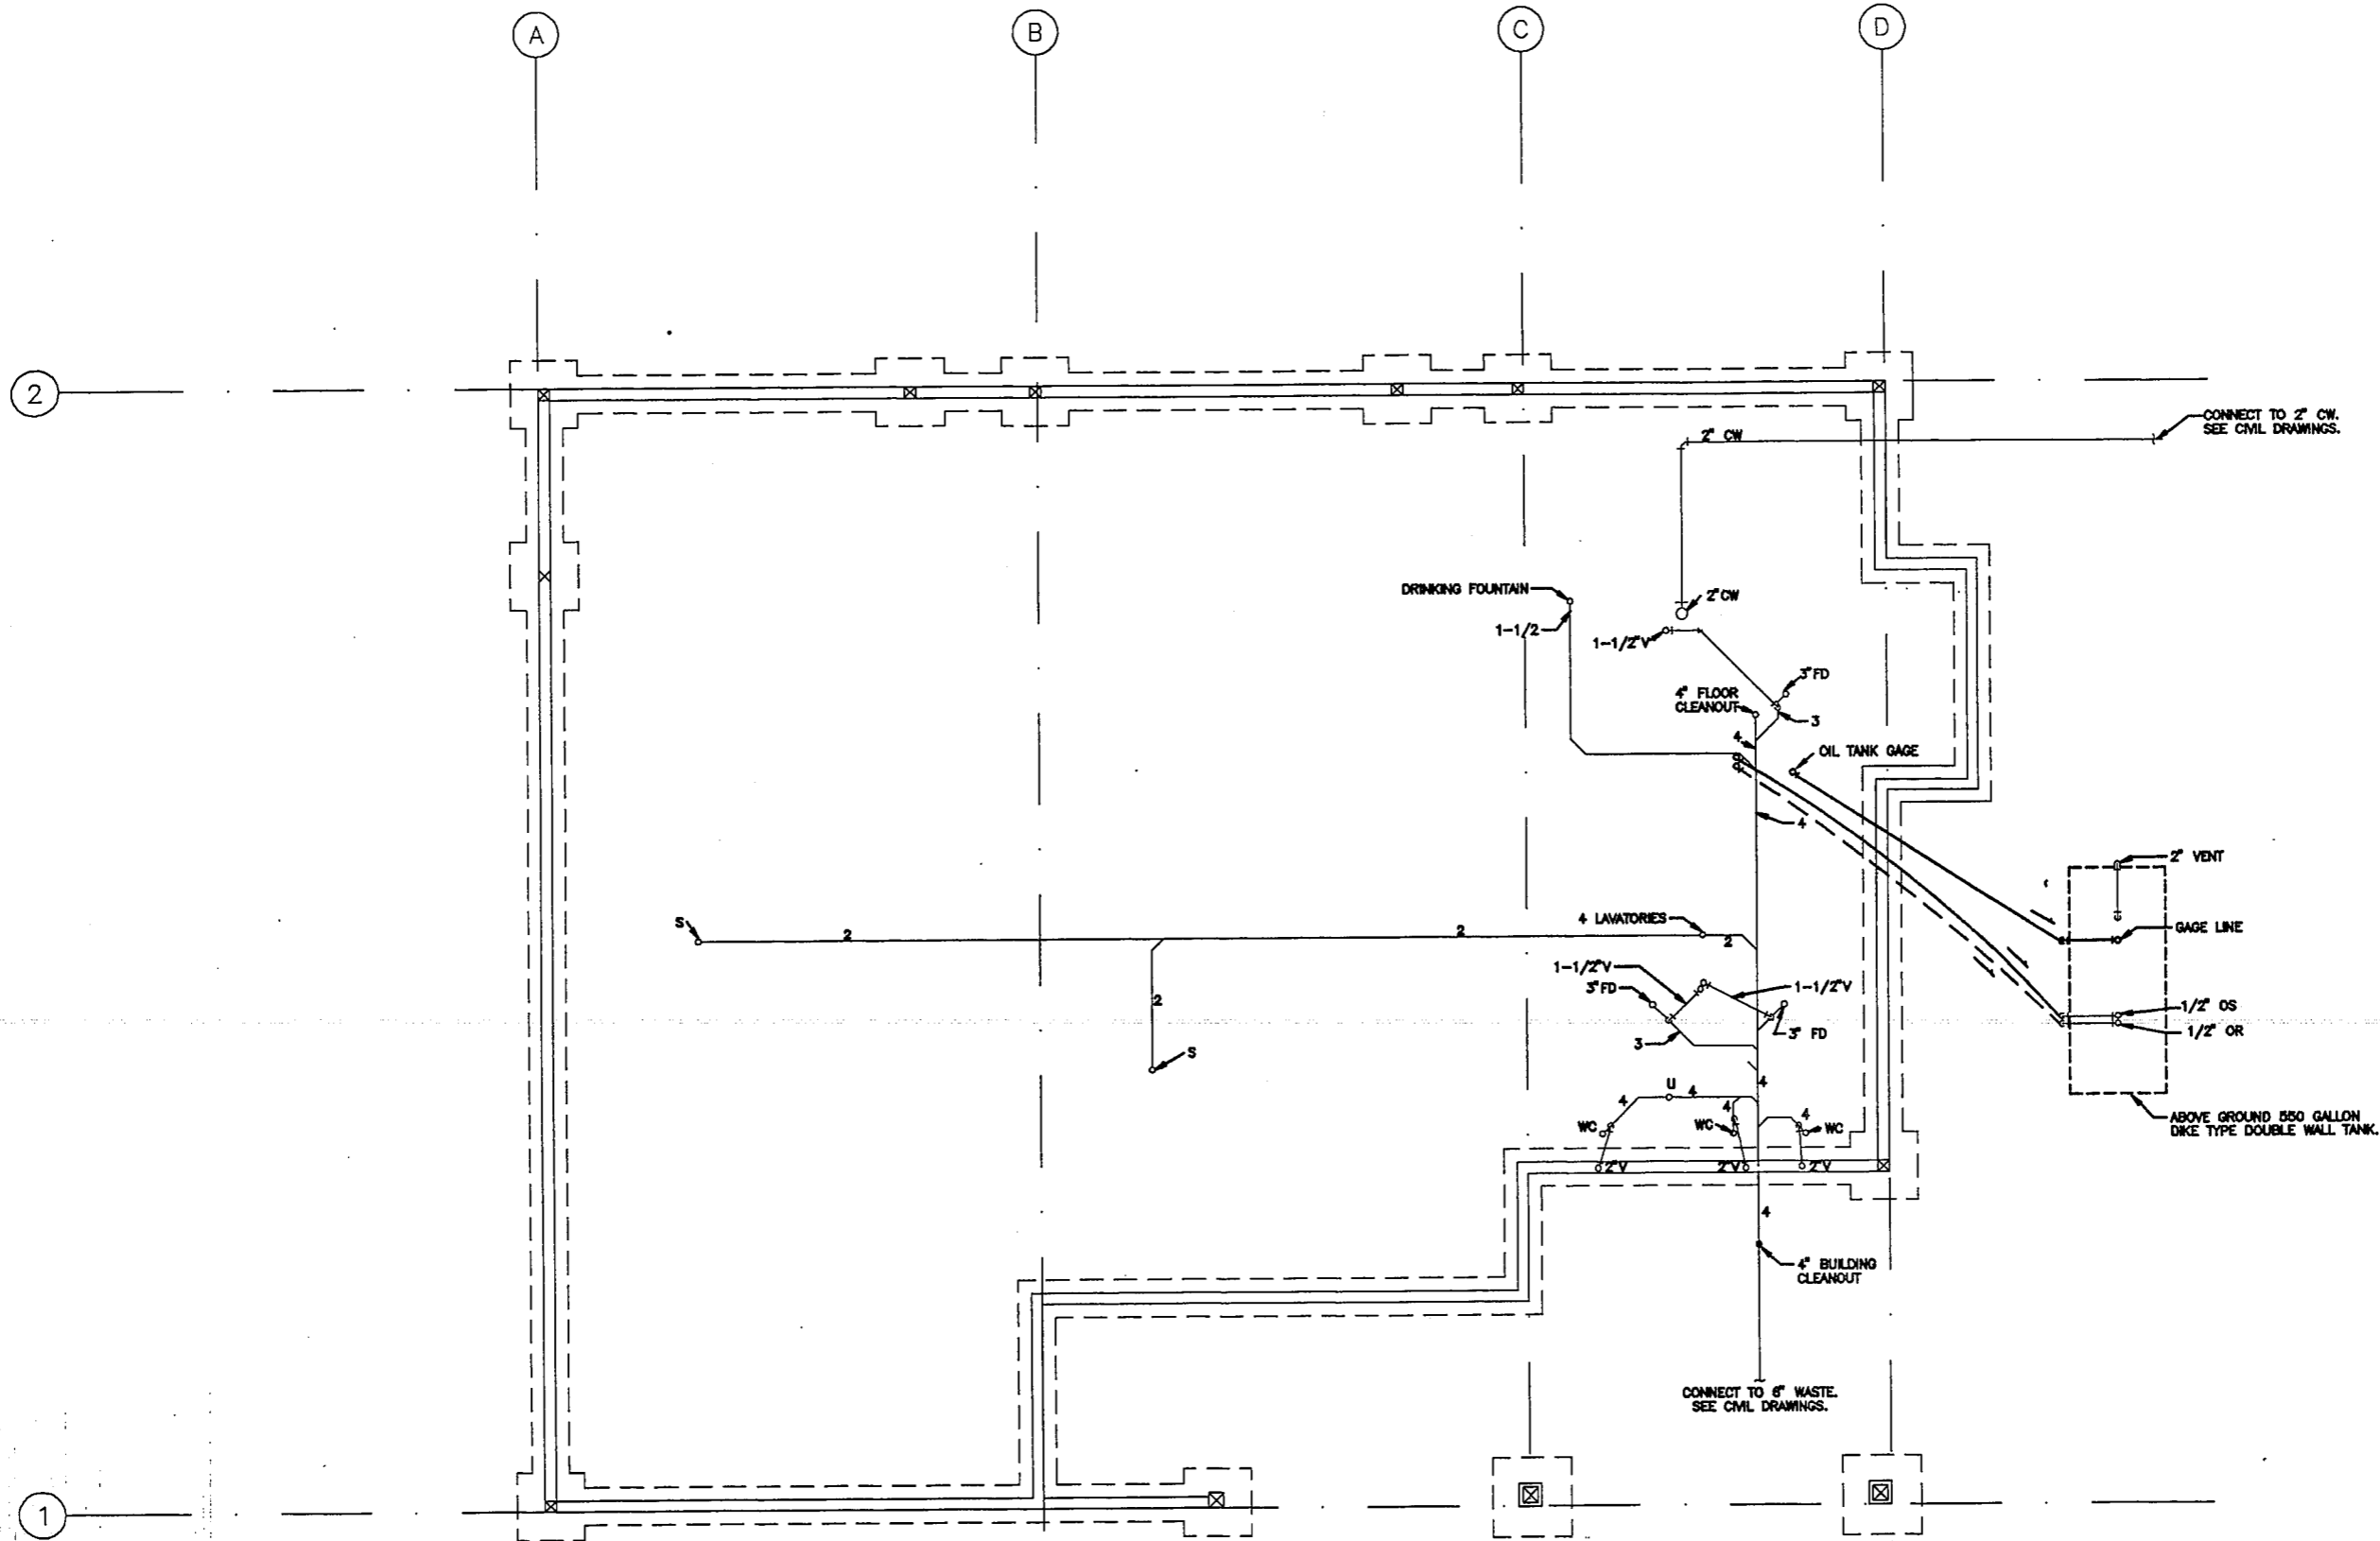

FOUNDATION PLAN

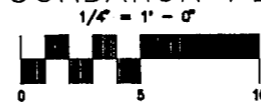

DRAWING M2

NOTE:

DO NOT SCALE FROM THESE PLANS - USE DIMENSIONS

ENGINEER'S SEAL

AKIN-MURRAY AND ASSOCIATES
CONSULTING ENGINEERS

P. O. BOX 21081
JUNEAU, ALASKA 99802

TEL: 907 586-8822
FAX: 907 586-8084



PATH:		DESCRIPTION OF CHANGE:
BY:	DATE:	
RECORD OF REVISIONS		

STATE OF ALASKA
DEPARTMENT OF TRANSPORTATION
AND PUBLIC FACILITIES
SOUTHEAST REGION DESIGN & CONSTRUCTION

CRAIG

CRAIG SEAPLANE BASE EXPANSION

AIP # 3-02-0071-01

FOUNDATION PLAN

ALASKA

DESIGNED BY: SH

DRAWN BY: SH

CHECKED BY: DM

PROJECT NO. 10-76

DATE: 8/94

SHEET 52 OF 60

