



TOTAL AREA OF CEMETARY BOUNDARY
217,776.81 SQUARE FEET
5.0 ACRES

- LEGEND**
- PRIMARY CONTROL MONUMENT RECOVERED (BRASS CAP)
 - PRIMARY CONTROL MONUMENT OF RECORD
 - PRIMARY CONTROL MONUMENT (SET)
 - (R) RECORDED DATA
 - (C) COMPUTED DATA
 - (M) MEASURED DATA
 - EXISTING TREE

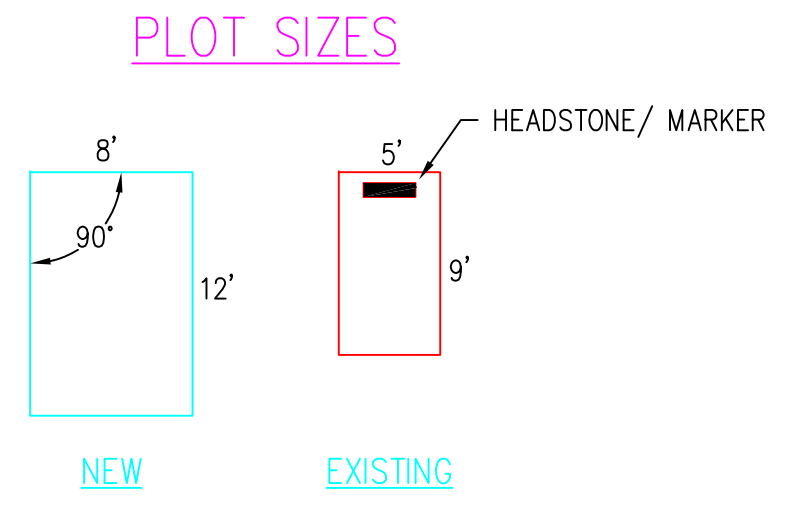


- PLAT NOTES**
1. FUTURE EXPANSION OF THE CRAIG MEMORIAL CEMETERY TO THE SOUTH WOULD YIELD APPROX. 325 ADDITIONAL PLOTS. HOWEVER THIS NUMBER IS DEPENDANT UPON THE GRADES ESTABLISHED AT THAT TIME.
 2. a. REFERENCE BLM PLAT NO. 95-57 KETCHIKAN RECORDING DISTRICT.
b. EARL FOSSE TOPOGRAPHY SURVEY DATED 3-25-82.

TYPICAL PRIMARY CONTROL MONUMENT SET

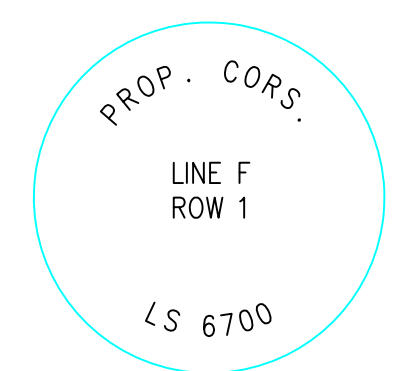

5/8"x24" REBAR AND 1 1/2" ALUMINUM CAP

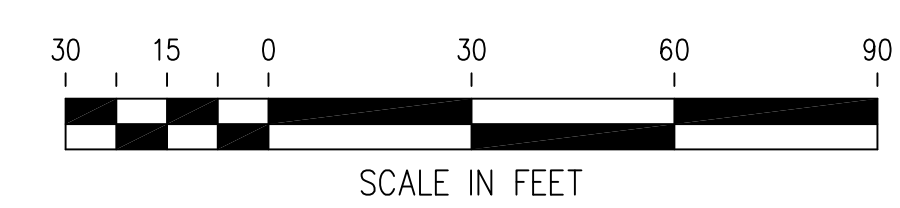

PORT BAGIAL

GREG SCHEFF & ASSOCIATES
LAND SURVEYORS & ENGINEERS

BOX 1849 SITKA, ALASKA 99835
(907) 747-6700


BOX 1331 WRANGELL, ALASKA 99929
(907) 874-2177

PROJECT: *CRAIG MEMORIAL CEMETERY*
ADDITION NO. 1

TOPOGRAPHY / ASBUILT SURVEY

ADDITION NO. 1 CREATING BLOCKS A THRU F

CLIENT: CITY OF CRAIG, BOX 725, CRAIG, ALASKA 99921

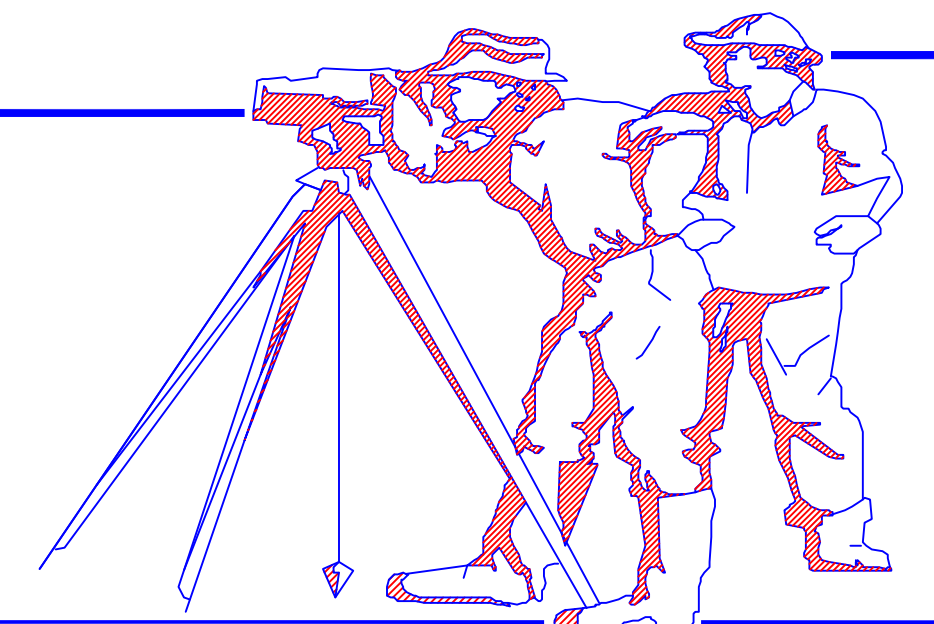

SHT01 OCT 04, 1995 * 15:08:06

SURVEYOR'S CERTIFICATE

I HEREBY CERTIFY THAT I AM A REGISTERED SURVEYOR, LICENSED IN THE STATE OF ALASKA, AND THAT IN _____ A SURVEY OF THE HEREIN DESCRIBED LANDS WAS CONDUCTED UNDER MY DIRECT SUPERVISION AND THAT THIS PLAT IS A TRUE AND ACCURATE REPRESENTATION OF THE FIELD NOTES OF SAID SURVEY, AND THAT ALL DIMENSIONS AND OTHER DETAILS ARE CORRECT ACCORDING TO SAID FIELD NOTES.

DATE

GREGORY G SCHEFF LS 6700

DESIGNED: N/A
DRAWN: GDS/ACAD
CHECKED: GREGORY G SCHEFF
DATE OF SURVEY: 9-27-95
DATE OF PLAT: 10-4-95
SCALE: 1"=30'
SURVEYOR: GREGORY G SCHEFF

PROJECT NO. 51244-17-00

SHEET 1 OF 2